


ARDROSSAN No 397

FABRICATED RUDDER

SCALE 1"=1 FOOT

See later arrangement  
of coupling

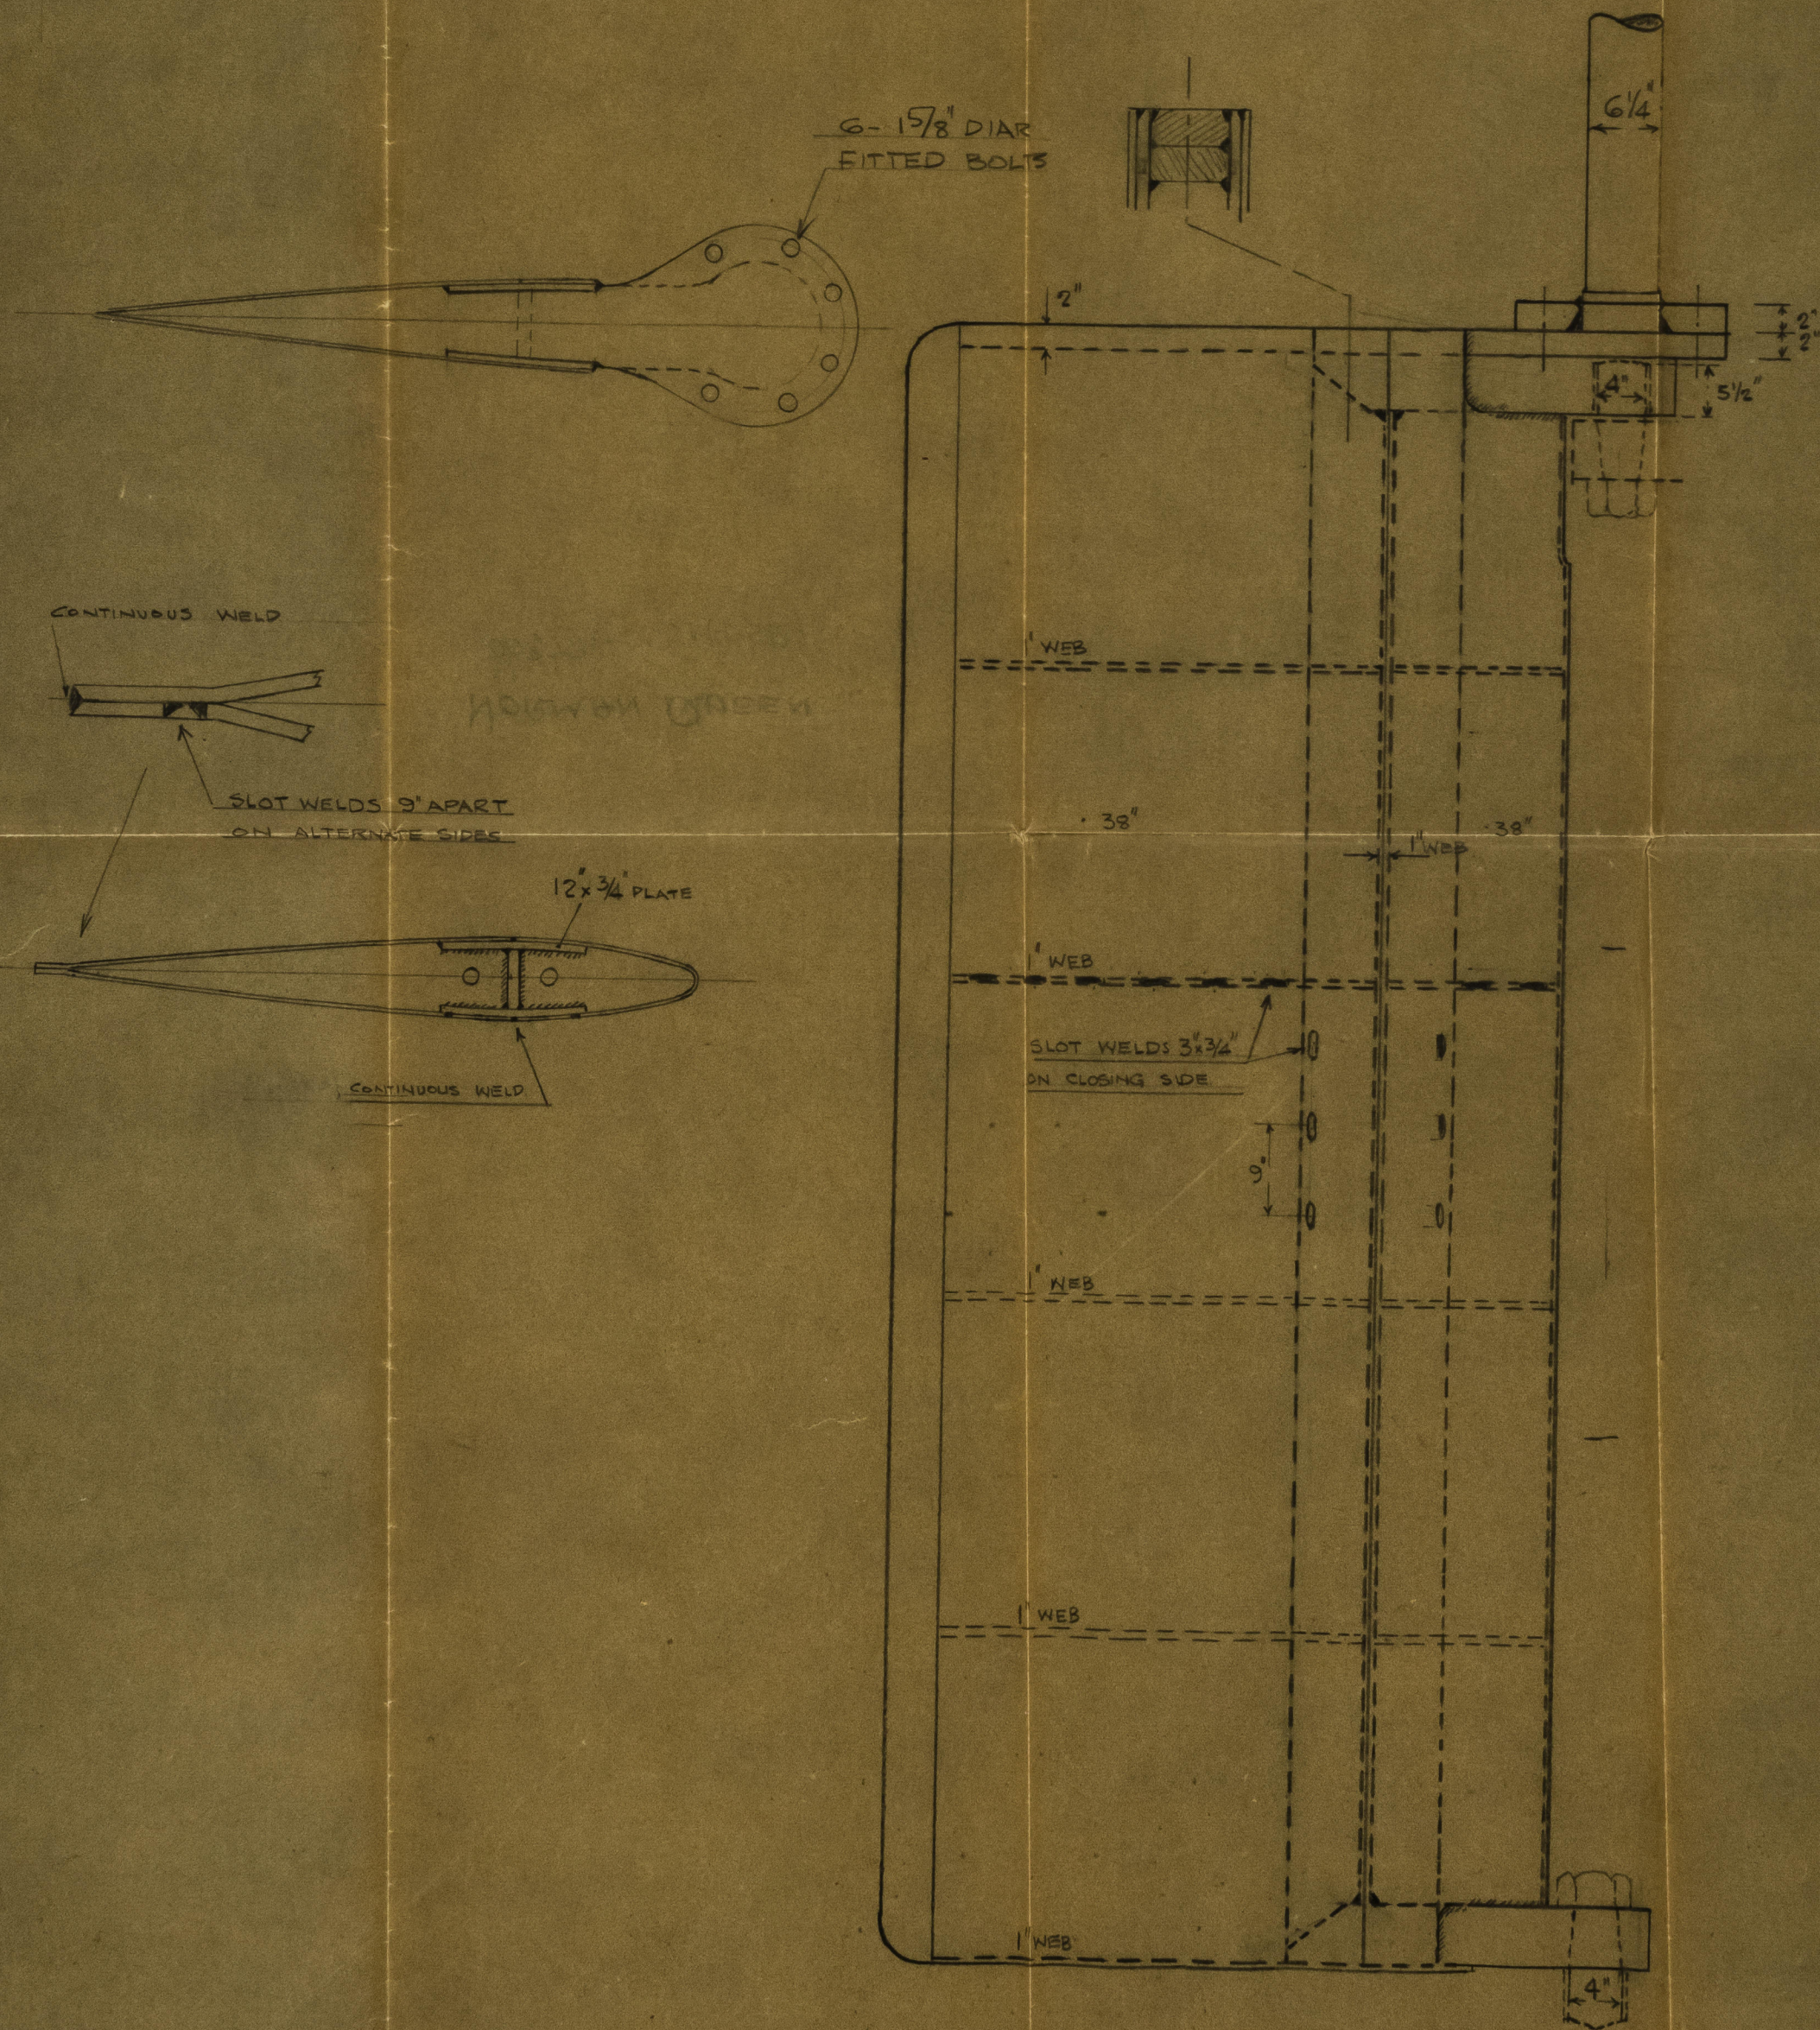




1844 E

NORMAN QUEEN

003788-005749-0129

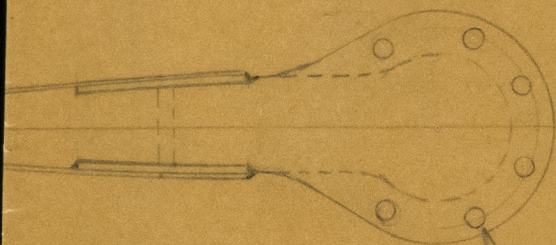

FILLED BOT.

2-12/8 DIA

TL

D BUDDER

2411 110 327



© 2020

Lloyd's Register  
Foundation