

"TEMPLE PIER." MIDSHIP SECTION

S.S. NOS 403

SCALE 1/2" = ONE FT.



EQUIPMENT No

25' Longt No L (B.D.)	=	34158.67
Forecastle 29.5 x 7.25 x 1/4	=	180.41
Storehouses 39.0 x 7.5 x 1/4	=	186.25
Casing 31.0 x 7.75 x 1/2	=	120.12
Saloon House 28.0 x 7.5 x 1/2	=	86.25
Total	=	34681.60

EQUIPMENT

2 BOWER AVENUES 80' CMT. STRENGTH	CHL. WT.
1 ANCHOR 504	1705 CMT.
1 STREAM 164	Fr. Stock
270 FATHOMS 2 1/2 CHAIN CABLE	
90 4 1/2 STEEL WIRE	
120 4 1/2	TOWLINE
2-90 2 1/2	Stream Wire
1-90 2 1/2	Wire
1-90 HANSE 7	Manila


SOLE SHE PLATING 40"
KLE STE 34" x 34" OR 34" AUTHENTICATED
ANGLE 2 1/2" x 3 1/2" x 34"
BUTTS LAPPED 1 R

DIMENSIONS

390'-0" B.P. x 52'-9" MLD x 35'-2 1/2" TO UPD DX TO CLASS 100 A.I. WITH FREEBOARD
CORRESPONDING TO THAT OF A COMPLETE SUPERSTRUCTURE VESSEL WITH TONNAGE OPENING.

1 ST NUMBER L x D = 388.5 x 35.2 = 13675.4	D	35.2
2 ND L x (B.D.) = 388.5 x (52.75 / 35.2) = 34168.57	LESS THIN DX	8.0
D	35.20	27.2
L/D TO UPPER DX = 388.5 / 35.2 = 11.03	LESS C. GROSS	3.5
	1/2 B.K. EXCESS	23.7
	d	23.325

LLOYD'S SURVEY.

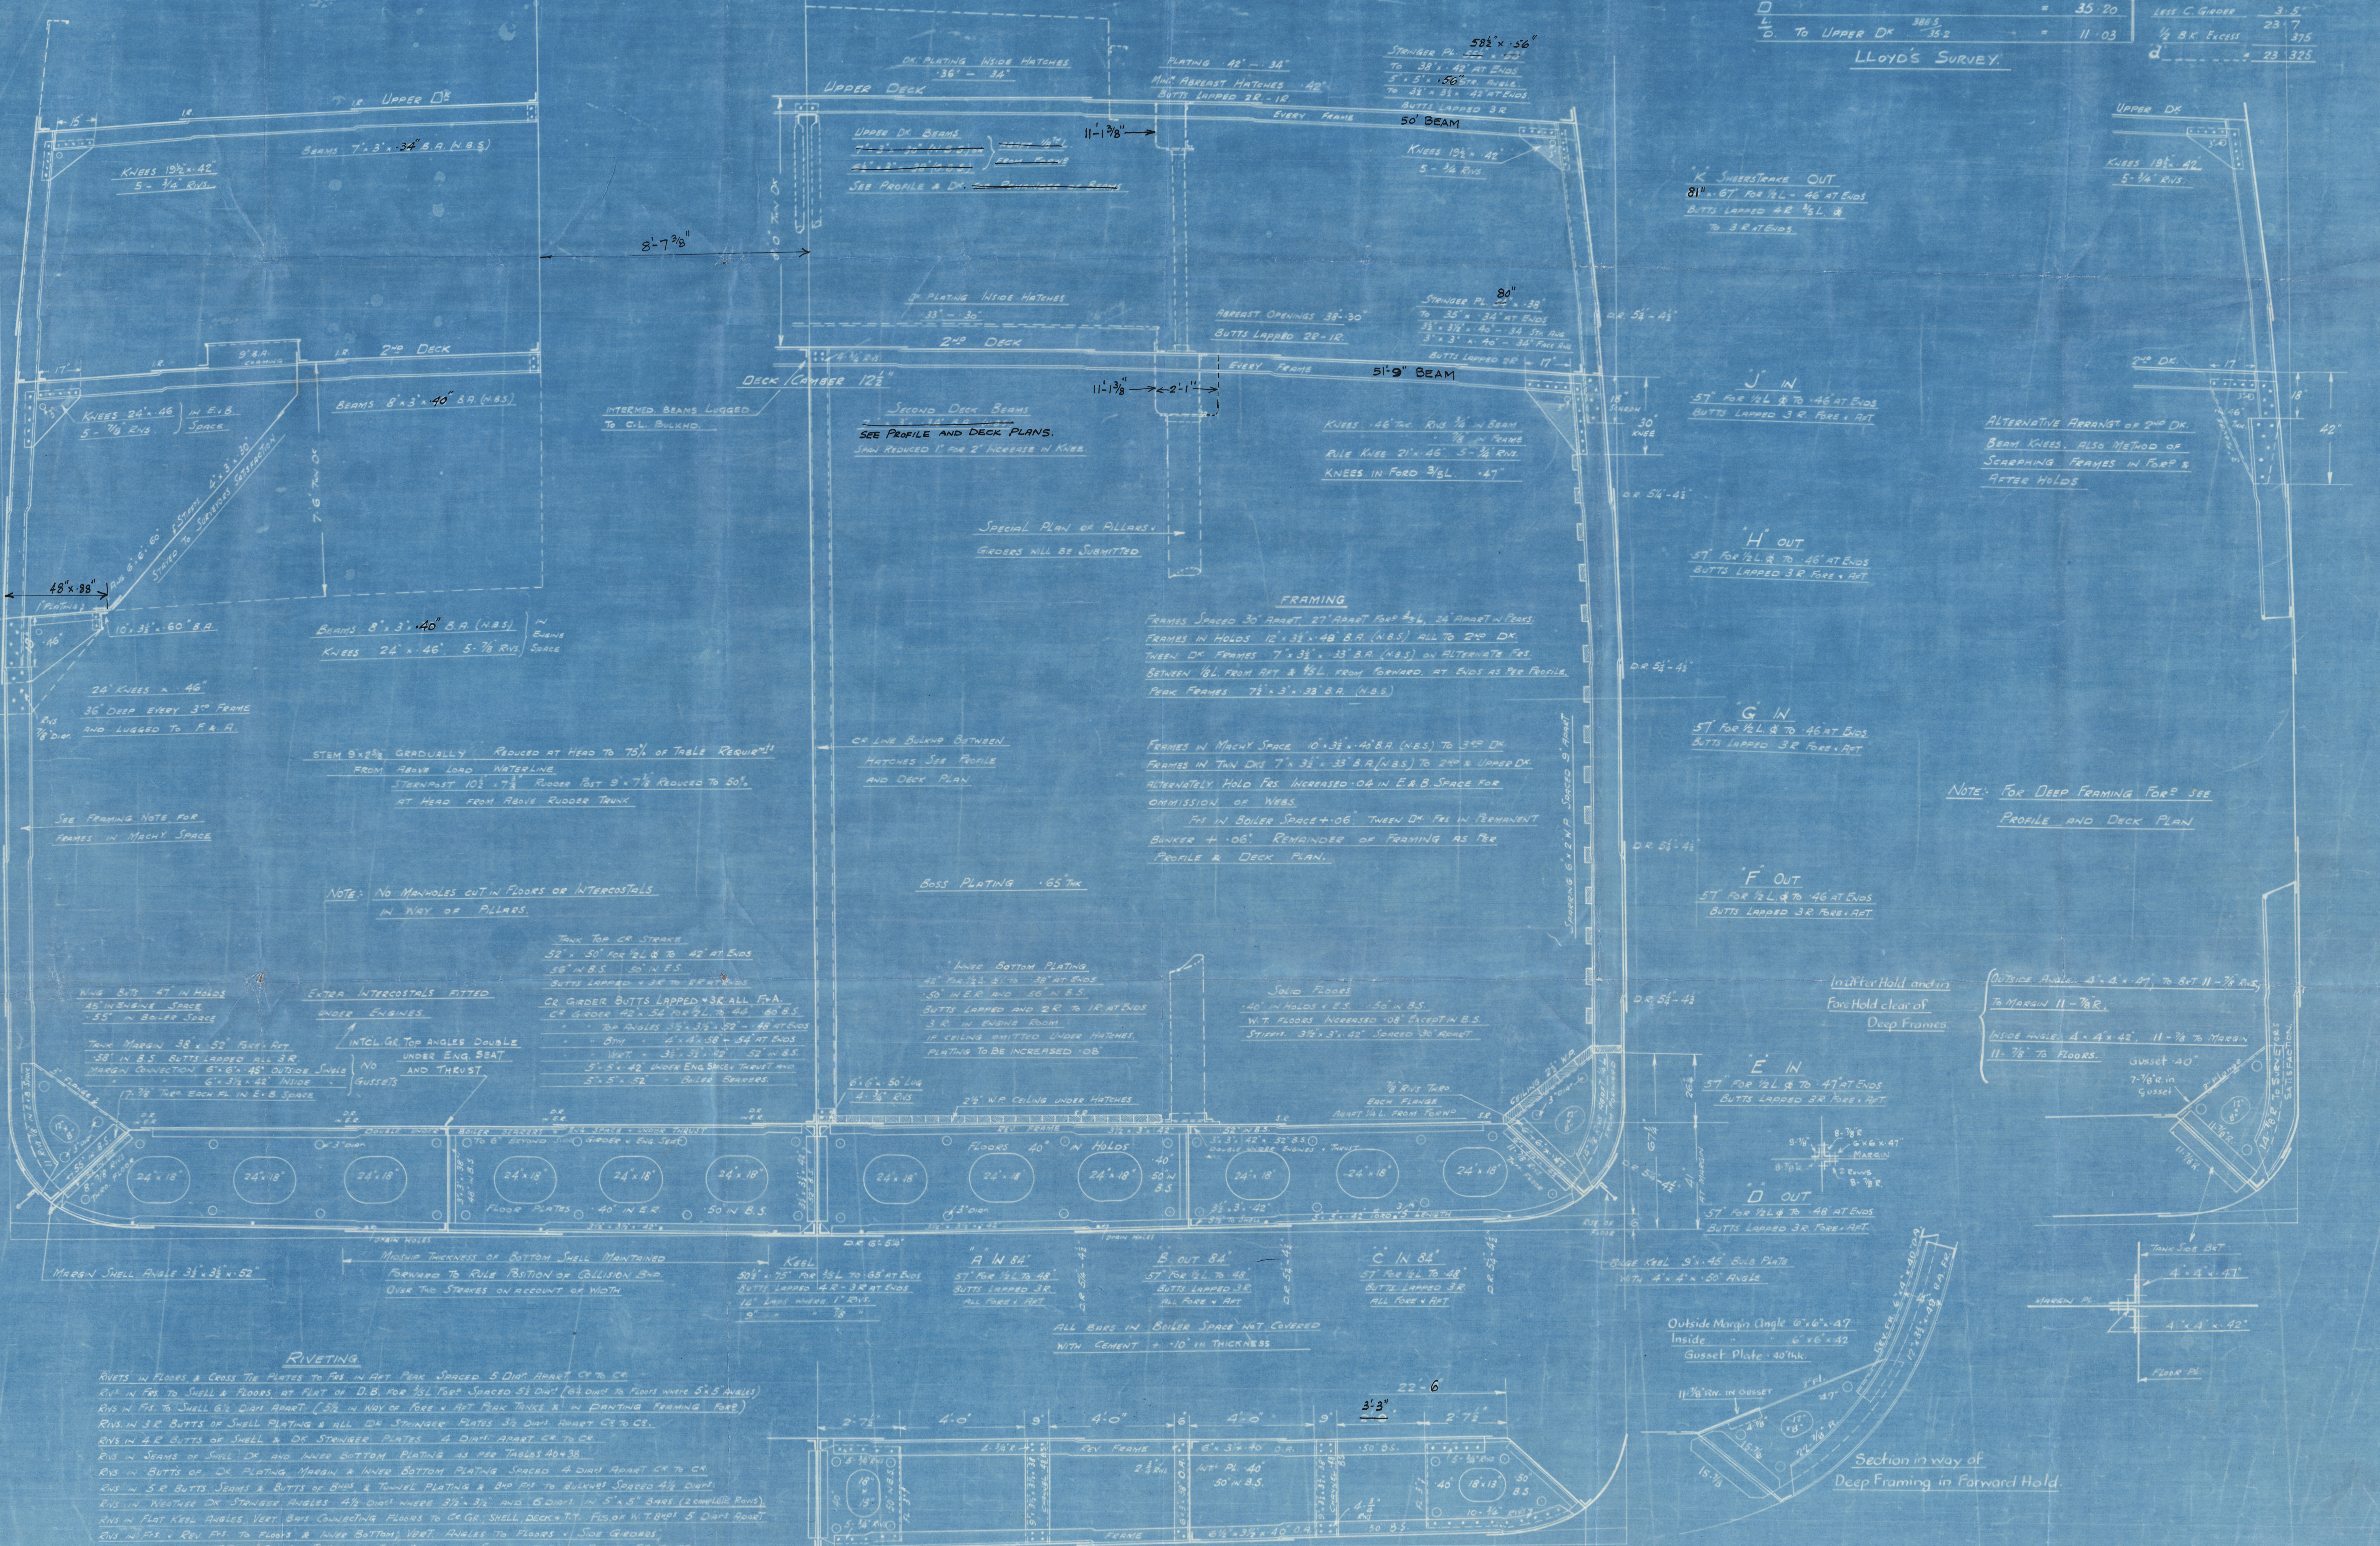

DETAIL OF BRACKET FLOOR

SOLID FLOORS ON EVERY FR. IN ENGINE SPACE & FORWARD 3/4" LONGT.
UNDER BOWEL BRIGGERS & UNDER OPD. PART SOLID UNDER THRUST
EVERY 30" FRAME SOLID ELSEWHERE, BRACKET FLOORS INTERMEDIATE

003808-003815-0060


Midship Section (as built)

WM HAMILTON & Co's N^o 403.

S.S. TEMPLE PIER

GREENOCK 1ST ENTRY REPORT N^o 18925.

Ryuko Maru

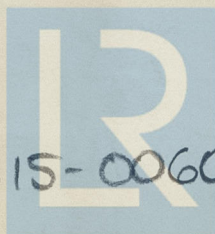

© 2020

003808 - 003815 - 0060

Lloyd's Register
Foundation