

29/10/24

NOS 1204-6

PROFILE & DECK PLANS.

DIMENSIONS:- 210'-0" (LLOYDS LENGTH 201'-5" x 33'-6" x 16'-0" D.M.L. TO UPPER DECK.

CLASS 100A.I. LLOYDS WITH FREEBOARD FOR CHANNEL SERVICE. *Weymouth & Channel Islands*


SCALE 1/8" = 1 FOOT.

Plan Showing Construction in Way of Gangway, Doors to be Submitted


*Photo, Windows, Windows etc
Supplies to Suez Canal*

*Plan Showing Cross Section
After peak and based on
to be Submitted*

*Plan of fore peak bulkhead
to be Submitted*

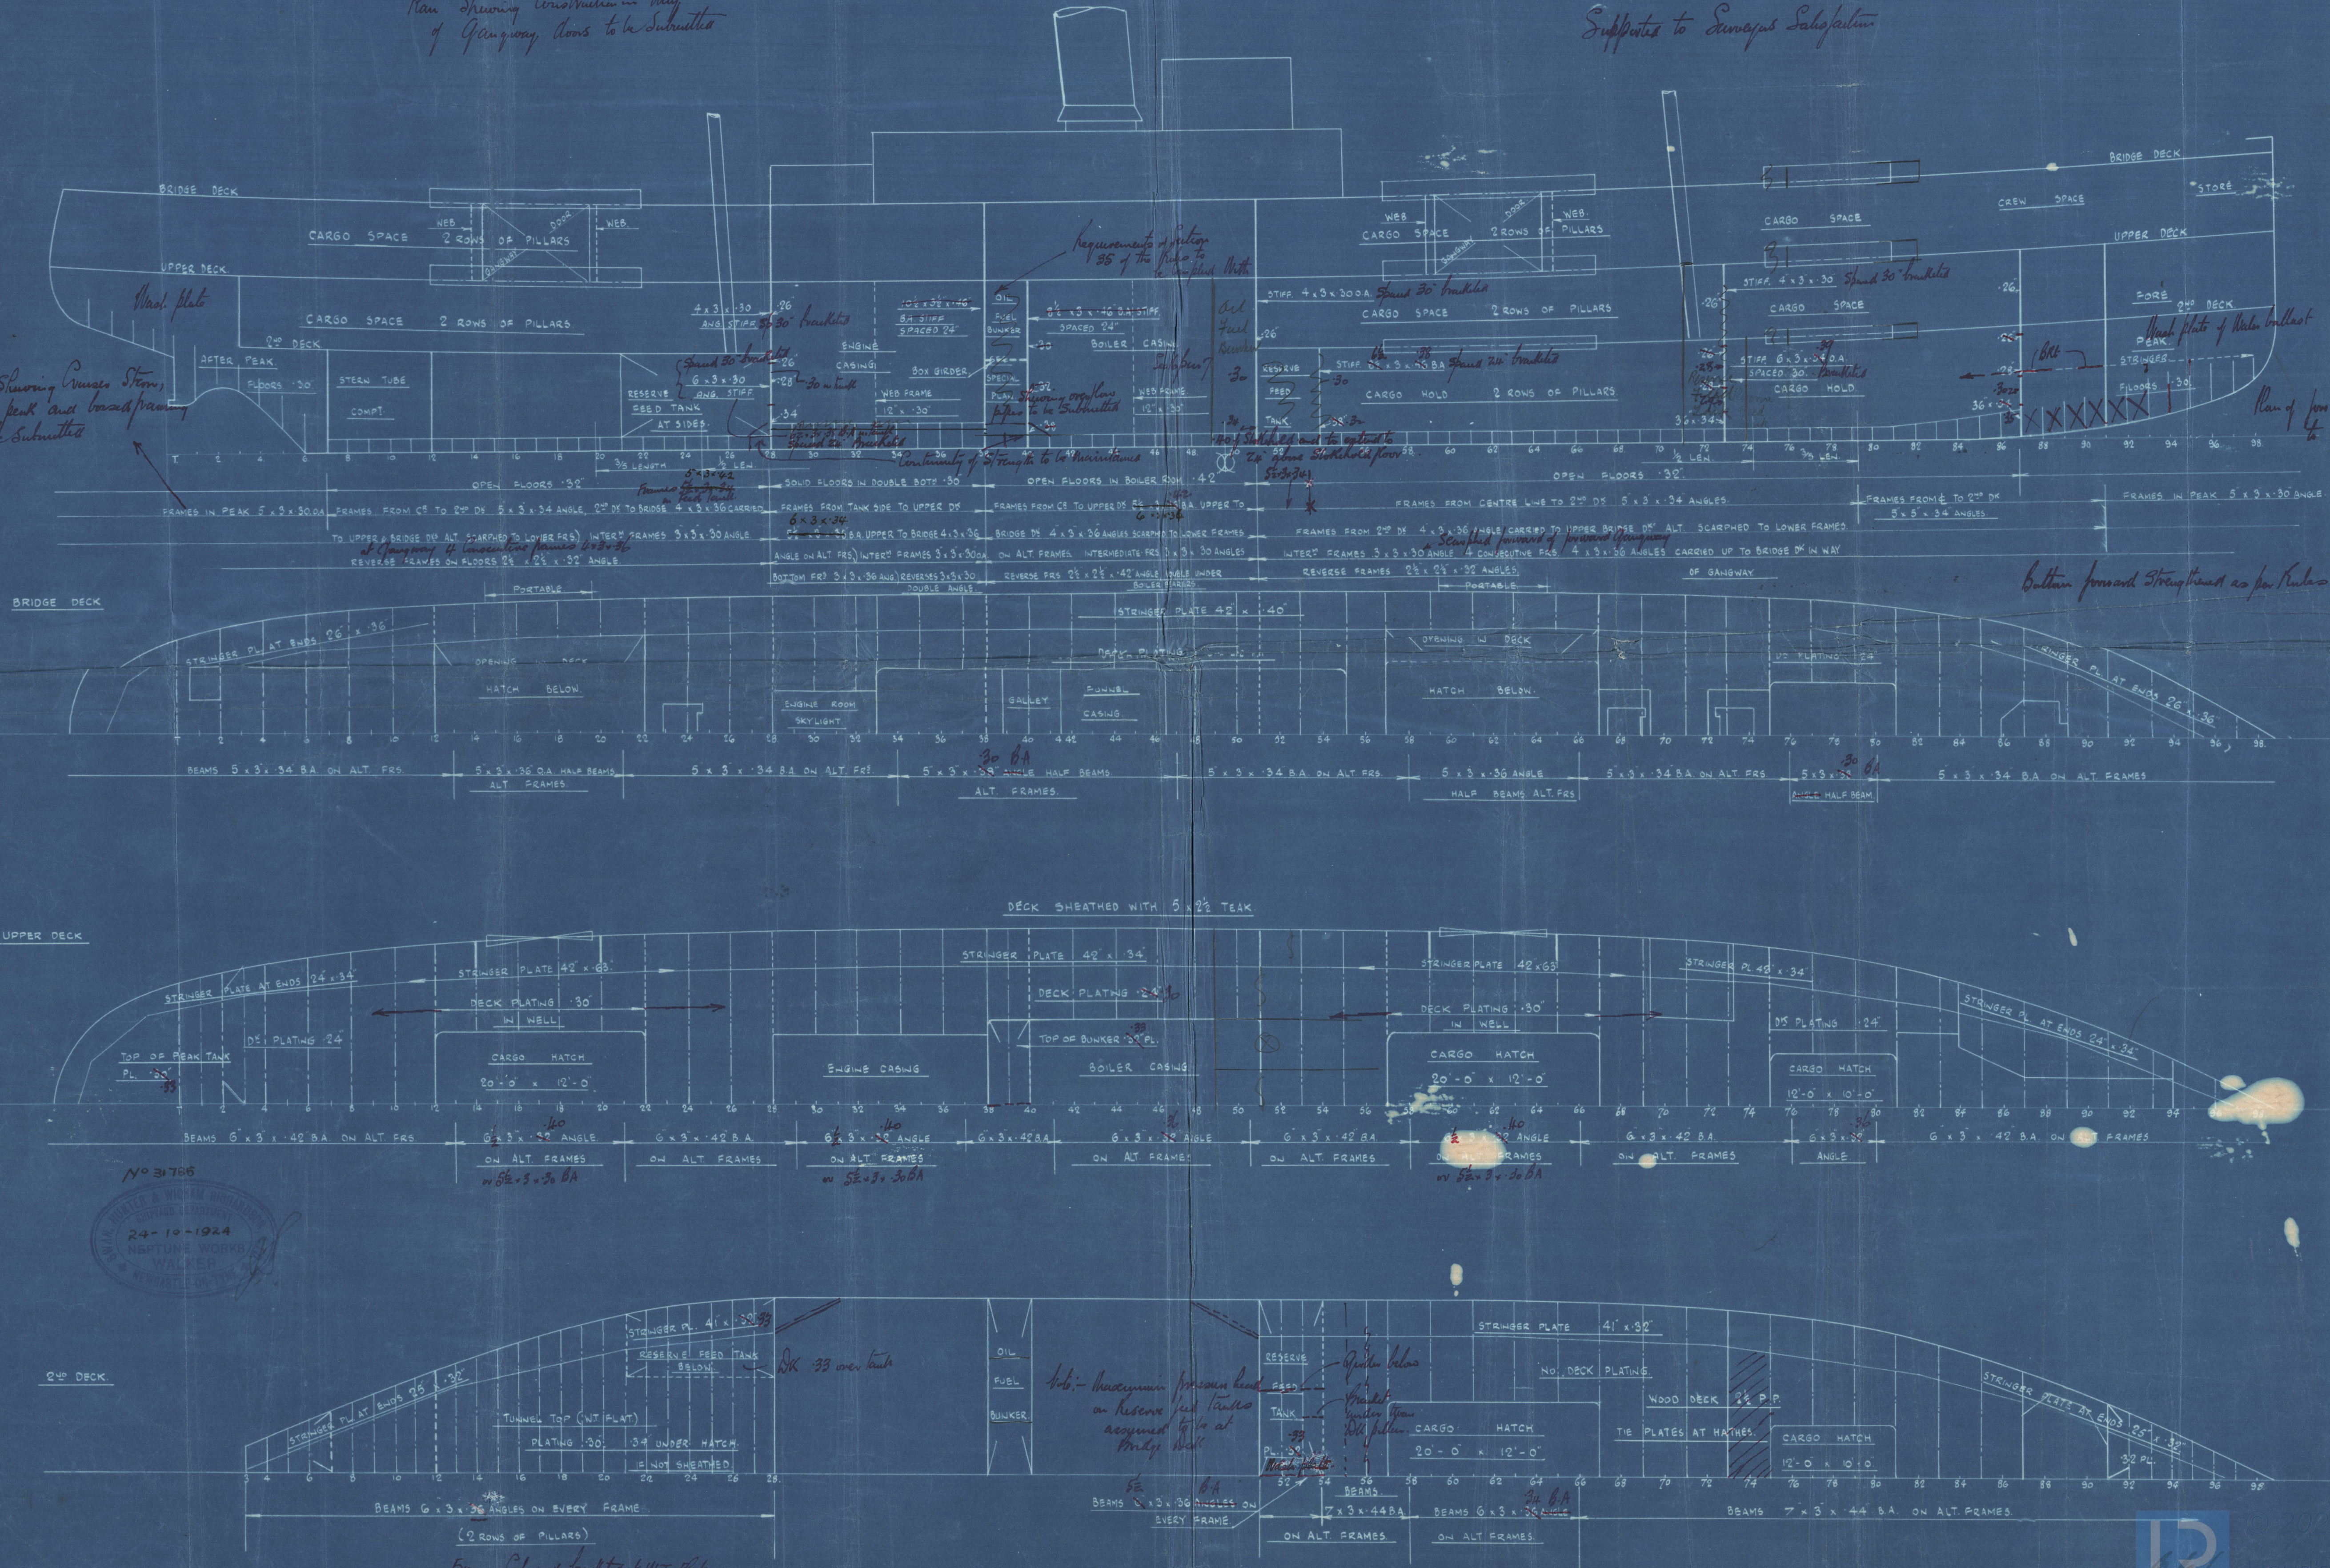

Bottom forward strengthened as per Rules

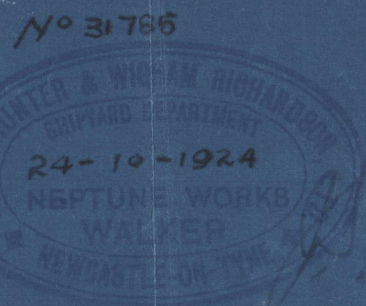

00328-003815-0231

Messrs Swan Hunter & Wigham Richardson Ltd.

No. 1204 + 1206

Plan of Profile + Deck

No. 1

Roebuck

Leconia

1192 1030

Cartier 876.

806

Feb. 1880

003808 - 003815 - 0231



© 2020

Lloyd's Register
Foundation

Swan & Hunter.

No 1204 & 1206.

Profile & Decks.

No 1

S. S. Roebuck.
NEWCASTLE ON TYNE.

Report No. 79153.

S. S. SANIBUR
NEWCASTLE ON TYNE.

Report No. 79194.

RETAIN

003808-003815-0231



© 2020

Lloyd's Register
Foundation