

# Twin Screw Motor Vessel No 413.


## Midship Section

Dimensions 142'-0" B.P. x 26'-6" x 11'-6" Mld.

Scale 1/2" = 1 Foot.

To Class. "B S" with Freeboard.


8 APR 1923

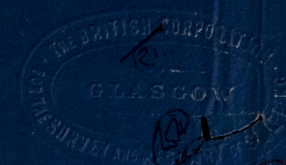

Approved  
See Index


18'-0" x 142' = 2670

52' x 34' = 1768

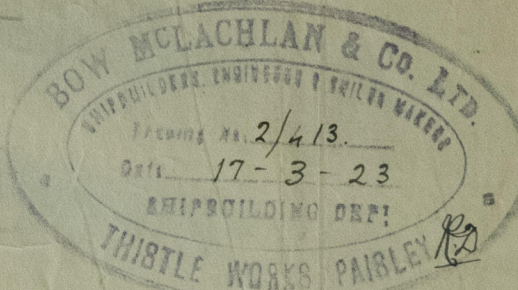

### Equipment.

- 2 Bower Anchors, each 10 1/2 cwt. Stockless.
- 1 Bower Anchor 8 1/4 cwt. Stockless.
- 1 Stream Anchor 3 1/2 cwt. Ex. Stock
- 1 Kedge Anchor 1 1/2 cwt. Ex. Stock.
- 165 Fathoms 1 1/2" Stud Link Cable.
- 60 Fathoms 2 1/2" Steel Wire Rope.
- 1/2 Fathoms 4 1/2" Hemp or 3 1/2" Steel Wire Rowline.
- 1 c 90 Fathoms 5 1/2" Hemp or 3" Steel Wire Rowline.

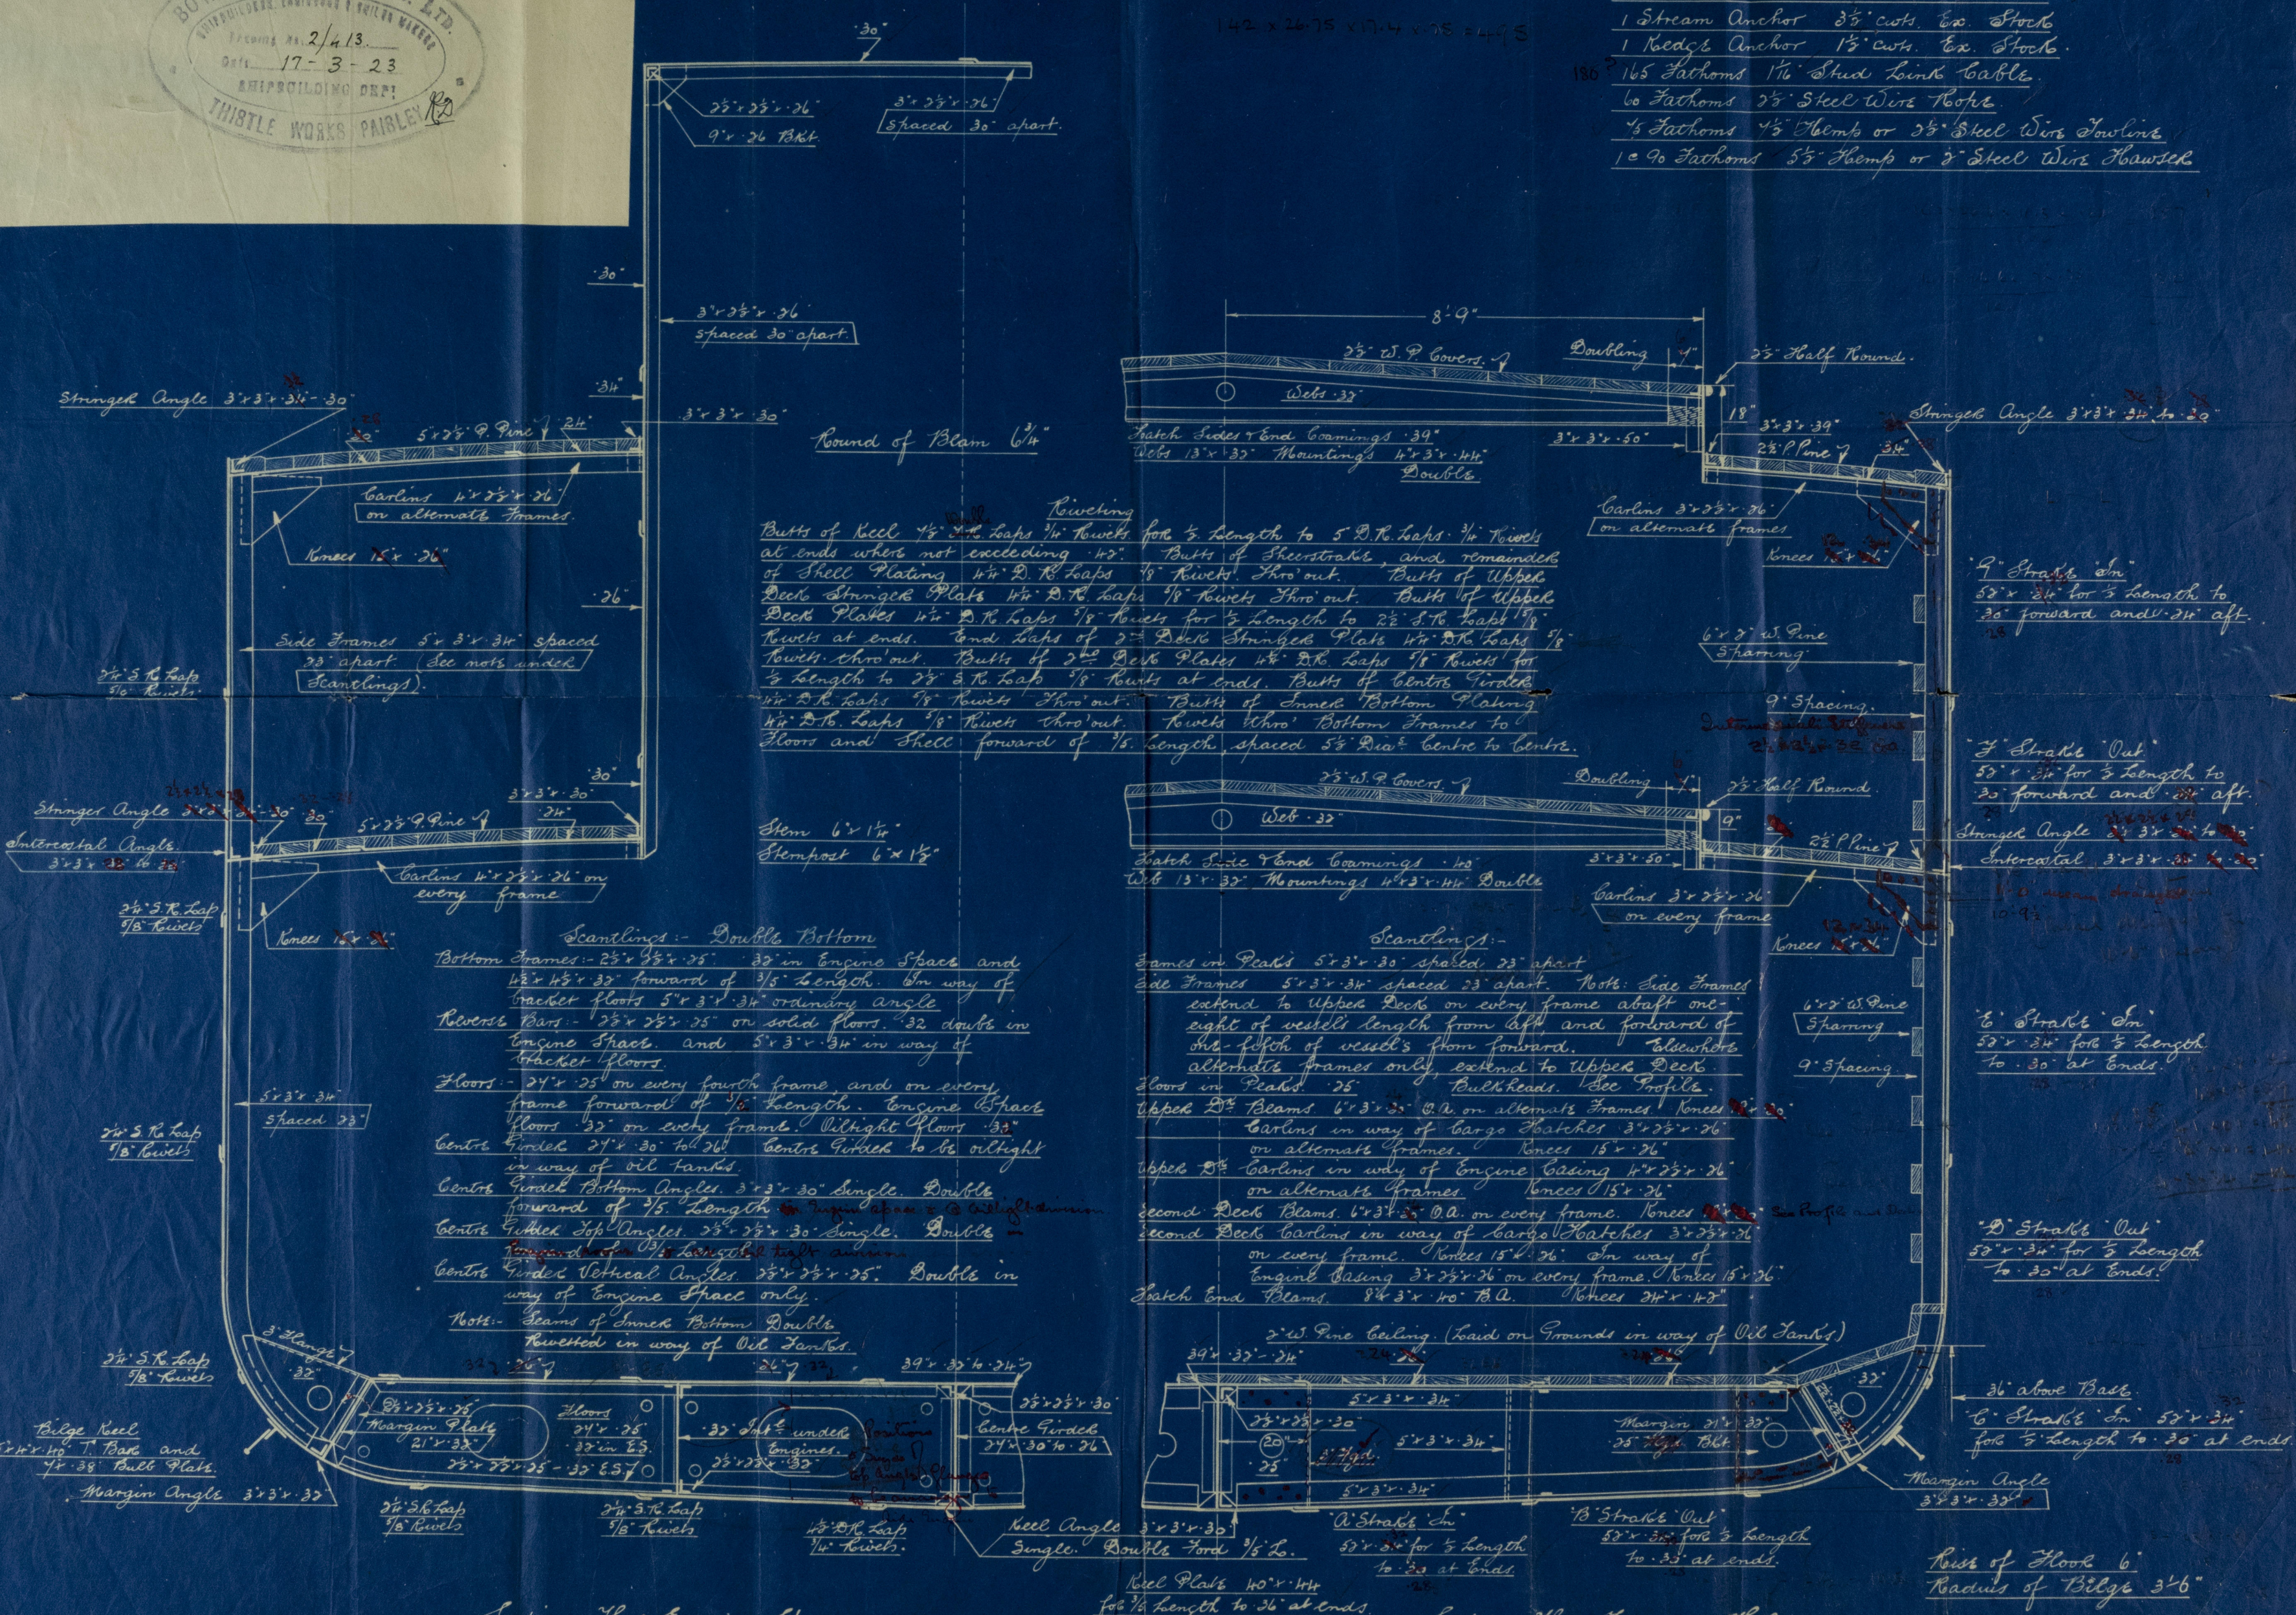



1

Midship Section.

How Mc Lachlan & Co. No. 412.

T.C. 23 - 5 - 23.

5 - 4 - 22.

"HALAL" now "CECILE MAPLESON"



© 2020

Lloyd's Register  
Foundation

003816-003823-0028



Dow MacLachlan & Co L<sup>d</sup>  
Is - Motor No 413  
Mid Section  
142 x 26.6 x 11.6"

Tc 23.5.73

Bag

Dow MacLachlan & Co L<sup>d</sup>  
No 413

Midship Section  
142 x 26.8<sup>9</sup> x 11.83"

5.4.73

"HALAL" now "CECILE MAPLESON"

1

003816-003823-0028



© 2020

Lloyd's Register  
Foundation