
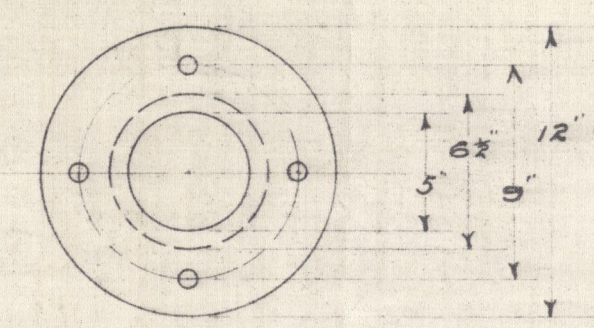
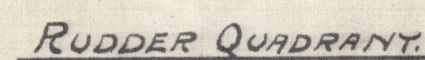
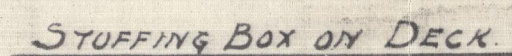


na

SCALE $\frac{1}{2}$ " = ONE FOOT.






STERN FRAME AND RUDDER FRAME TO BE OF BEST HAMMERED SCRAP IRON
GREAT CARE TO BE TAKEN IN BORING PINTLES TO HAVE THEIR CENTRES
PERFECTLY TRUE WITH CENTRE OF STOCK BOTH FORE AND AFT AND ACROSS.

Approved
Sec. action

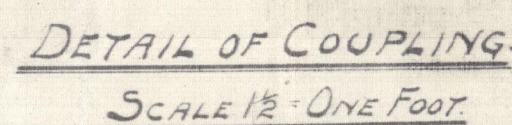

PLAN OF TOP.

DETAIL OF GLAND ON TOP OF RUDDER TRUNK

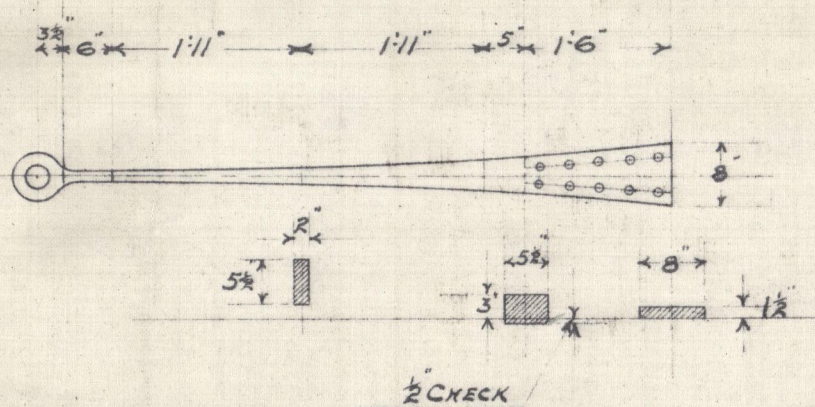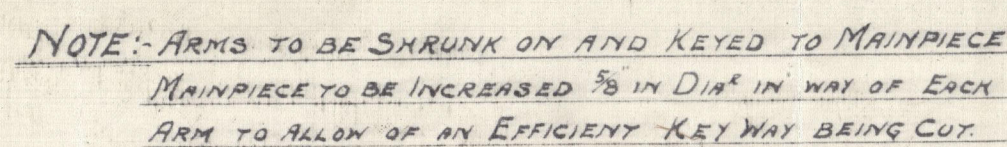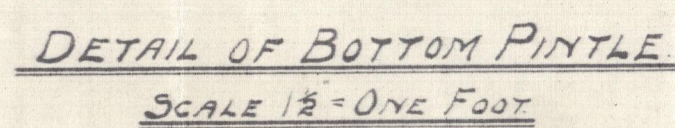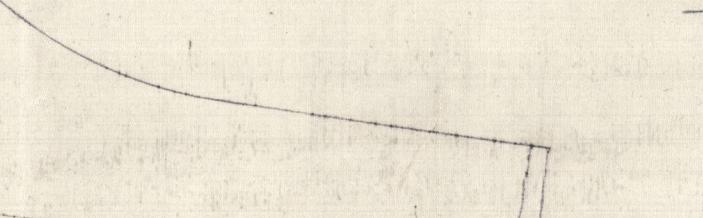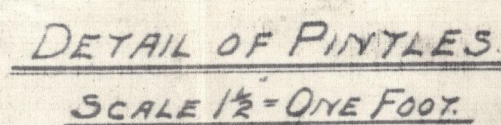

Bow M^c Lachlan

N^o 413

Sternpost + Rudder.

Bag.

I'd leave for return to H.O.

Bow M^c Lachlan + C^c L
413

Sternpost + Rudder
25. 4 23

HALAL Now "CECILE MAPLESON"

3

003816-003823-0030



© 2020

Lloyd's Register
Foundation

3

Sternpost & Rudder.

How Mc Lachlan & Co. N^o 112.

25-8-22.

"HALAL" Low "CECILE MARLESON"



© 2020

Lloyd's Register
Foundation 3

003816-003823-0030