



Dimensions: - 51'2" O.B.P. x 70'0" M.L.D. x 43'4 1/2" M.L.D. TO SHELTER DECK.  
SCALE 1/16" = 1'-0" DETAILS 1/4" = 1'-0"

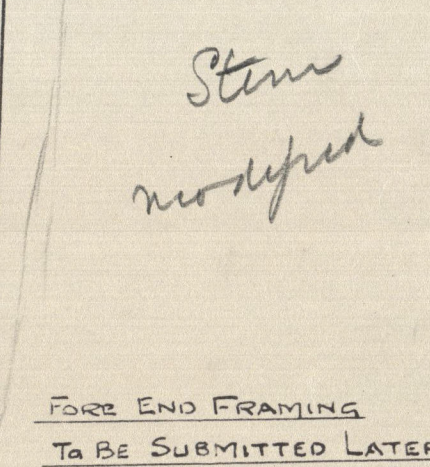



1050/1

Framing profile  
(Not signed)

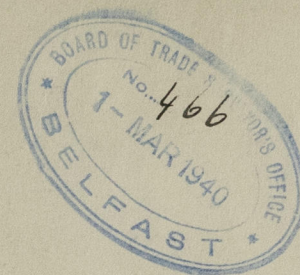

(2a)

HARLAND & WOLFF LTD.  
BELFAST

No. 1050-1

TITLE Framing profile

DATE APPROVED spec.

13091 - Empire Hope Bel 13091.

13212 - Empire Grace N/A

WARRANGI

RETAIN

003816-003823-0126



© 2020

Lloyd's Register  
Foundation