


N<sup>o</sup> 1050 & 1051.  
PROPOSED RUDDER.  
SCALE 1" = 1 FOOT.

BLACK INDICATES AS AT PRESENT IN 972-3  
Red INDICATES AS PROPOSED FOR 1050-1



SECTION THRO' MAIN PIECE.

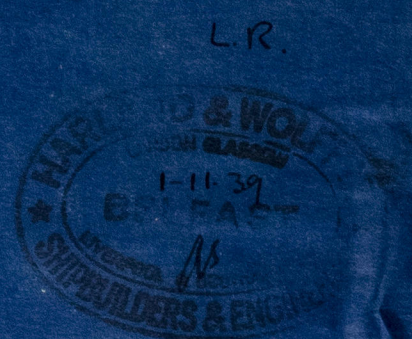



HARLAND & WOLFF LTD.  
BELFAST

No. S. 1050/1

TITLE Rudder

Section through amended cast main piece

DATE APPROVED 6. 11. 39

Belfast Report No. 13091

(8)

Empire Scope Bel 13091.

13212

Empire Space \*



© 2020

Lloyd's Register  
Foundation

003816-003823-0128