

STEEL SCREW STEAMER





Nº 313

314 + 309/310

SCALE 1/4" = ONE FOOT

194.5 x 31.0 x 14.0 MLD


TO CLASS LLOYDS 100 A1

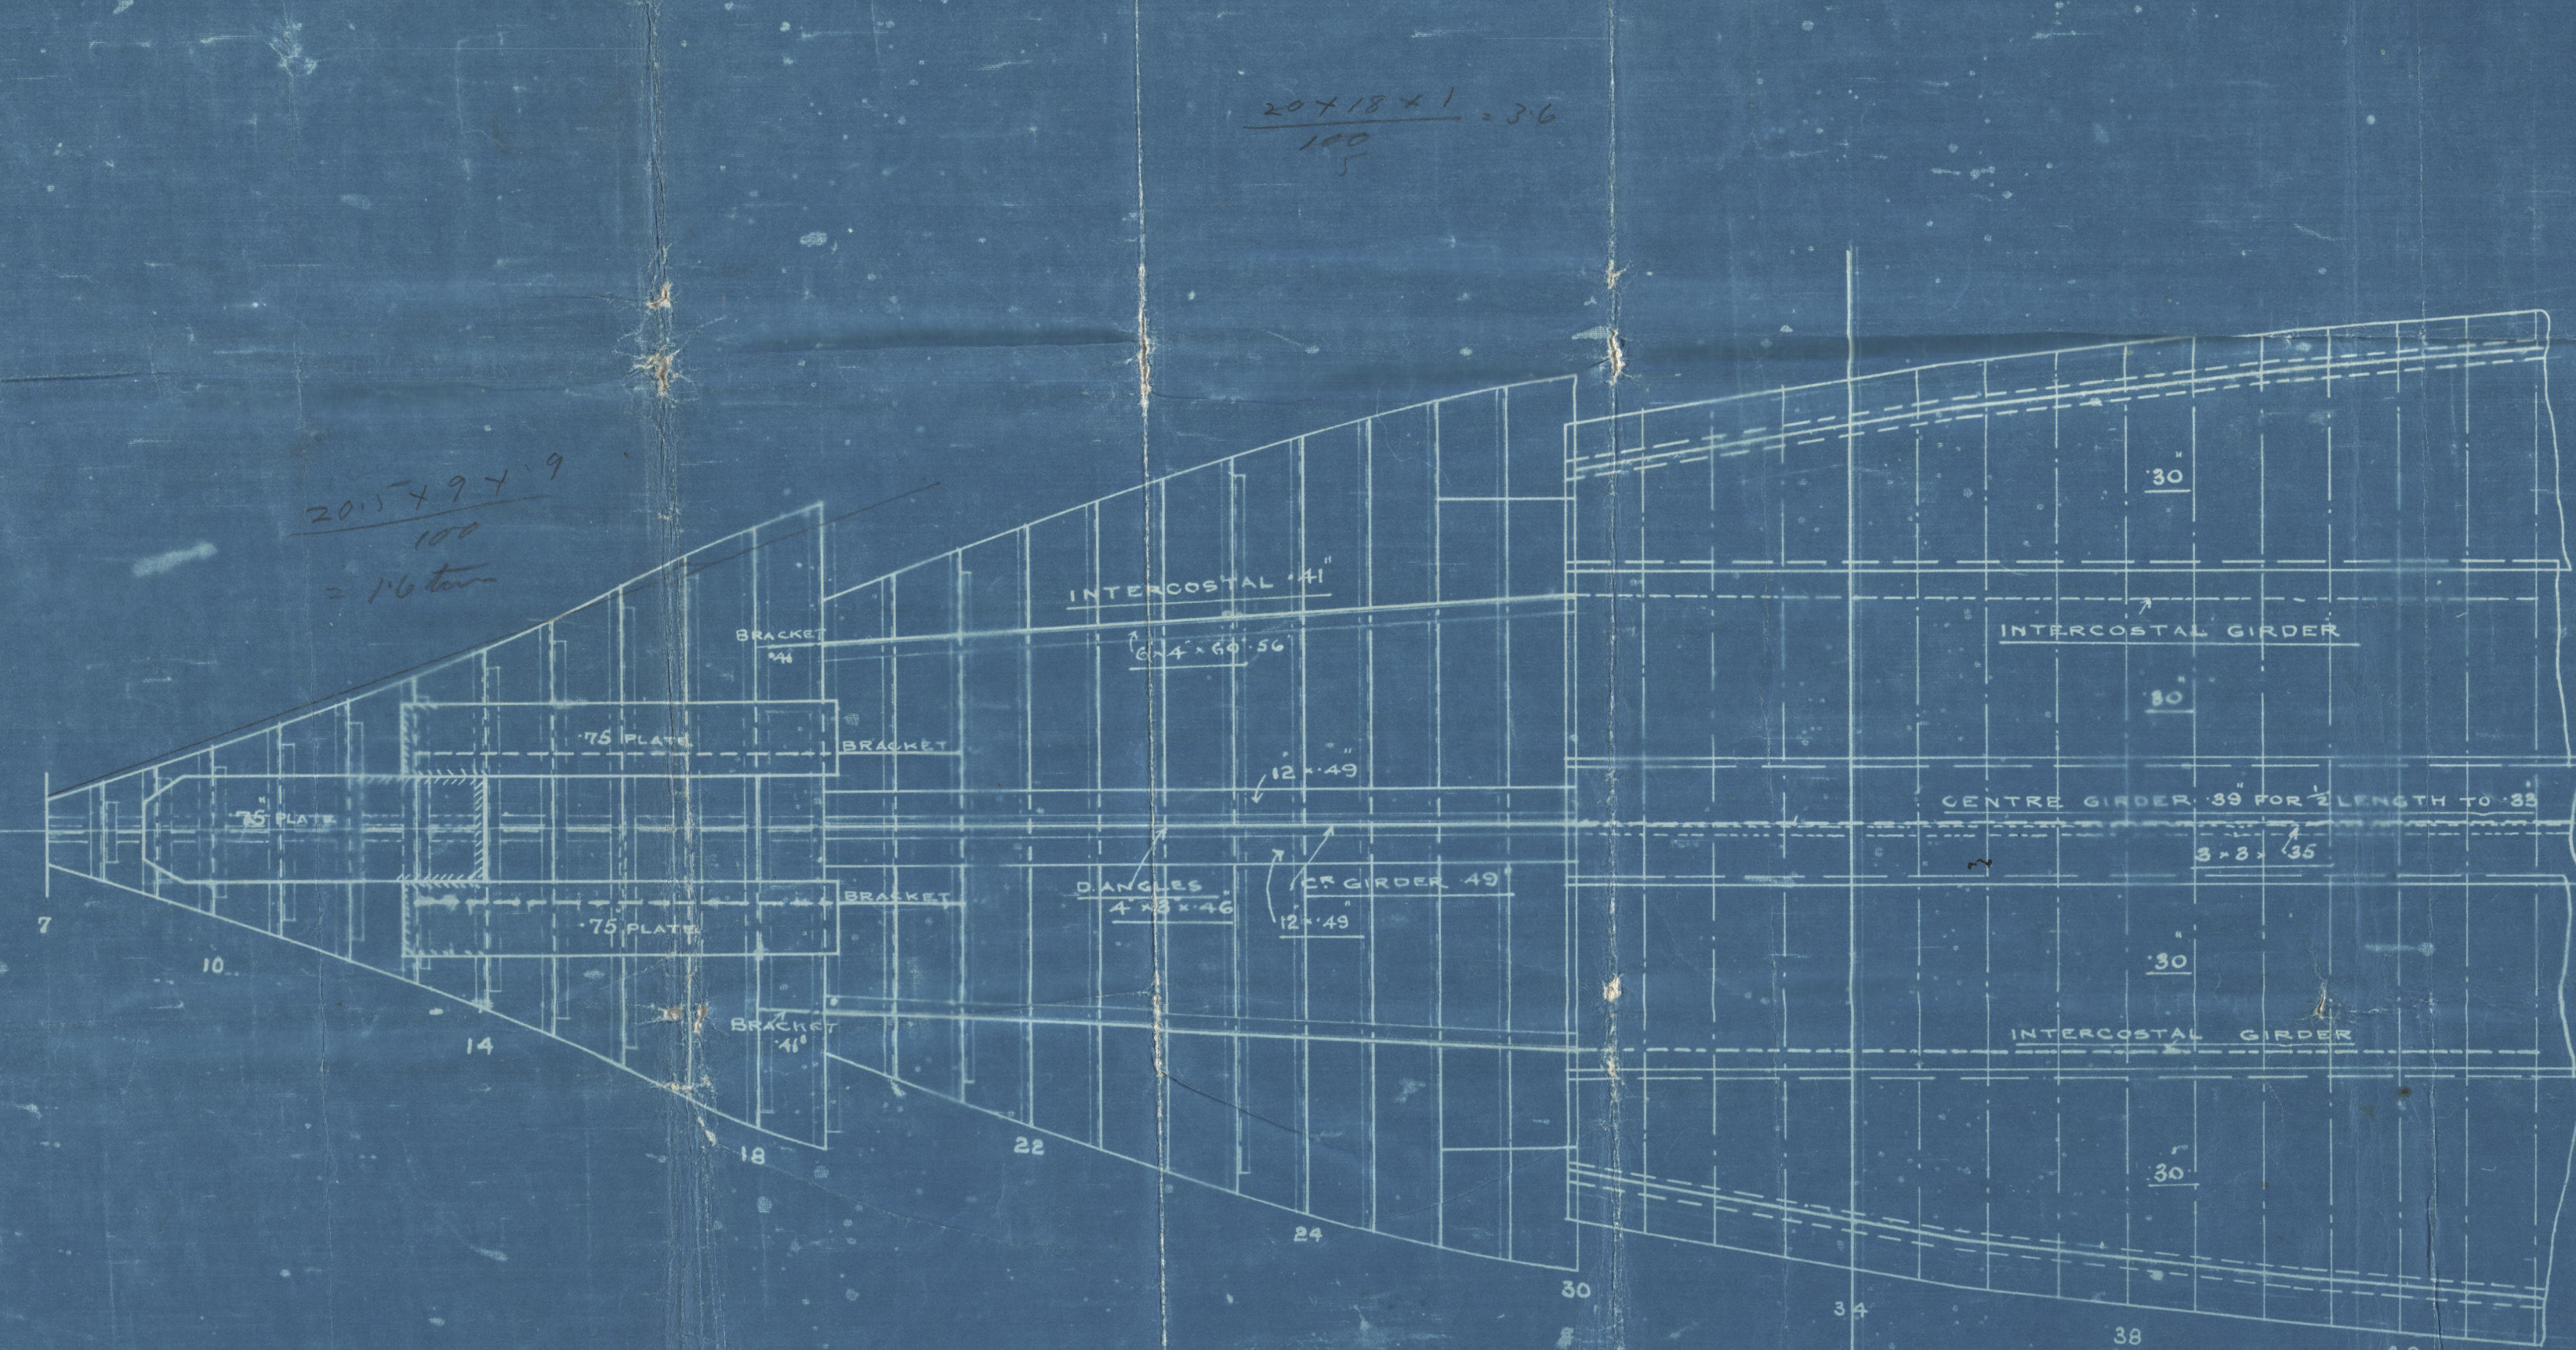  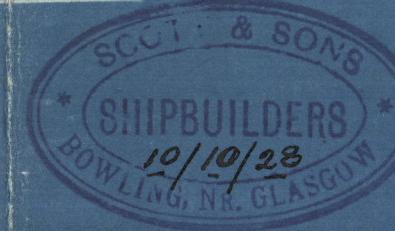

APPROVED for 309 930
LLOYDS REGISTER OF SHIPPING
H. Ward
17.8.29

APPROVED for 314
LLOYDS REGISTER OF SHIPPING
H. Ward
17.5.29

APPROVED for 310
LLOYDS REGISTER OF SHIPPING
H. Ward
15.11.29

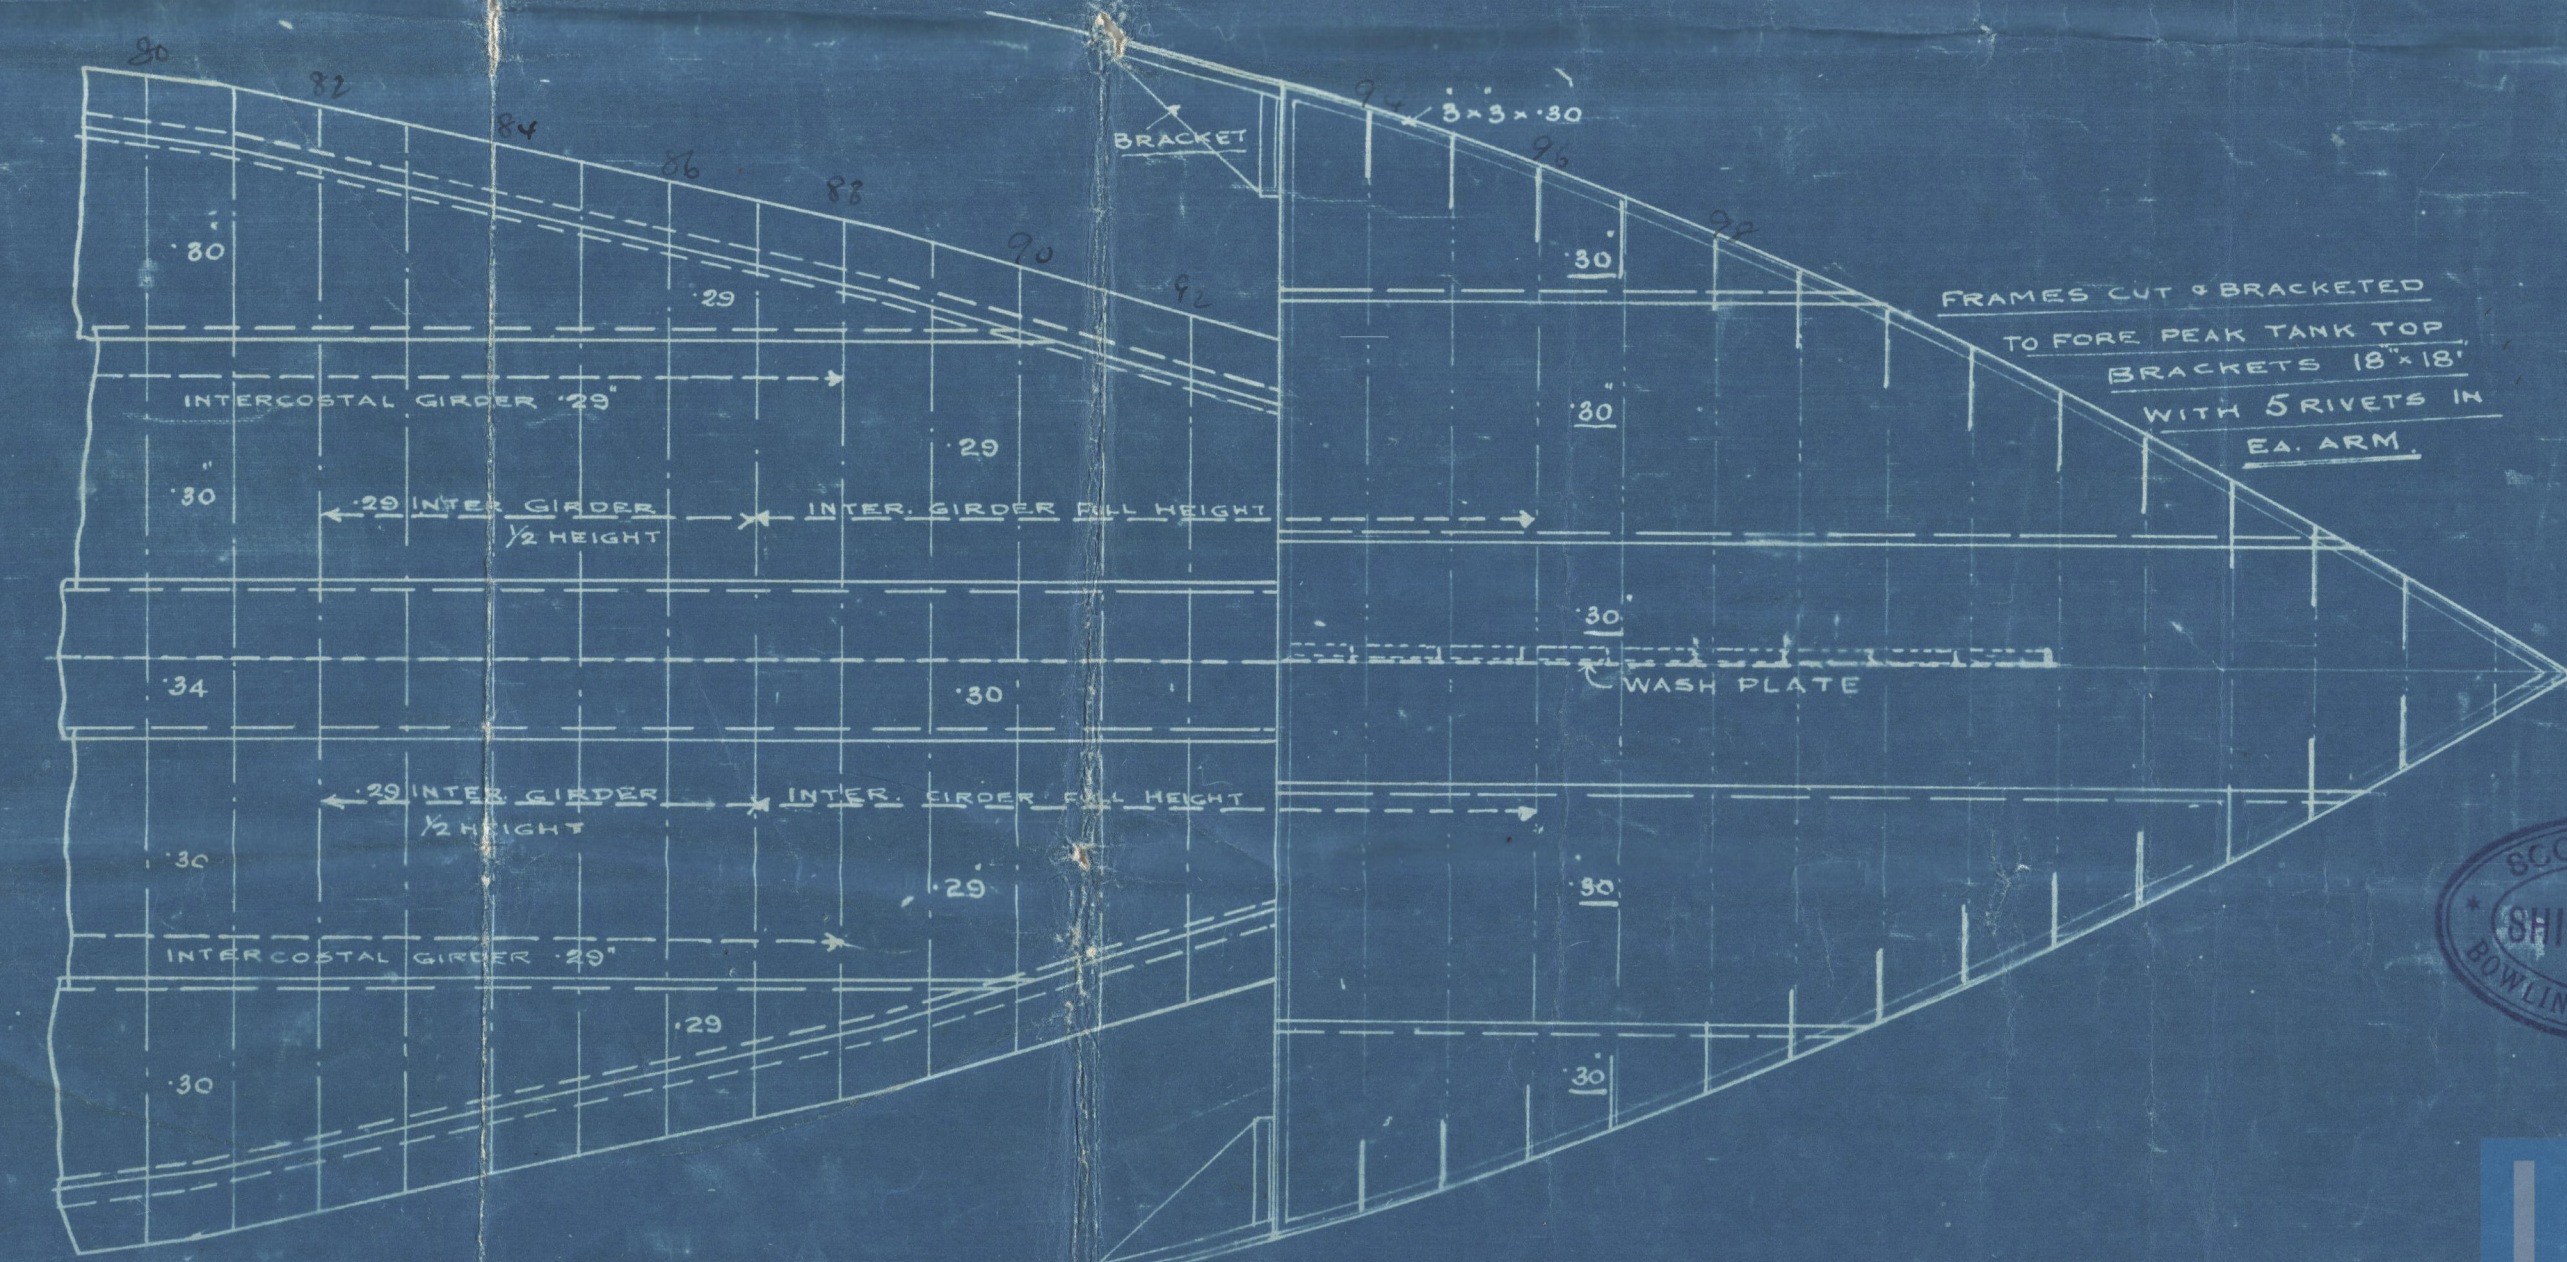

003816-003823-0214

Scott Sons,

No. 313. - 4-309-310.

Profile & decks.

~~W.S. 37P~~

Fbd

GLASGOW REPORT No. 48861

~~313. Yewdale~~

GLASGOW REPORT No. 49000

Fbd

GLASGOW REPORT No. 49556

~~314. Yewcraft~~

GLASGOW REPORT No. 49642

~~309. Yewpark~~

GLASGOW REPORT No. 50141

Yewarch Fbd

GLASGOW REPORT No. 51628

310 Yewarch
GLASGOW REPORT No. 51755