

20 FEB 1945

Rpt. C.11 (Contd.)


Index No.

Lloyd's Register of Shipping.

Ship's Name **S.S. OLWEN**

Official No. **140449**

Memorandum of alterations reported since ship was surveyed for assignment of Load Lines in **✓**

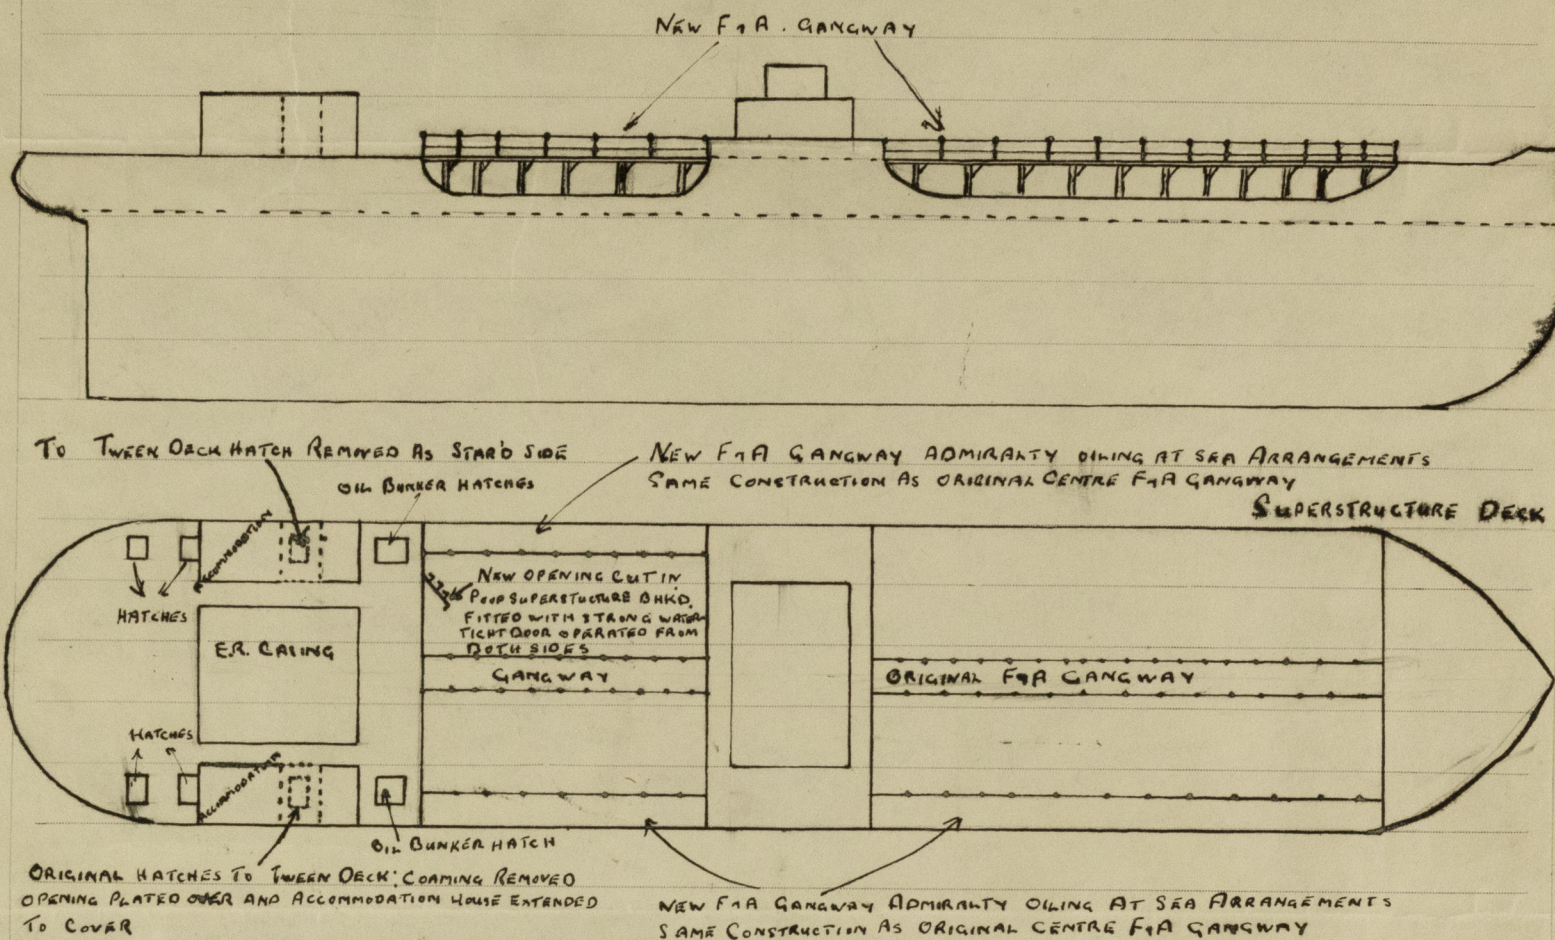

Noted
20 FEB 1945
H.P.S.