




12/2/17
19/3/17

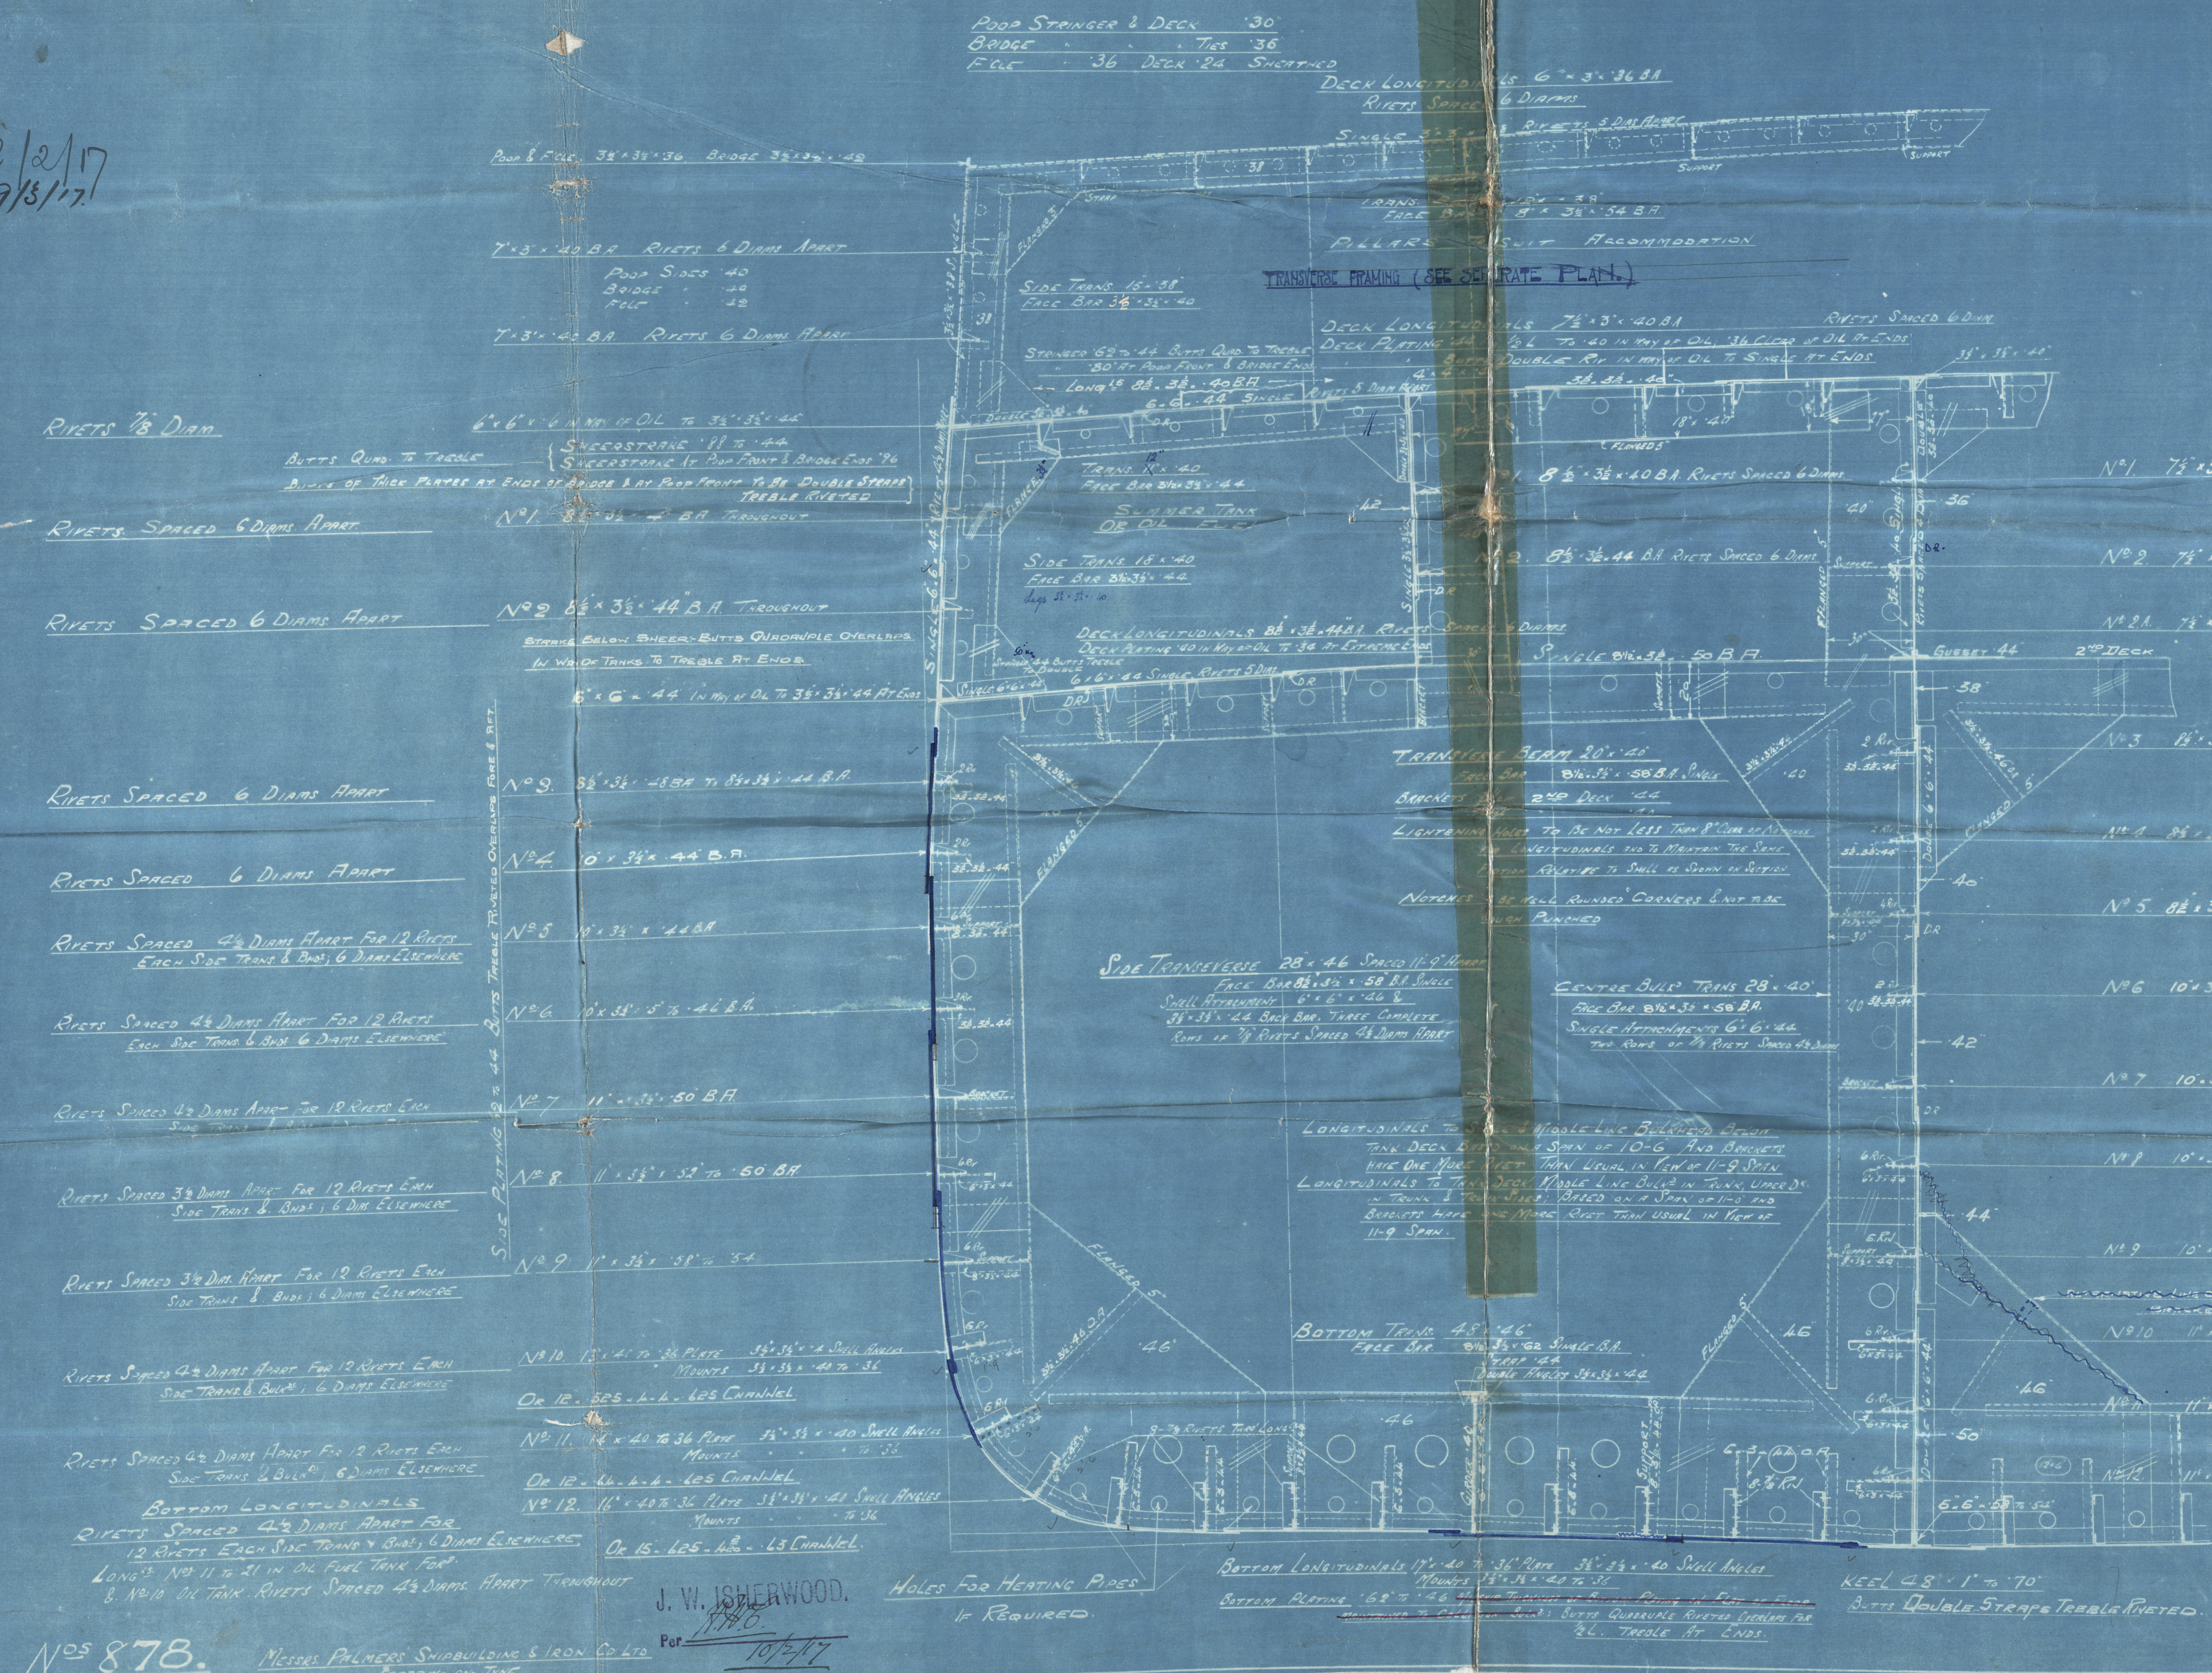

MIDSHIP SECTION

LENGTH BR 420'0" BREADTH EXT 54'6" DEPTH MID 32'8 1/2" TO UPPER D'S
ISHERWOOD SYSTEM PATENT
SCALE 1/2" = 1 FOOT

LLOYDS NUMERALS	
BREADTH MID	34'29"
DEPTH MID	32'70"
LENGTH	420'00"
DEPTH TO LENGTH	36'536'0" LONGITUDINAL N°

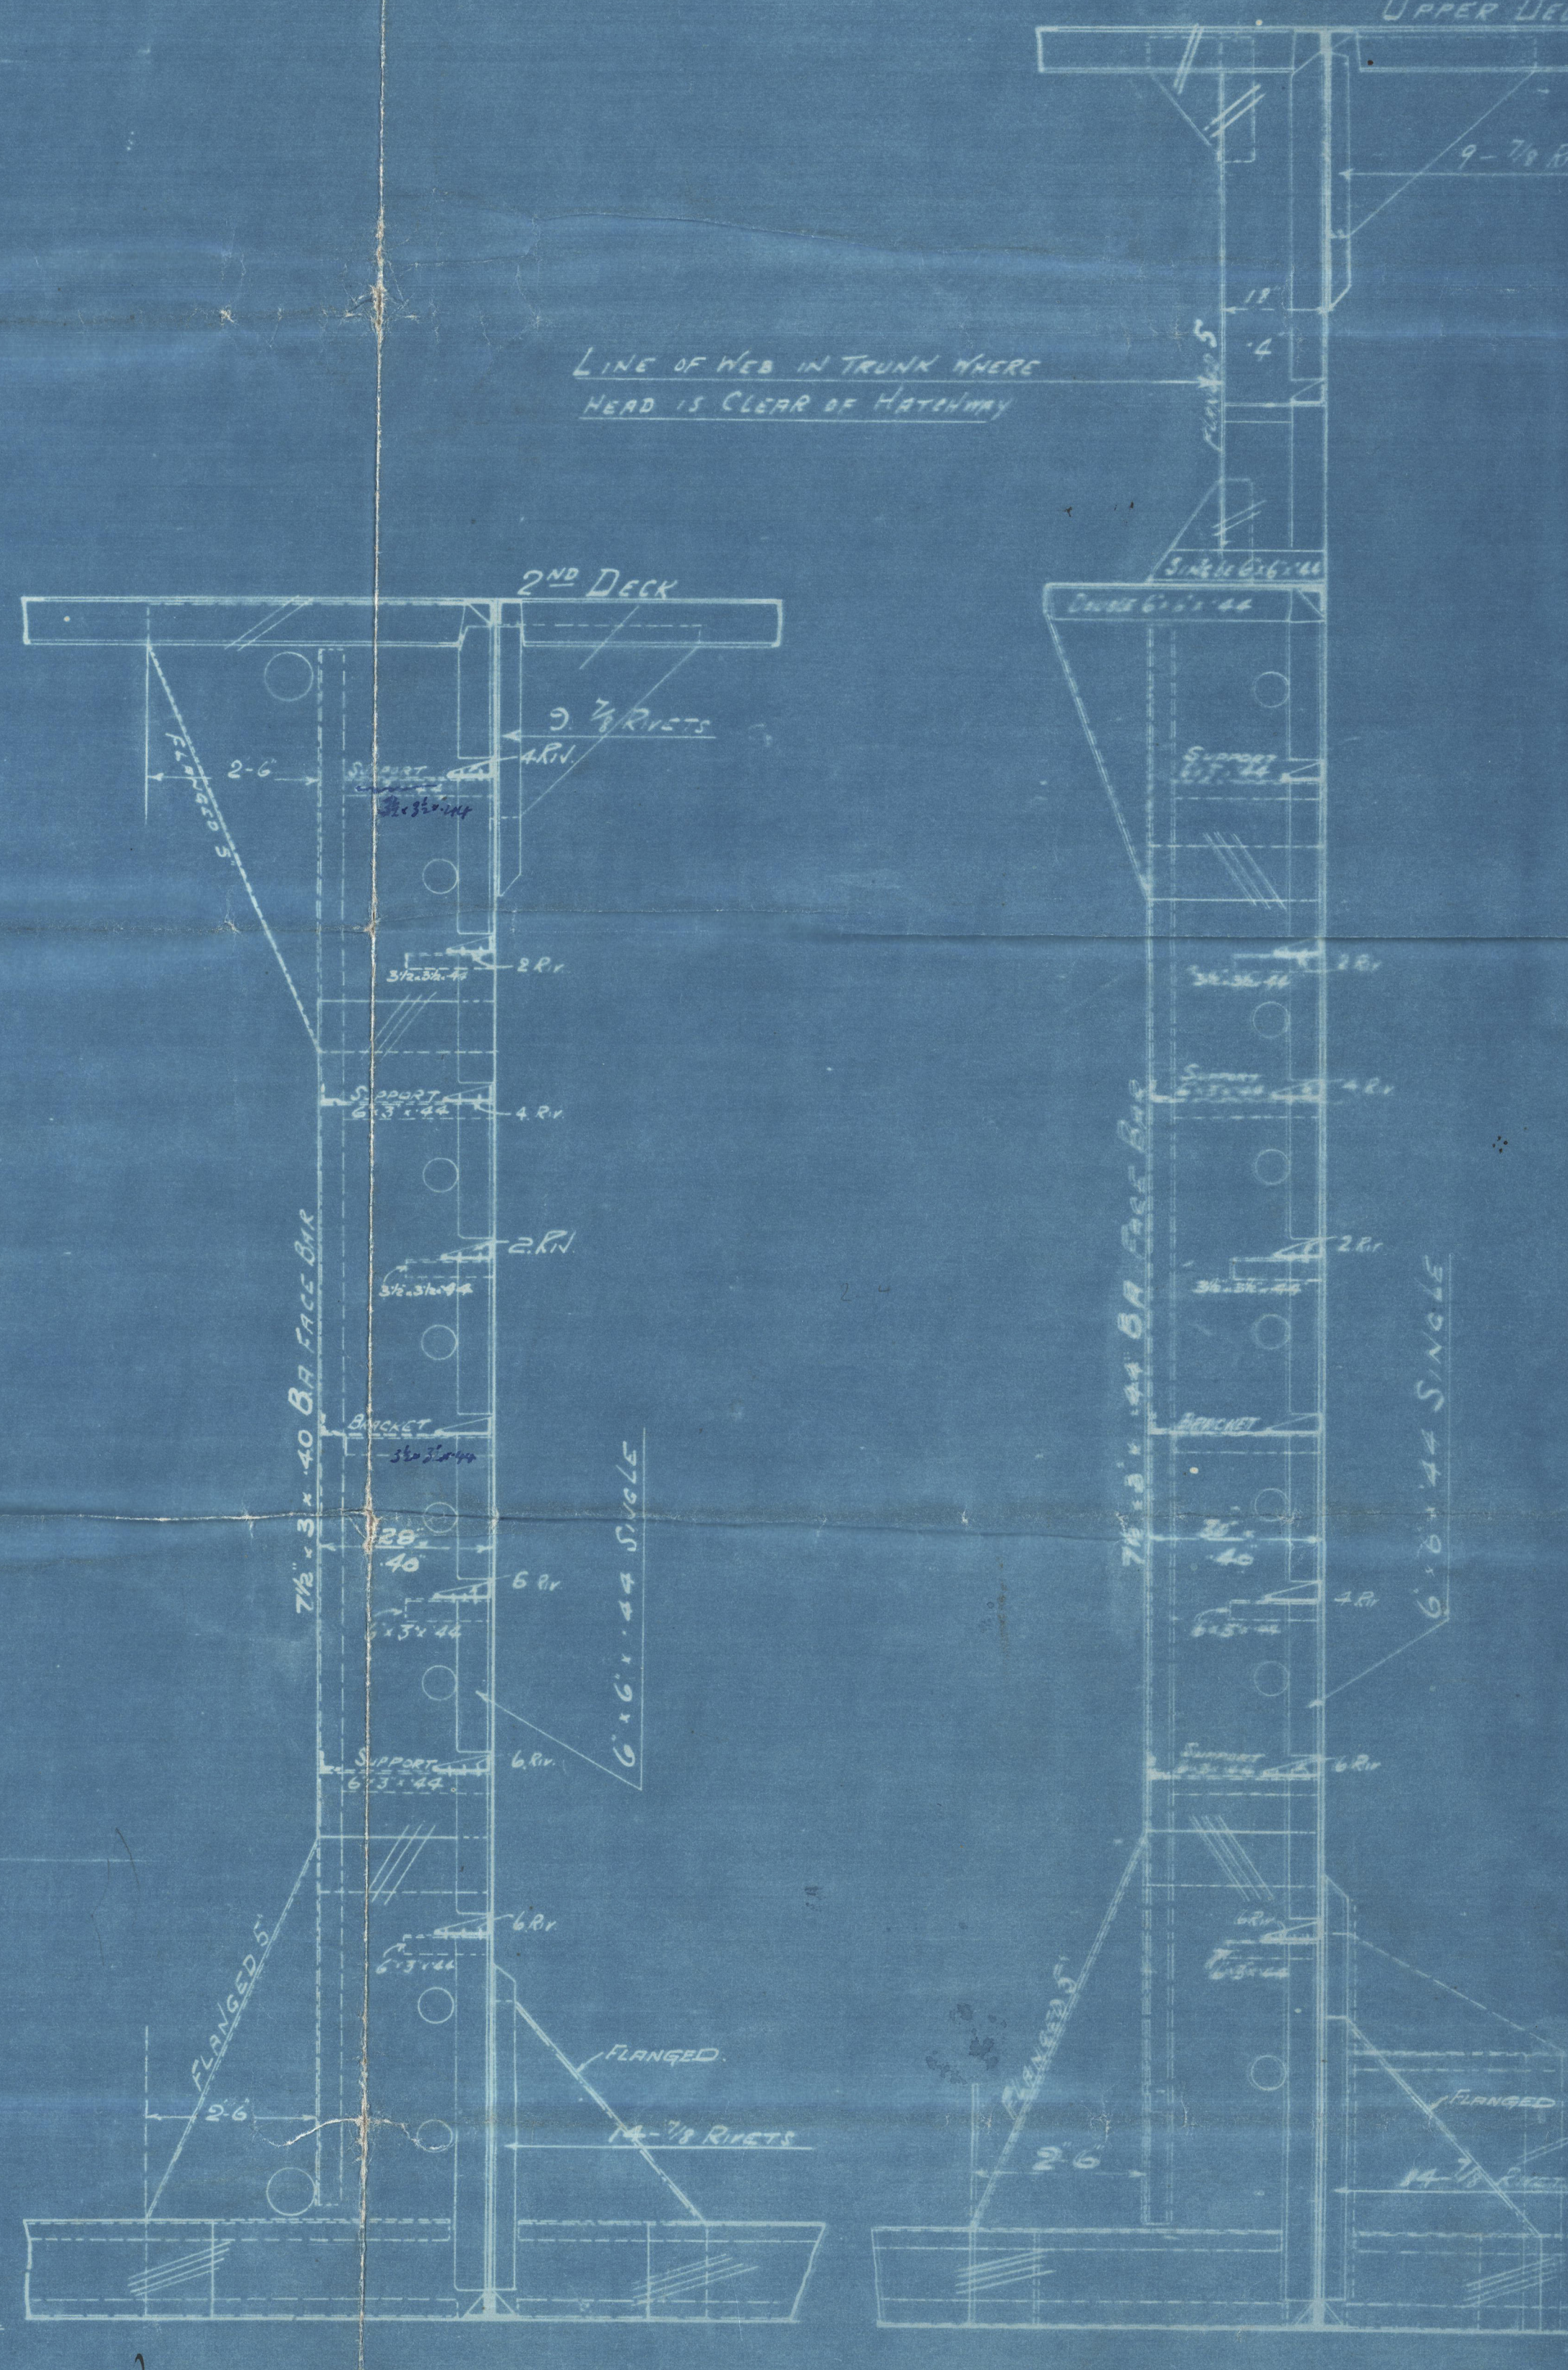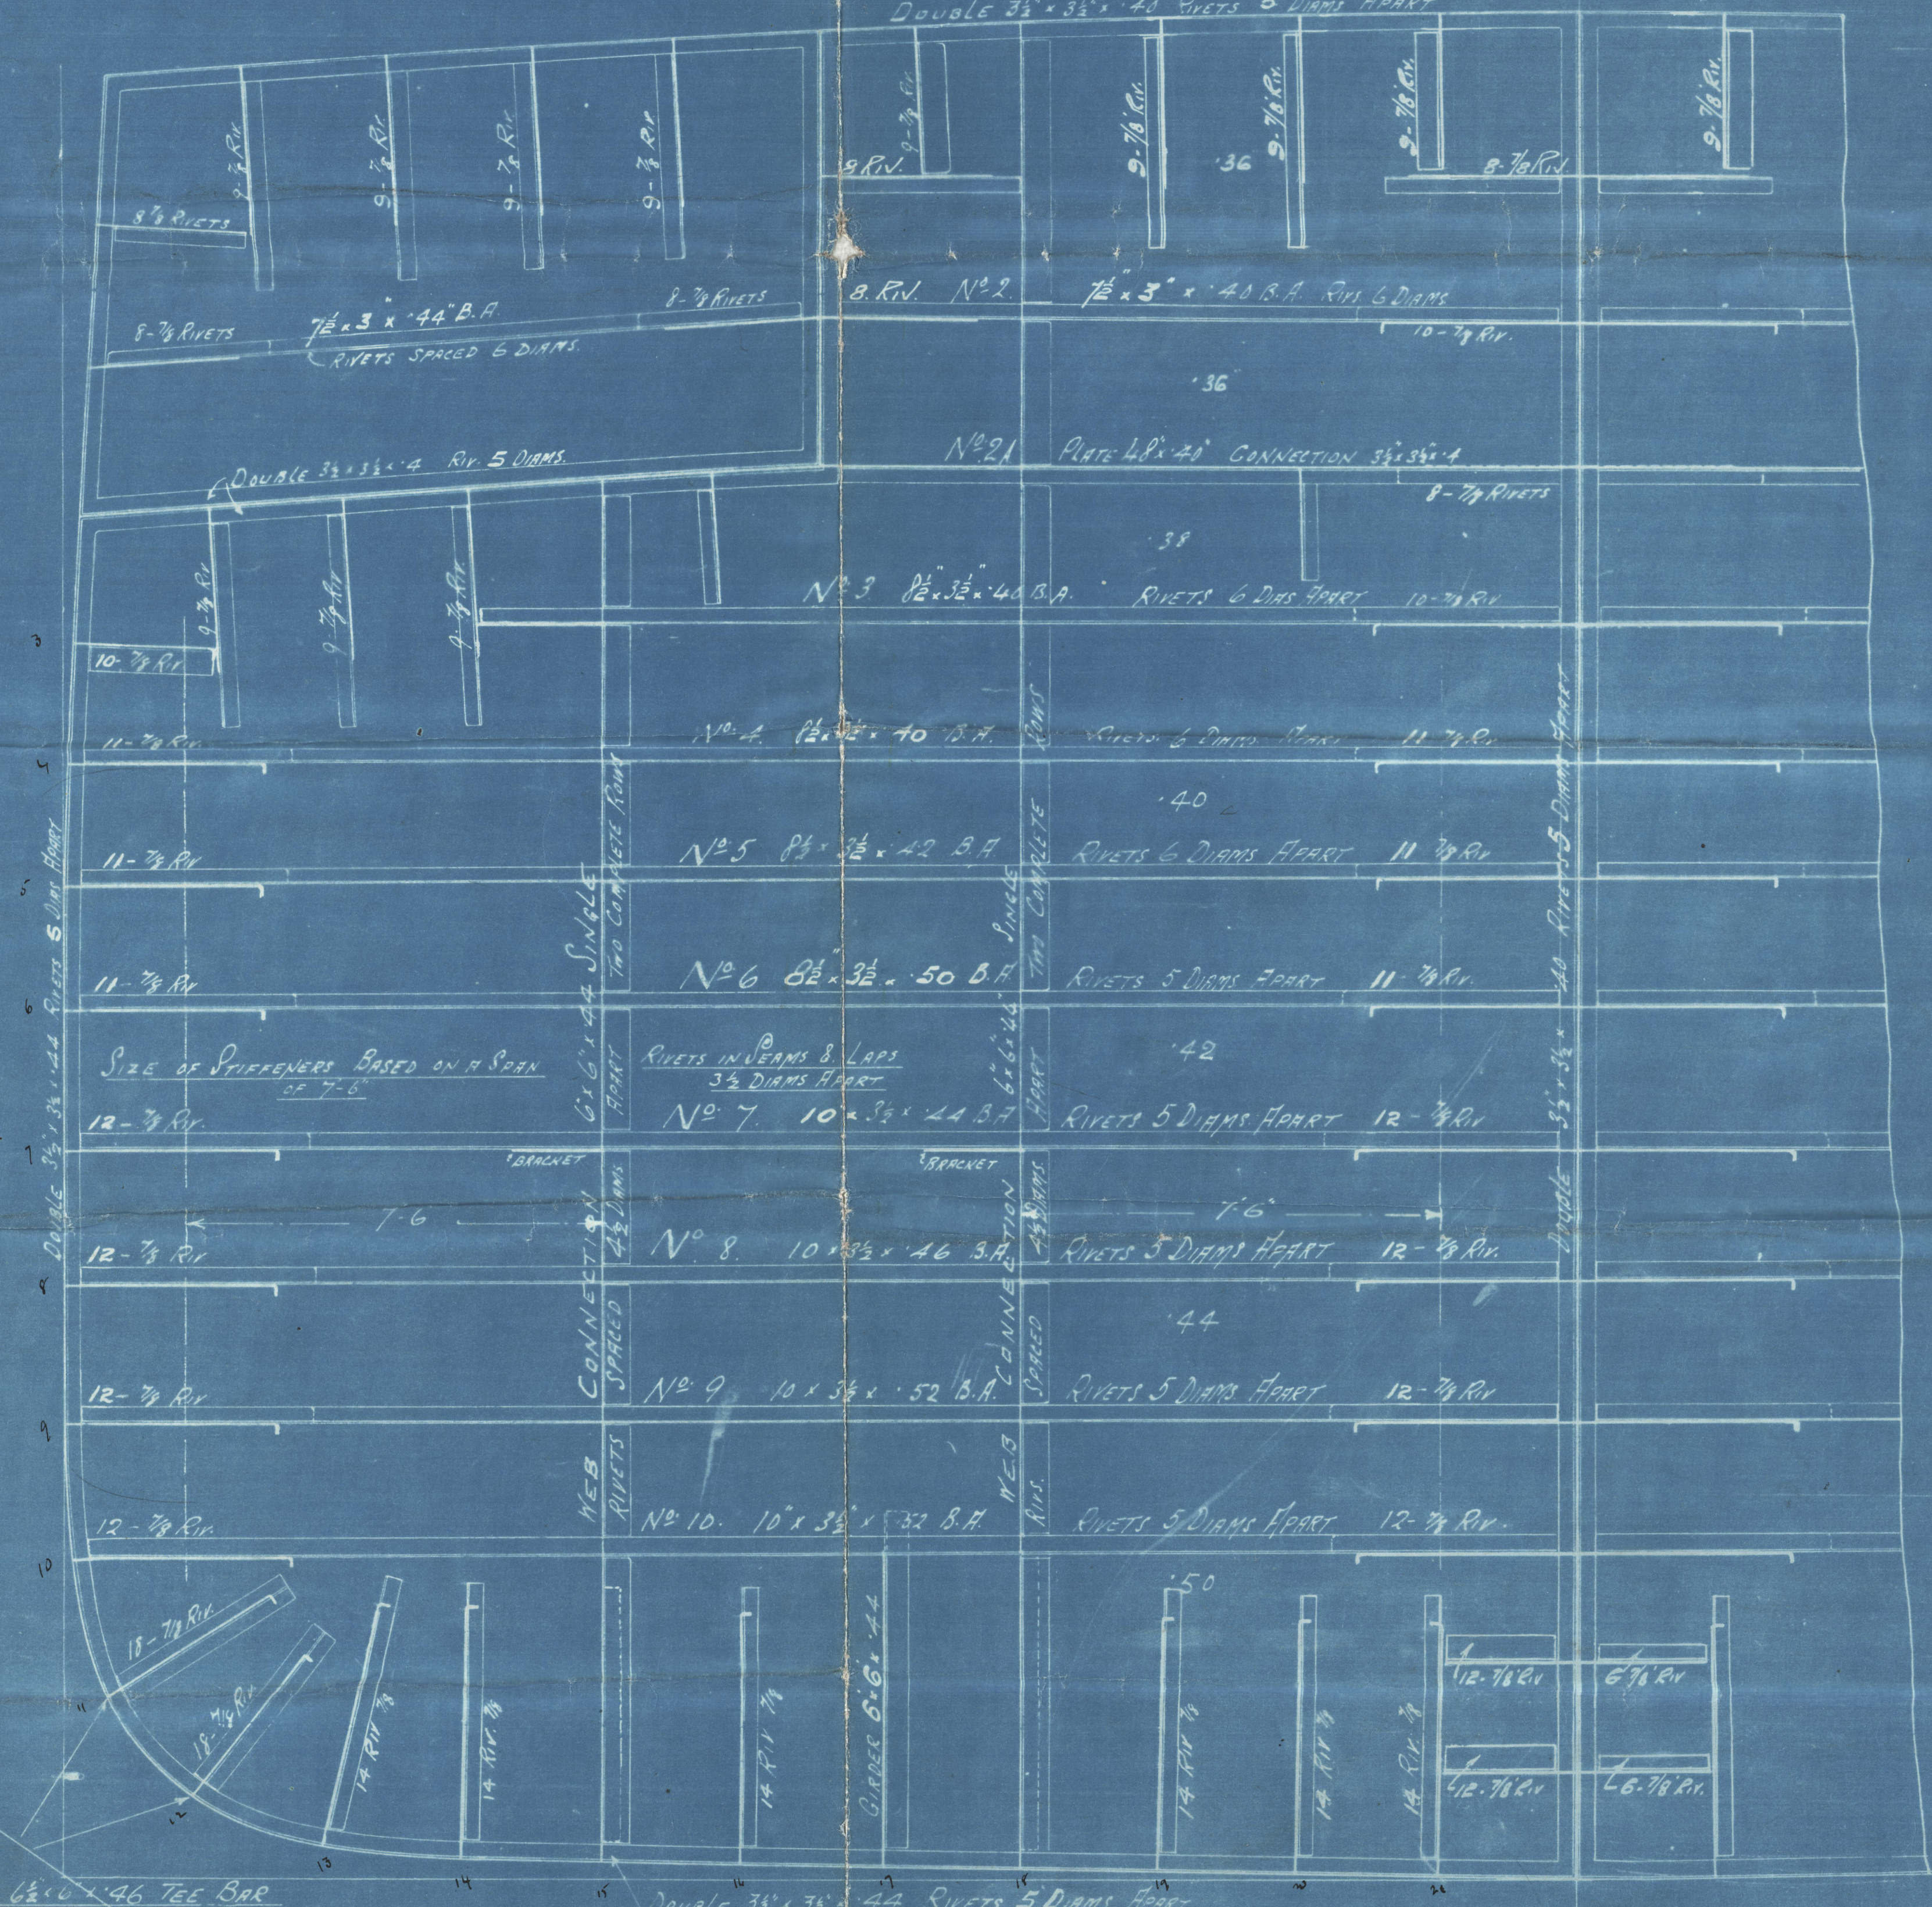


Palmer's SB & Son Co. Ltd

No 87 8 ship

Approved plan of Midship Section
and Oil tight Bulkhead.


"S.S. British Lights" Mustaxi &
Nwe 70582.

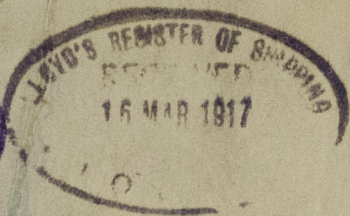

$$\begin{array}{r} 23 \\ 8 \overline{) 212} \\ \underline{16} \\ 5 \end{array}$$



$$\begin{array}{r} 2'10 \\ 3\frac{1}{2} \end{array}$$

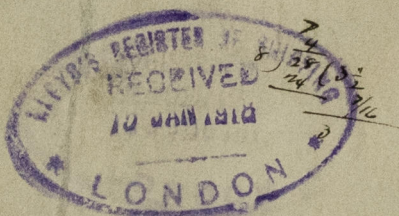

$$\begin{array}{r} 24 \\ 8 \overline{) 24} \\ \underline{24} \\ 0 \end{array}$$

RETAINED
GIVEN

Yn Mustaxi



© 2020

Lloyd's Register
Foundation

003816-003823-0252