
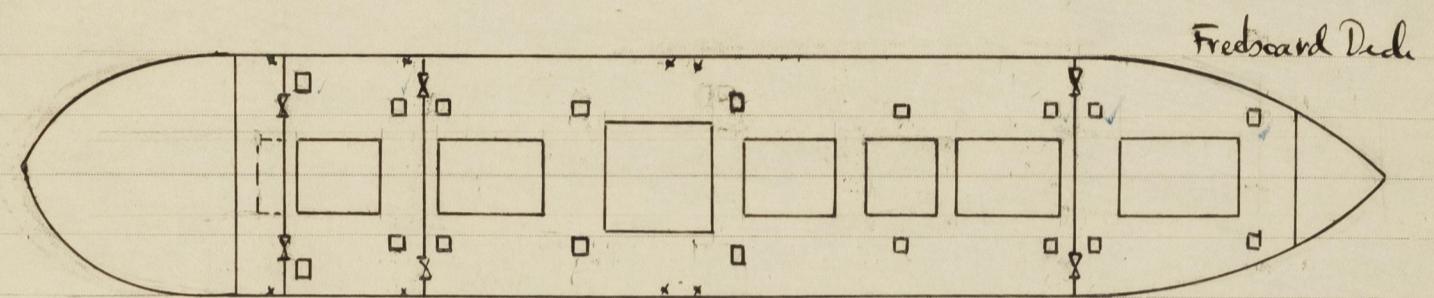


Lloyd's Register of Shipping.

Ship's Name M/S "PANAGHIA" ex "ASTORIA"

Official No.

Memorandum of alterations reported since ship was surveyed for assignment of Load Lines
in January 1942 (as per Rpt C 11 (contd))

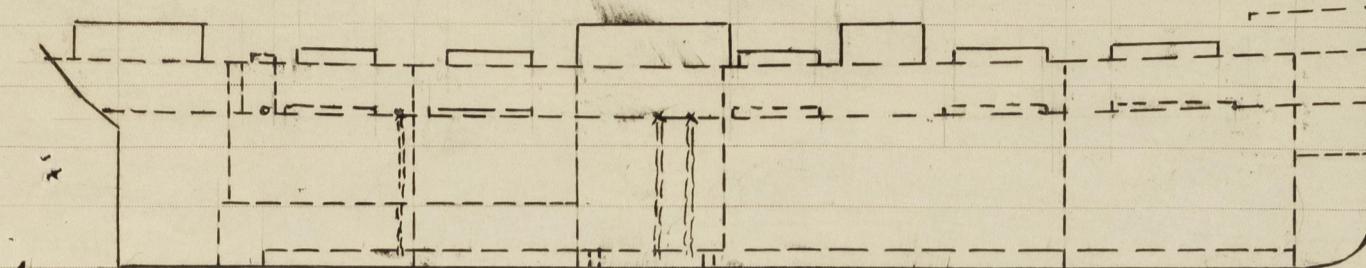

Scupper from freeboard deck. The 6 scupper lead overboard through shell plating found closed and following scupper found fitted.


- 1 4" ^{Should be} scupper each side in forecastle well flush with deck and fitted with screw down valve with spindle on shelterdeck. with open shut indicator
1 3" each side to hold N° 4 bilge ^{low bottom from shells etc?}
1 4" " - - eng. room bilge with weighted lever cock?
1 2 1/2" " " " "

Tween deck bulkheads between N° 1 & 2 and N° 3 & 4 tween deck spacers with 1 opening each side in full height and 36" wide.

Acer hatch on freeboard deck. 9 hatches each side 24" x 28" with 9" x 3" coaming and 2 1/2" wood cover, 2" bearing surface. with 1 tarpon & battening angled?


Tankage well The 2'-2" x 2'-6" hinged shutter each side closed permanently.

Tankage hatch:

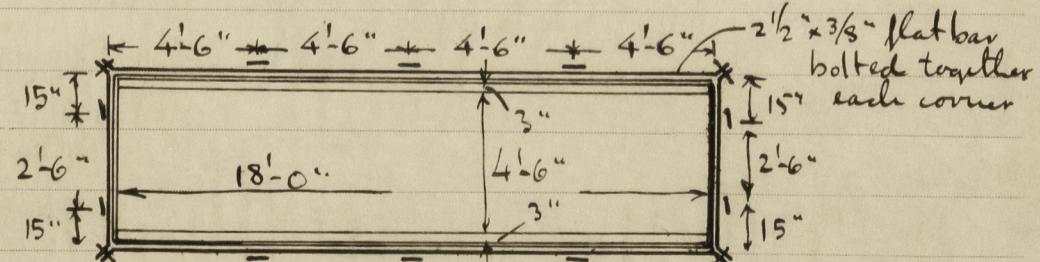

Tarpaulins: No tarpaulins fitted to 2nd deck hatch.
Tarpaulins to be supplied

B. Hydermyr Haven
11/2-54

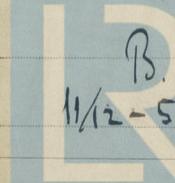

© 2020
Lloyd's Register
Foundation