



Fracture approx 5" long and 1 1/4" deep.

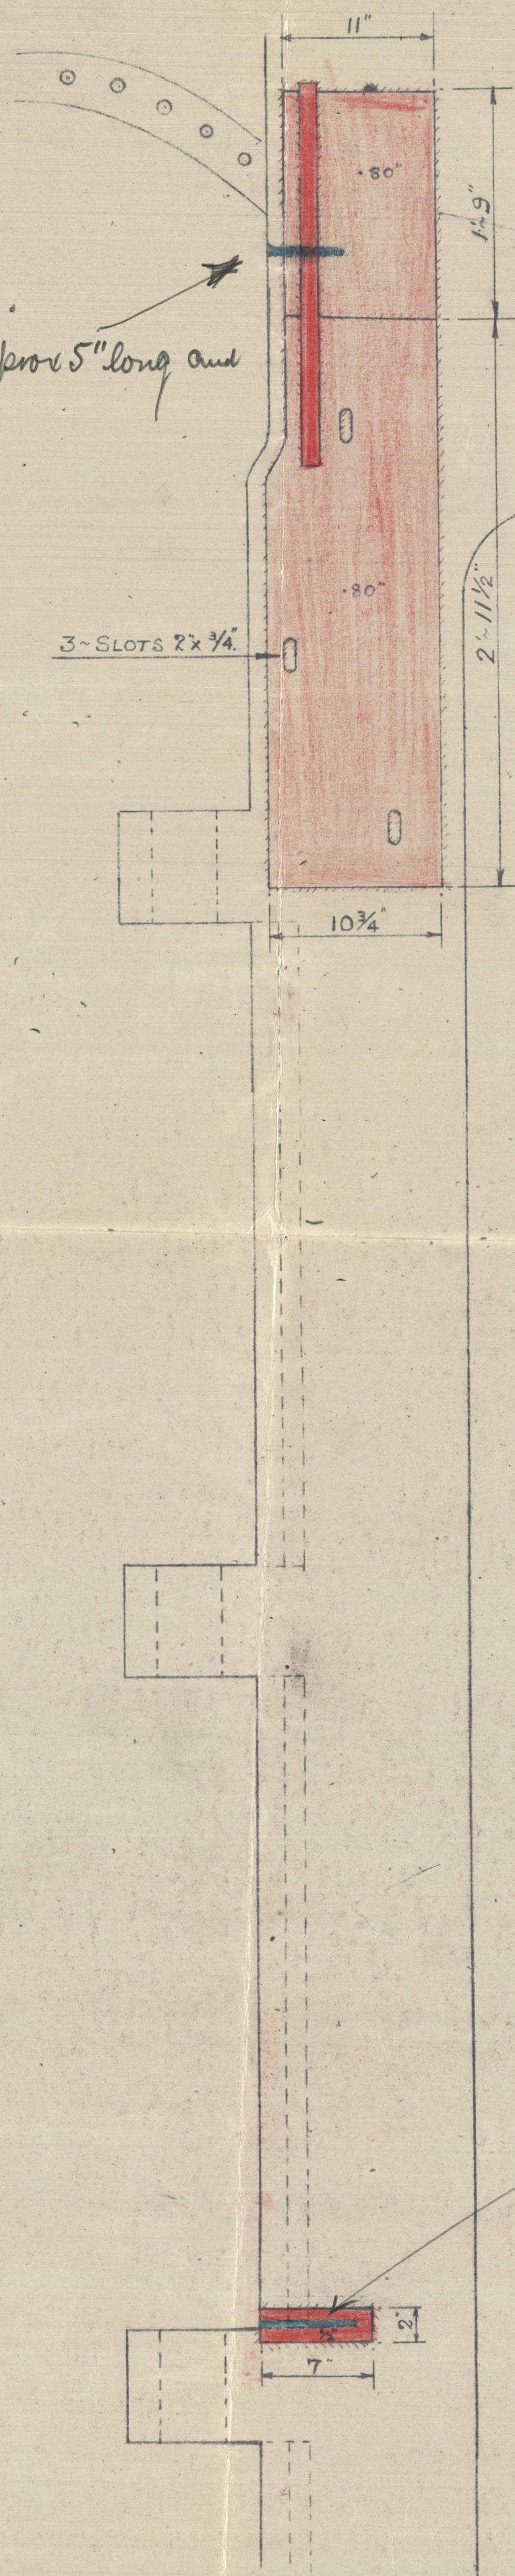

Fracture 5" long and 3/4" deep

Fracture approx 4" long and 1 1/4" deep.

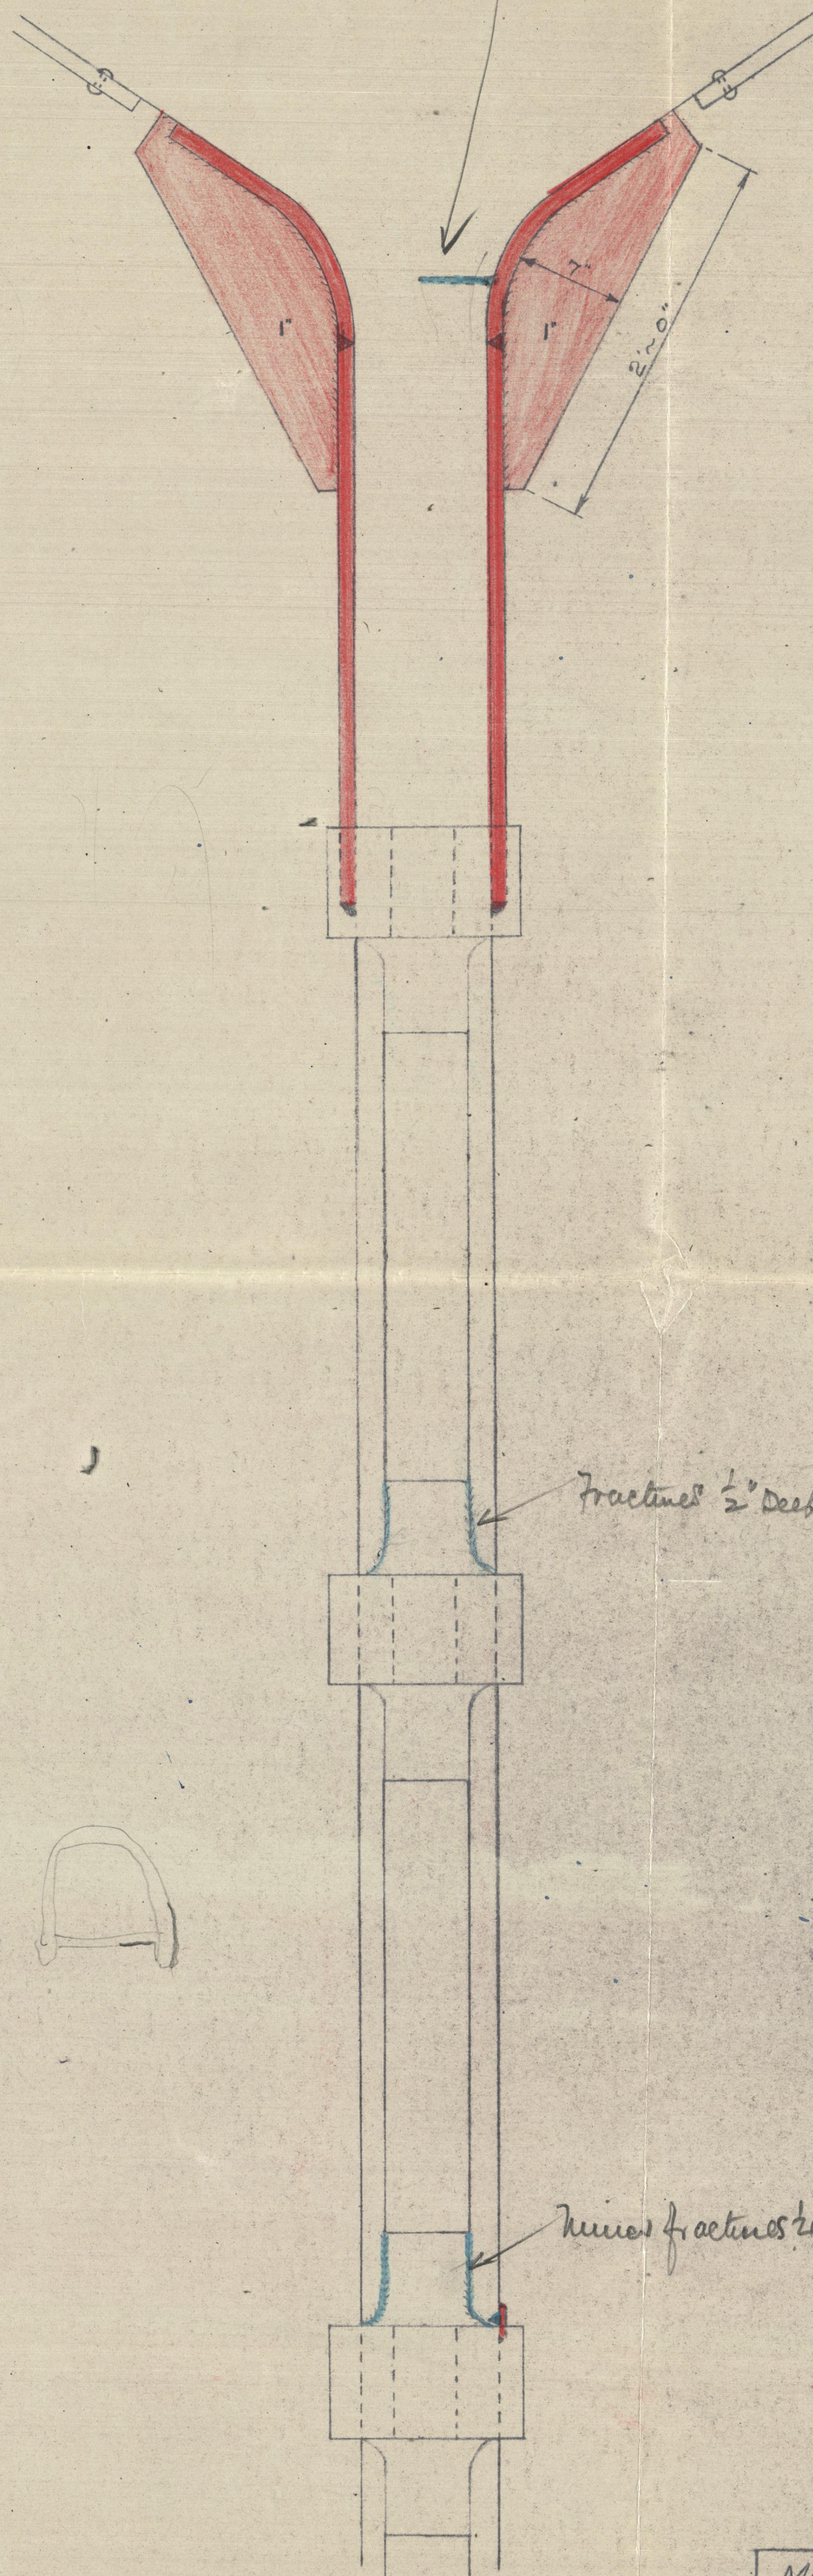

Fractures 1/2" deep

Minor fractures 1/4" deep

FRACTURES.
NEW PLATES.

MANCHESTER DRY DOCKS CO. LTD.		
M.V. "ROTULA."		
FRACTURES ON RUDDER POST.		
SCALE	DATE	DWG. NO.
—	DEC. 9. 52.	1455

"
Rotula"

Rpt. NO. Rot. 36580,

~~1st~~

Fractures on
rudder post.



© 2020

Lloyd's Register
Foundation

003824-003831-0191