

26/10/45.

# M/V "RAPANA"


FRACTURES IN STERN FRAME  
SHOWN IN RED.  
SCALE:- 1:20

R.K.D.

STARBOARD SIDE

PORT SIDE

NOTE:- NEW PLATES SHOWN  
SHADED.

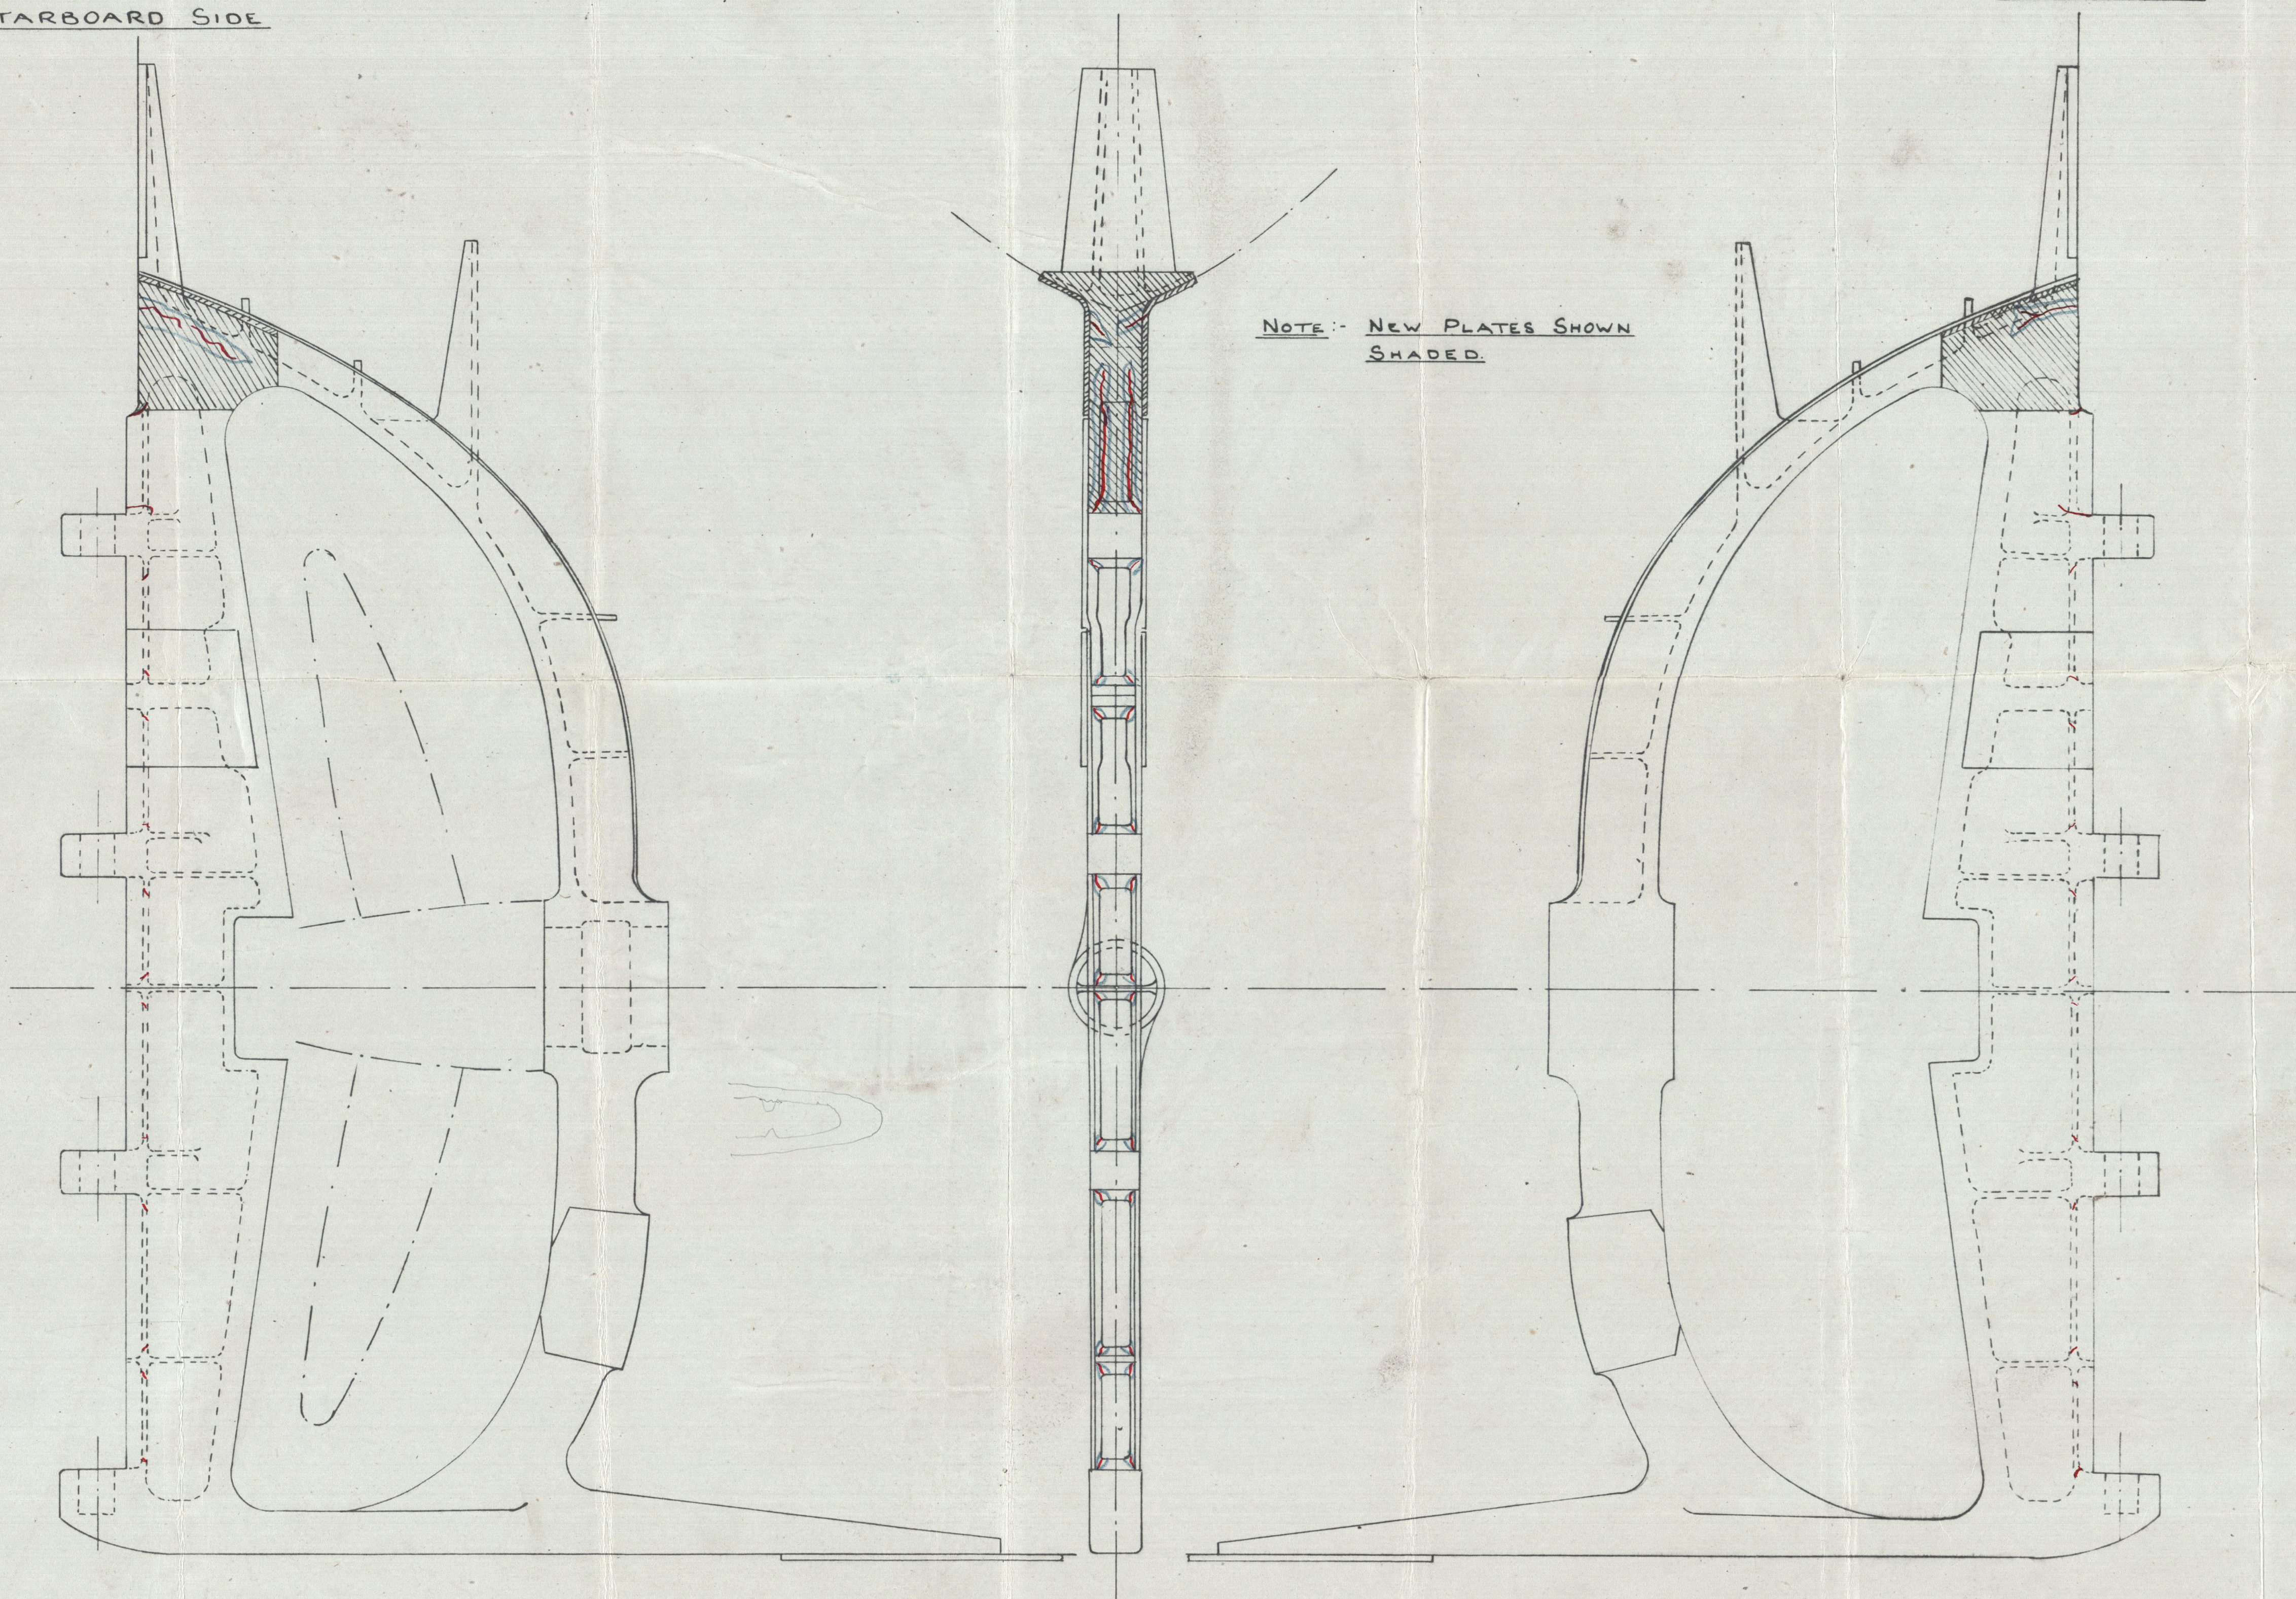



Rapana

Rpt.  
Bry. 25403

11/45



© 2020

Lloyd's Register  
Foundation

003824-003831-0196