

Rpt. C. 11 (Contd.)


Index No. 31798

Lloyd's Register of Shipping.

Ship's Name MAHOUT

Official No. 147347.

Memorandum of alterations reported since ship was surveyed for assignment of Load Lines
in April, 1932

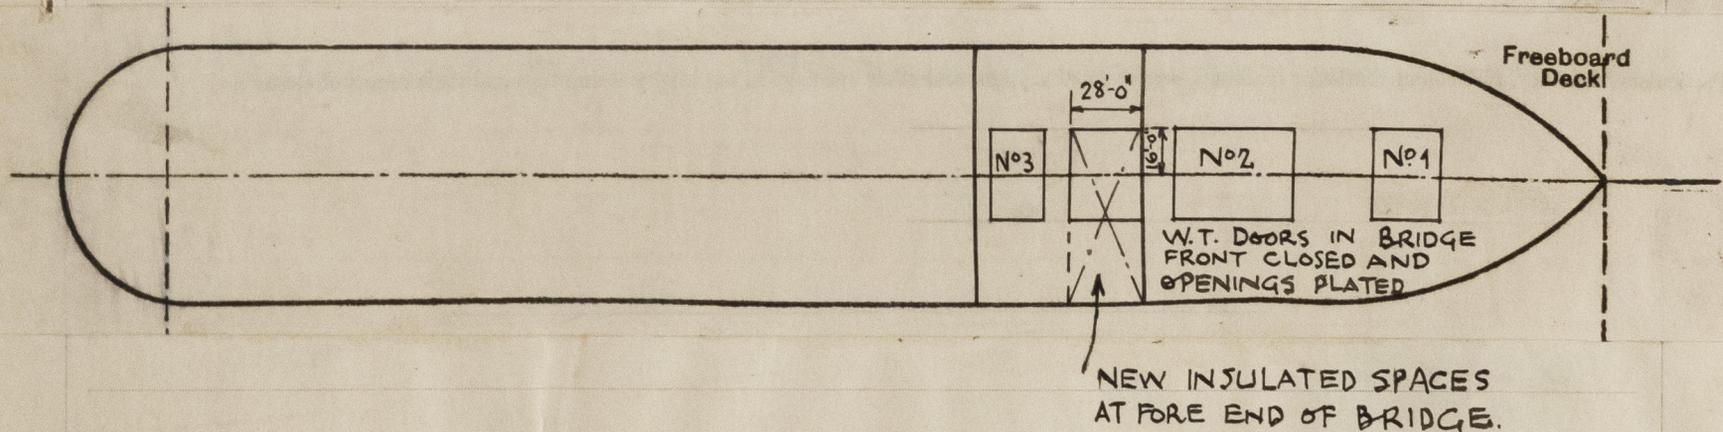

MIDDLESBOROUGH REPORT C11(a), JAN. 1936.

S.B. 29.5.32

Lloyd's Register
Foundation

003832-003837-0037