


16/7/32

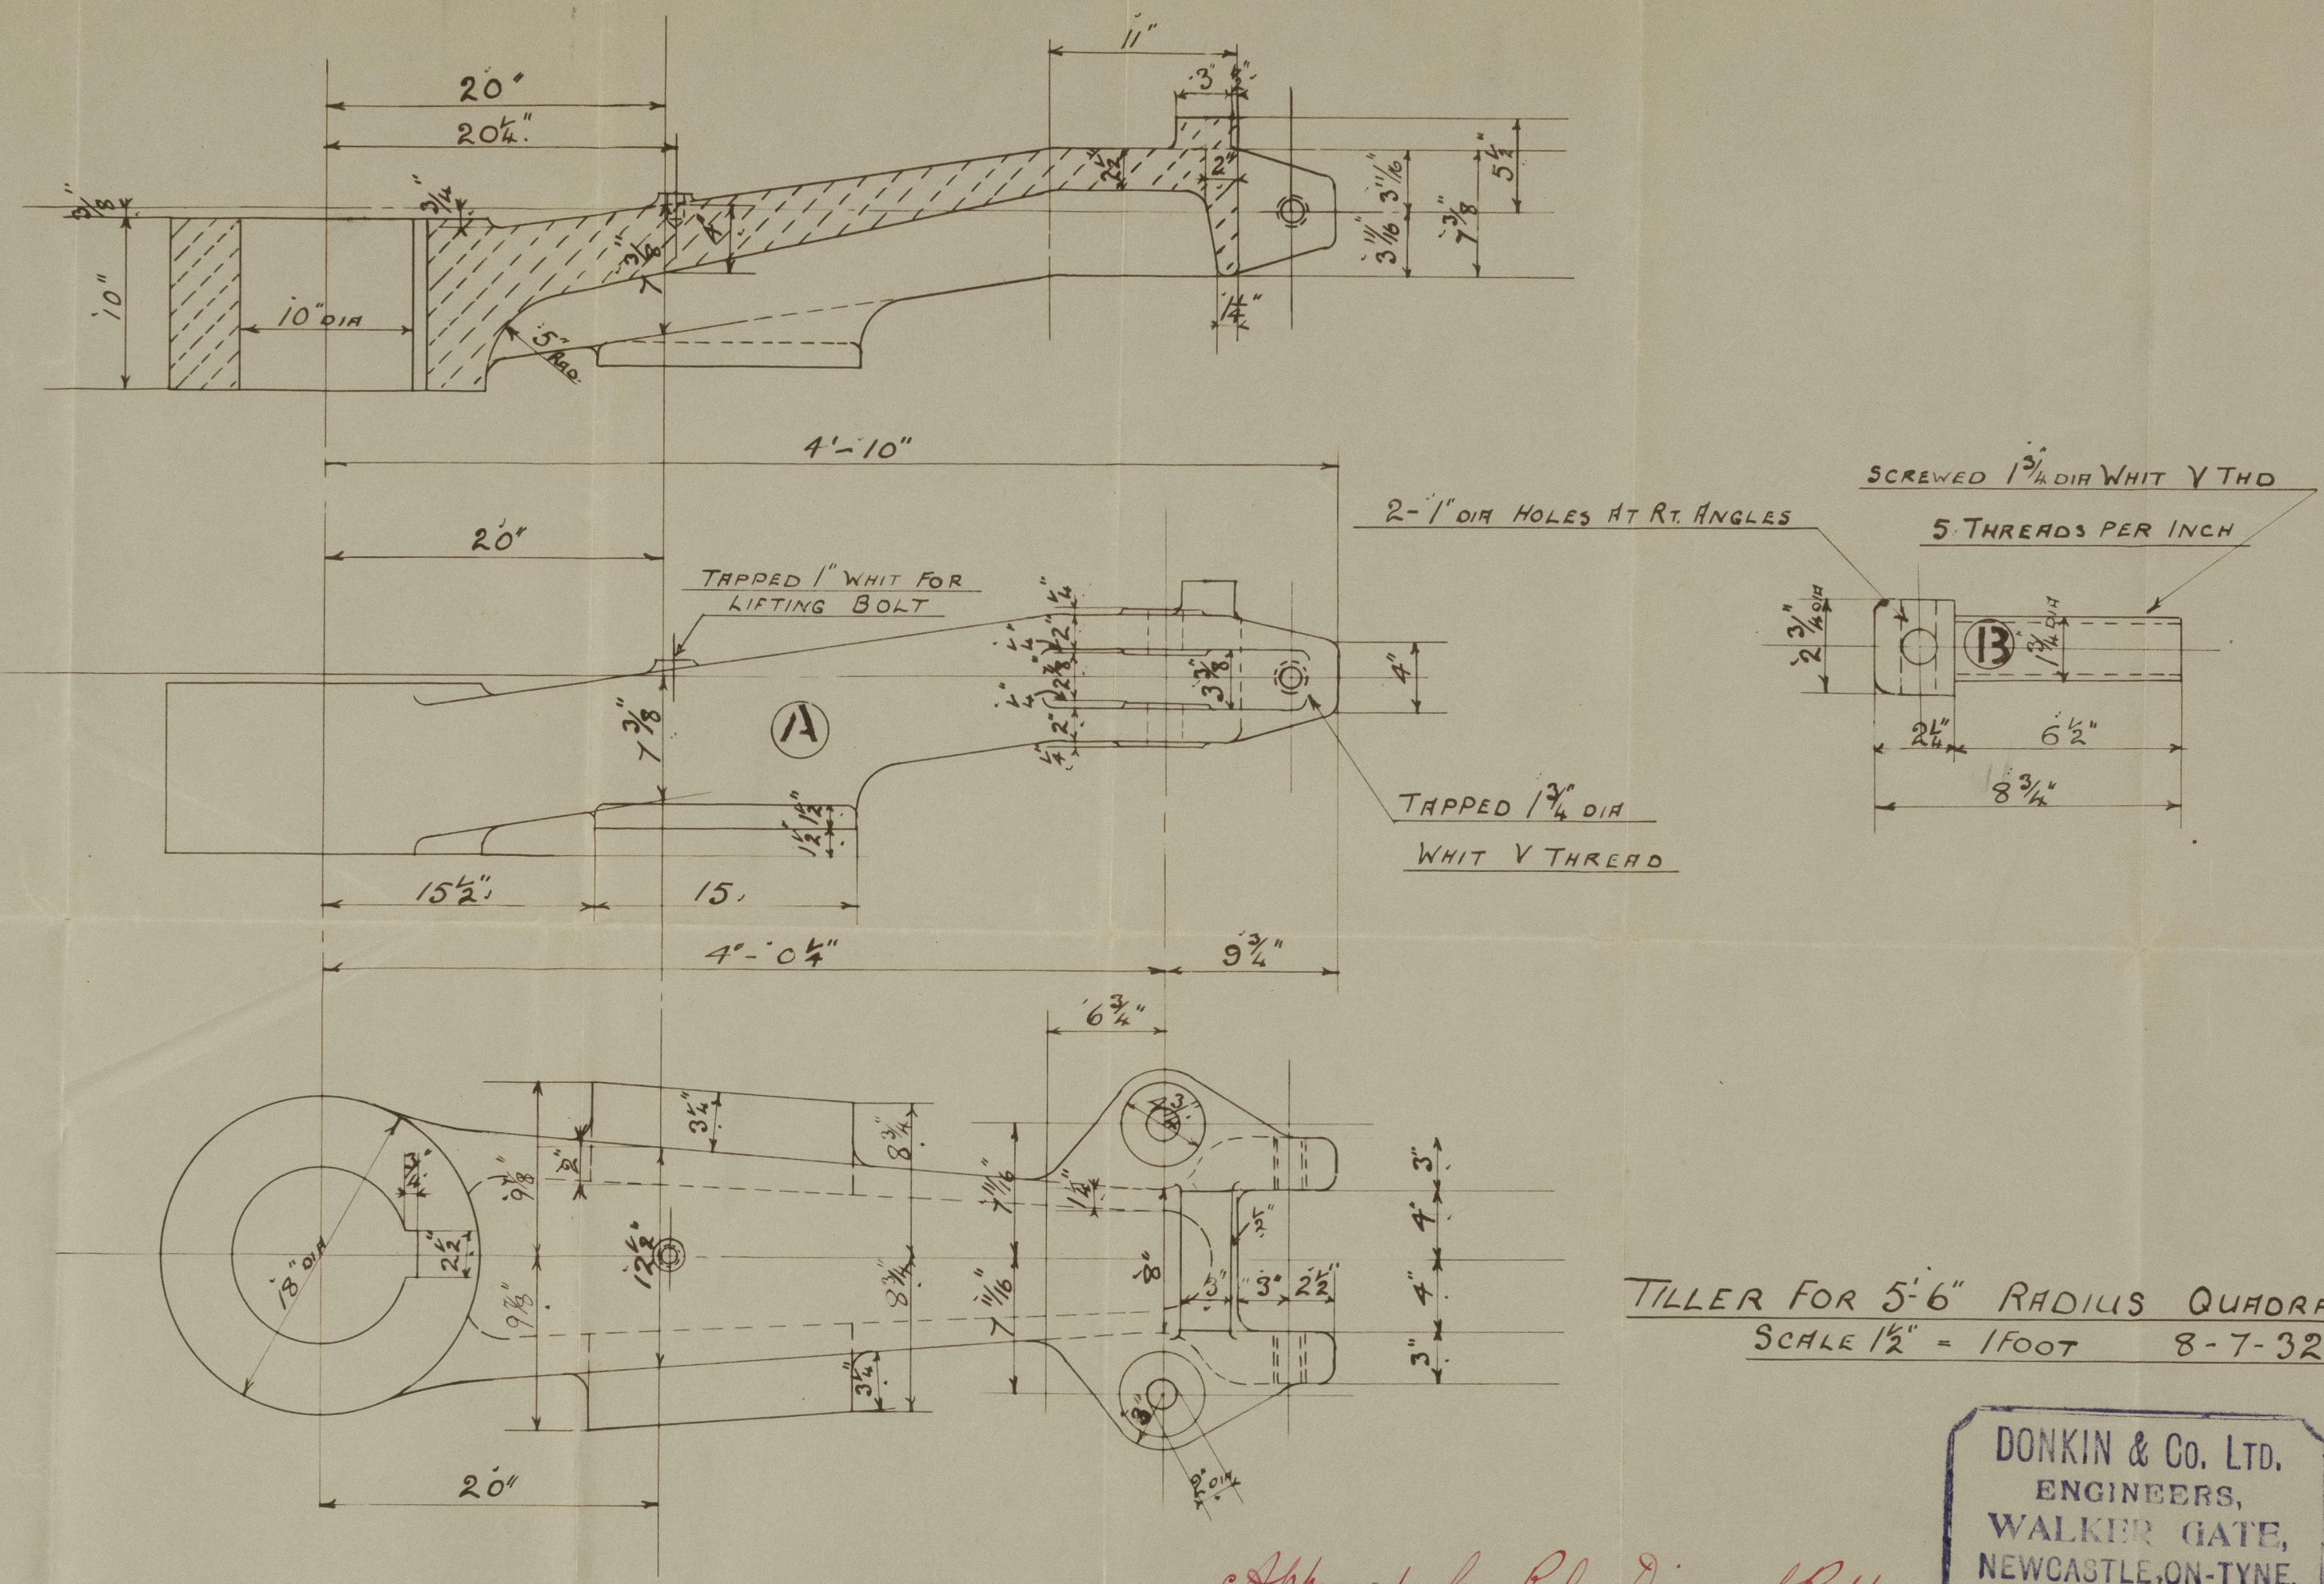

TILLER FOR 5'-6" RADIUS QUADRANT  
SCALE 1/2" = 1 FOOT 8-7-32

DONKIN & Co. LTD.  
ENGINEERS,  
WALKER GATE,  
NEWCASTLE-ON-TYNE.  
No. 44603 12/7/32

*Approved for Rule Diam. of Rudder*  
*Head = 10"*

DATE	Nº OFF	ORDER Nº	SHIP Nº	DATE REQº	SURVEY	DIA OF STOCK
12/7/32	ONE SET	9265	1056.	OCT/1932	LLOYDS.	10"

MARK	Nº OFF	DESCRIPTION	MATERIAL	WHERE OBº	PATTNº
A	ONE	TILLER	CAST STEEL	CASTING	ALT 4613
B	TWO	LOCKING SCREW	STEEL BAR	STORES	




W. Gray & Co.  
Norfolk Co.  
8/5 Boltonhall

Rudder Tiller

No 11

WEST HARTLEPOOL

Report No 17524.

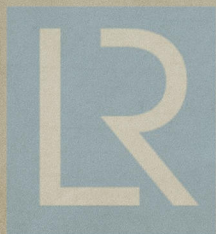

© 2020

Lloyd's Register  
Foundation

003832-003837-0072