


DIMENSIONS:- L.B.P. 415-0" x B.M.LD 57-9" x D.M.LD 33-0"

THE "BRACKETLESS SYSTEM" PATENT.

N.B.S. = NEW BRITISH STANDARD SECTION

MASTS, WINDLASS & WINCHES SUPPORTED  
TO SURVEYORS SATISFACTION

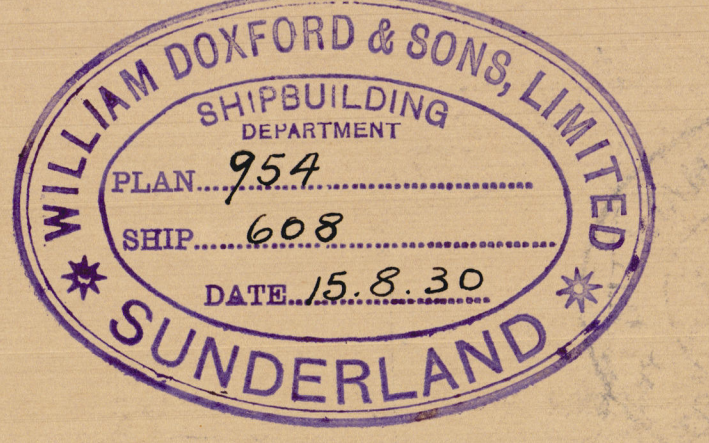



W. DOXFORD & SONS LD

PROFILE & DECKS (AS BUILT)

M/S. IMA (YARD N° 608)

SONDERLAND RPT. NO. 30440



© 2020

Lloyd's Register  
Foundation

003832-003837-0075