

38734 1 NOV 1946

Lloyd's Register of Shipping.

Ship's Name S.S. "RABAU" (Launched as H.M.S. "OXFORDNESS") Official No. 157809

Memorandum of alterations reported since ship was surveyed for assignment of Load Lines
in September, 1946.

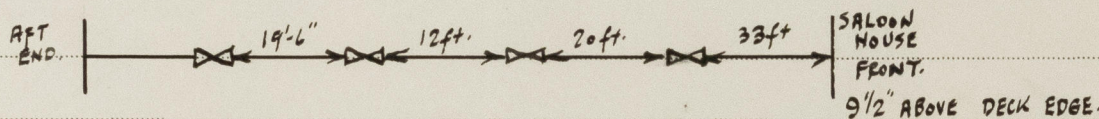
VENTILATORS - Freeboard Deck - 2 @ 8" dia. coaming 36"x.34 - To forepeak (forward) ✓
Top of Deckhouse - 1 @ 12" dia. coaming 30"x.34 - To tunnel. ✓
at Stern Wood plugs and canvas covers provided. ✓

AIR PIPES - Automatic "Varec" valves fitted at mouths of air pipes leading to
D.B. Tanks carrying Oil Fuel. ✓

FREEING ARRANGEMENTS -

Amended particulars -

Length	Height of Bulwark	Size	No.
Midships - 126 ft.	3'-6"	3'-0"x9"	3 ✓
		2'-3"x9"	1

HATCHWAYS -

Hatch Beams - Bearing Surface 3" on all Upper & Boat Dk. Hatchways ✓
Hatch Covers - 3" wood covers fitted. ✓

R. L. Scott.

SURVEYOR TO LLOYD'S REGISTER OF SHIPPING

Vancouver, B. C.

11th October, 1946.

T. Wood.
J. B. D.
31 NOV 1946
Added to C.H.

© 2020

Lloyd's Register
Foundation

003832-003837-0194