

Lloyd's Register of Shipping.

21 NOV 1946

Ship's Name S.S. "RABAUL" Official No. 157809

Memorandum of alterations reported since ship was surveyed for assignment of Load Lines in September, 1946.

CASING TOP:-

There are no Fiddley openings fitted on casing top.


VENTILATORS - Freeboard Deck - 2 @ 8" dia. coaming 36"x.34 - To forepeak *
(forward)
Top of Deckhouse - 1 @ 12" dia. coaming 30"x.34 - To tunnel. *
at Stern * Wood plugs and canvas covers provided.

AIR PIPES - Automatic "Varec" valves fitted at mouths of air pipes leading to
D.B. Tanks carrying Oil Fuel.

FREEING ARRANGEMENTS -

Amended particulars -

Length	Height of Bulwark	Size	No.
Midships - 126 ft.	3'-6"	3'-0" x 9"	3
		2'-3" x 9"	1

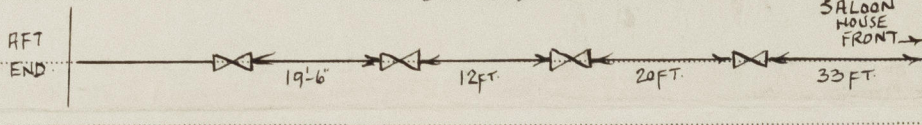

HATCHWAYS -

Hatch Beams - Bearing Surface 3" on all Upper & Boat Dk. Hatchways.
Hatch Covers - 3" Wood covers fitted.

R. H. Scott.

SURVEYOR TO LLOYD'S REGISTER OF SHIPPING

Vancouver, B. C.

22nd October, 1946.

Noted on C.11.
JSD
21 NOV 1946



© 2020

Lloyd's Register
Foundation

003832-003837-0195