


LEGEND

ROCK WOOL — [Symbol]

GRANULATED CORK — [Symbol]

CORK SLABS — [Symbol]

APPROVED
NOV. 20 1946
LOUIS REGISTER OF SHIPPING
NEW YORK
C. Mayhew

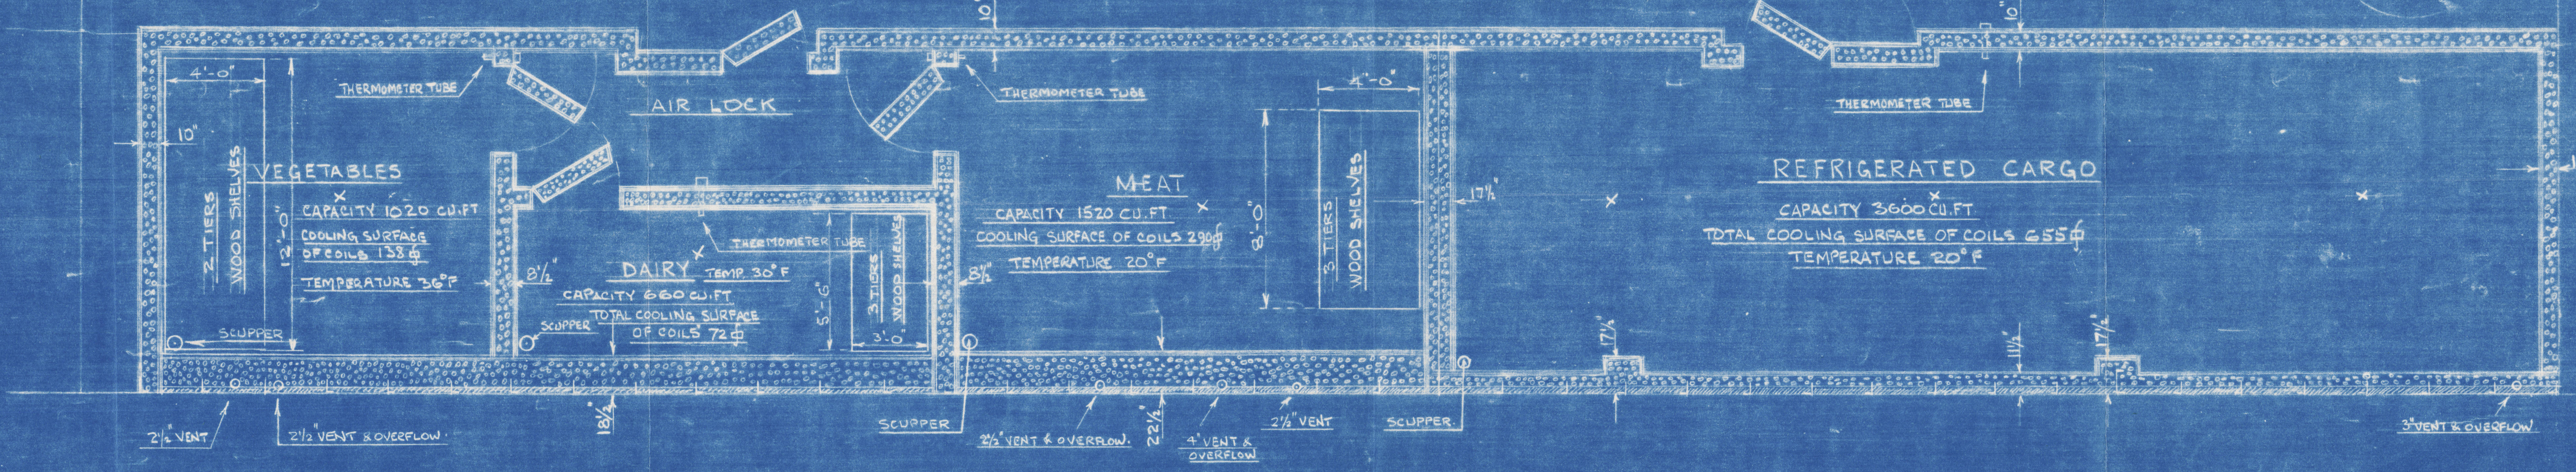

REVISED FOR HULL 164

NOV 5TH 1946. THERMOMETER TUBES INCREASED TO 2" DIA. INSIDE OF INSULATION

REVISIONS

NOV 1ST INSULATION INCREASED TO 1 1/2" AT SHELL PMS 67-28. CAPACITIES, COOLING SURFACES & TEMPERATURES ADDED.

SEPT 14TH 1946. POSITION OF DOOR IN DAIRY CHANGED. INSULATION ON EXTERIOR SIDES, ENDS & MECHS ADDED.

SEPT 30 1946. WOOD SHELVES ADDED TO DAIRY, VEGETABLE ROOM & MEAT ROOM.

West Coast Shipbuilders Ltd.

9000 TON CARGO VESSEL
INSULATION OF REFRIGERATED SPACES

DESIGNED	DRAWN	TRACED	CHECKED
	THOMAS		
APPROVED	REVISED	DATE	SCALE
		Aug. 21st 1946	1/4" = 1 FOOT

HULL No. 163-4

DWG. No. 163-53

NOTE: ALL WOOD SHELVES SIMILAR IN CONSTRUCTION TO MEAT ROOM SHELVES.
FOR DETAILS SEE DWG. NO. C 3 60

⑦

RECORDS DEPT.,
LONDON.

1

★ "Rabaul"

★ n/n Dongola.

Insulation of
refrigerated

spaces.



© 2020

Lloyd's Register
Foundation

003832-003837-0196