

MIDSHIP SECTION MOTOR COASTER

BAU N° 636

LENGTH OVER ALL 43,60 m
LENGTH BT. PP. 39,60 m
BEAM 7,15 m
DEPTH 2,90 m

CLASS: LLOYDS REG. 100 A1

$L:D = 14,84$
 $L:(B+D) = 12,98$
 $L:D = 15,65$

EQUIPMENT NUMBER 424,71

2 BOWER ANCHORS 725 kg
1 STREAM ANCHOR EX STOCK 115 kg
STUD CHAIN CABLES 300 m x 22 mm
1 STREAM ANCHOR WIRE 85 m x 57 mm CIRC.
1 TOWLINE (STEEL) 135 m x 57 mm
1 HAWSER (HEMP) 165 m x 102 mm

RIVETING:



DIAMETERS AND DISTANCES
ACCORDING TO LL. REG.
ALL BUTTS DOUBLE RIVETED
ALL SEAMS SINGLE

STEMS:

STERN POST 140 x 70 mm
STEM 145 x 29 mm

Modified cantlers which could be approved
for class 100 A.1. Coasting Service Great Britain
& Ireland also Continent, North Sea, Bordenau

SCALE 1:25

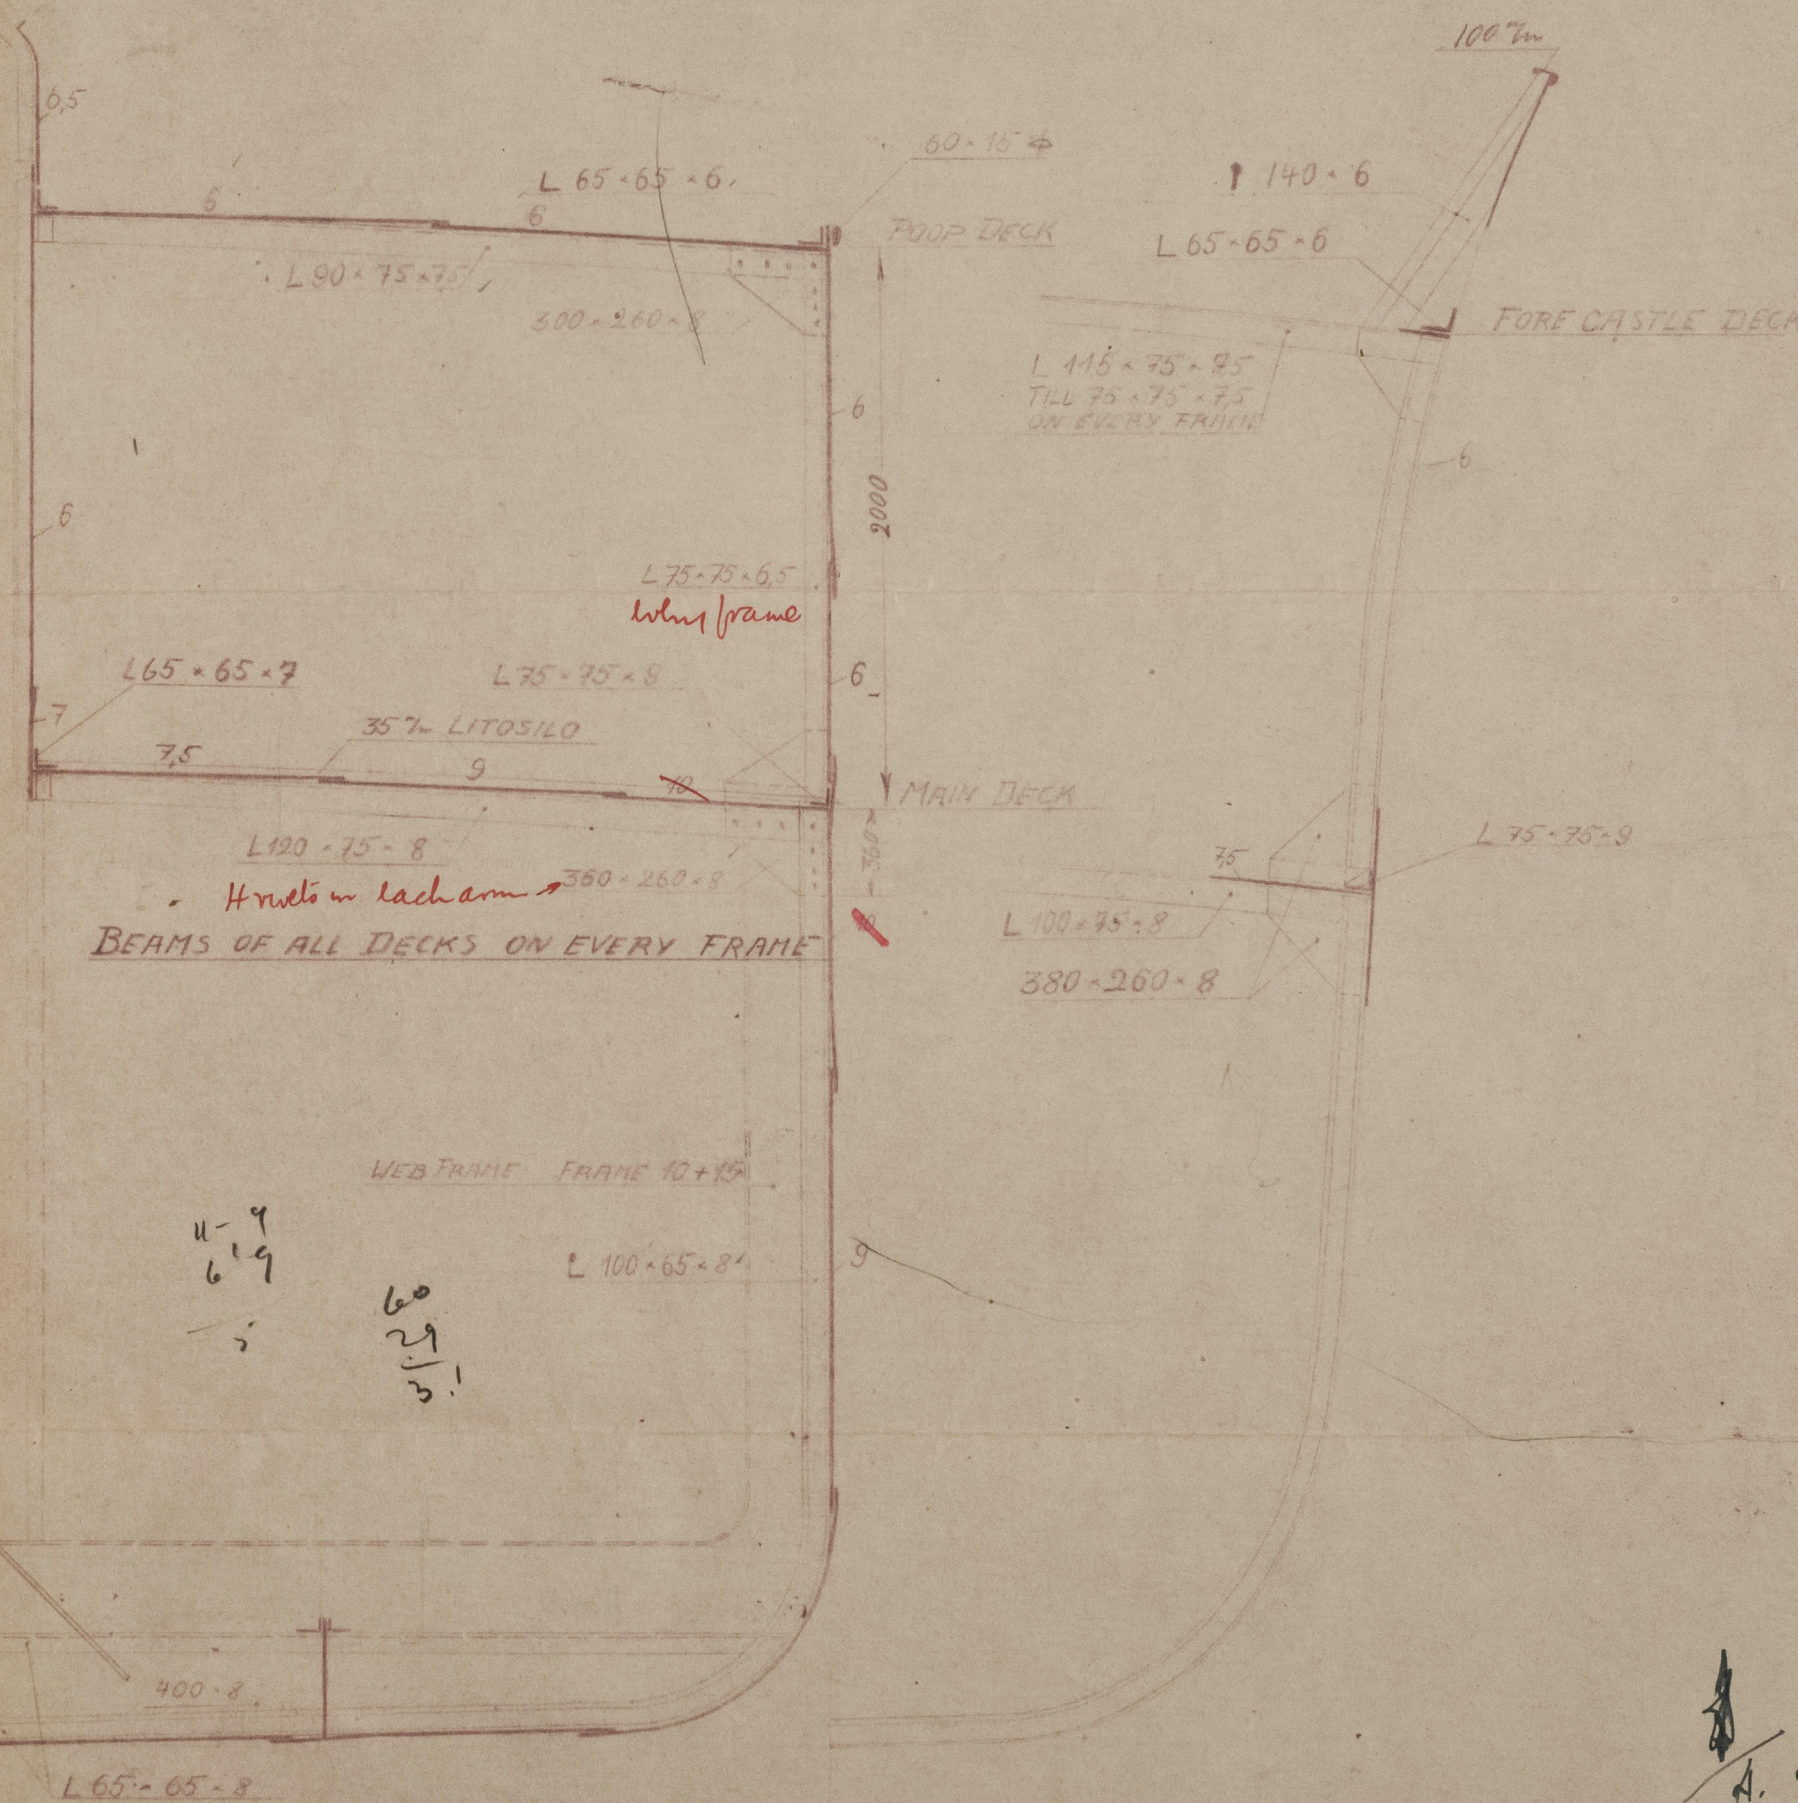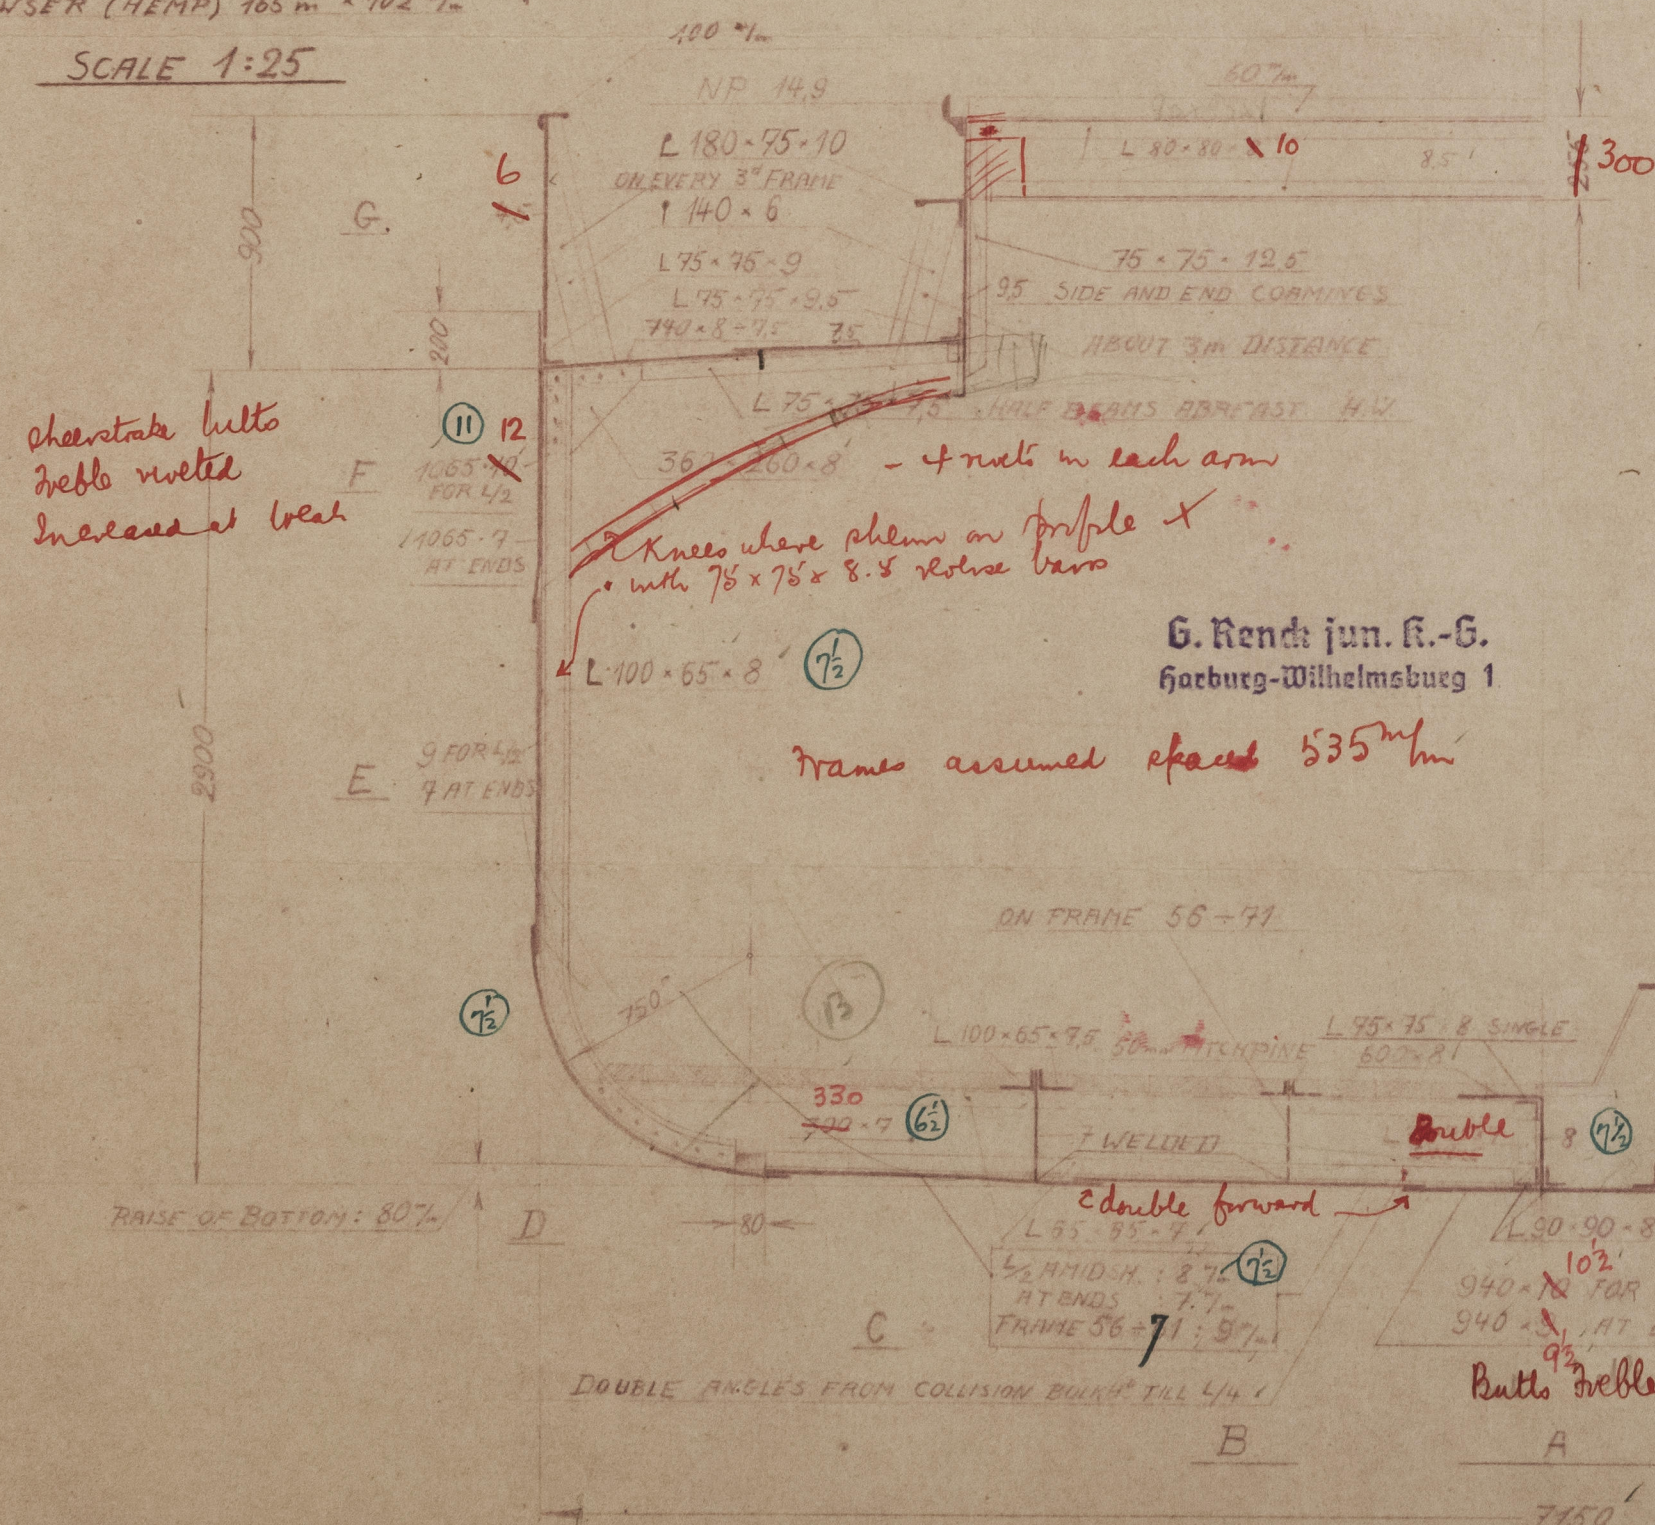

MIDSHIP SECTION
MOTOR COASTER

SCALE 1:25 BAU N° 636
G. RENCK JUN. R.-G.
HAMBURG-WILHELMSBURG
© 2021 Lloyd's Register Foundation

003838-003845-0062

Hamburg Report Nr. 22829

APANUI

③

Midship Section

Perick + Co.

Hamburg letter 22/7/37.

003838-003845-0062



© 2021

Lloyd's Register
Foundation