

18/3/30.

**N<sup>os</sup> 549 & 53**

# MIDSHIP SECTION.

SCALE 1/2" = 1 FOOT.

EQUIPMENT



1 STOCKLESS ANCHOR	8 1/2 CWTs
1 RODGERS	3/4 " EX. STOCK
120 FATHOMS	1 1/8" STUD LINK CABLE
60 "	6" HAWSER
60 "	5" WARP

DIMENSIONS:- 143'-7" BP x 24'-6" MLD x 14'-3" MLD

CLASS 100 A.1. STEEL STEAM TRAWLER.


LLOYDS NUMERALS.

L x D	2046.01
L x (B + D)	5563.72
D	14.25
B + D	38.75
$\frac{L}{B+D}$	10.07

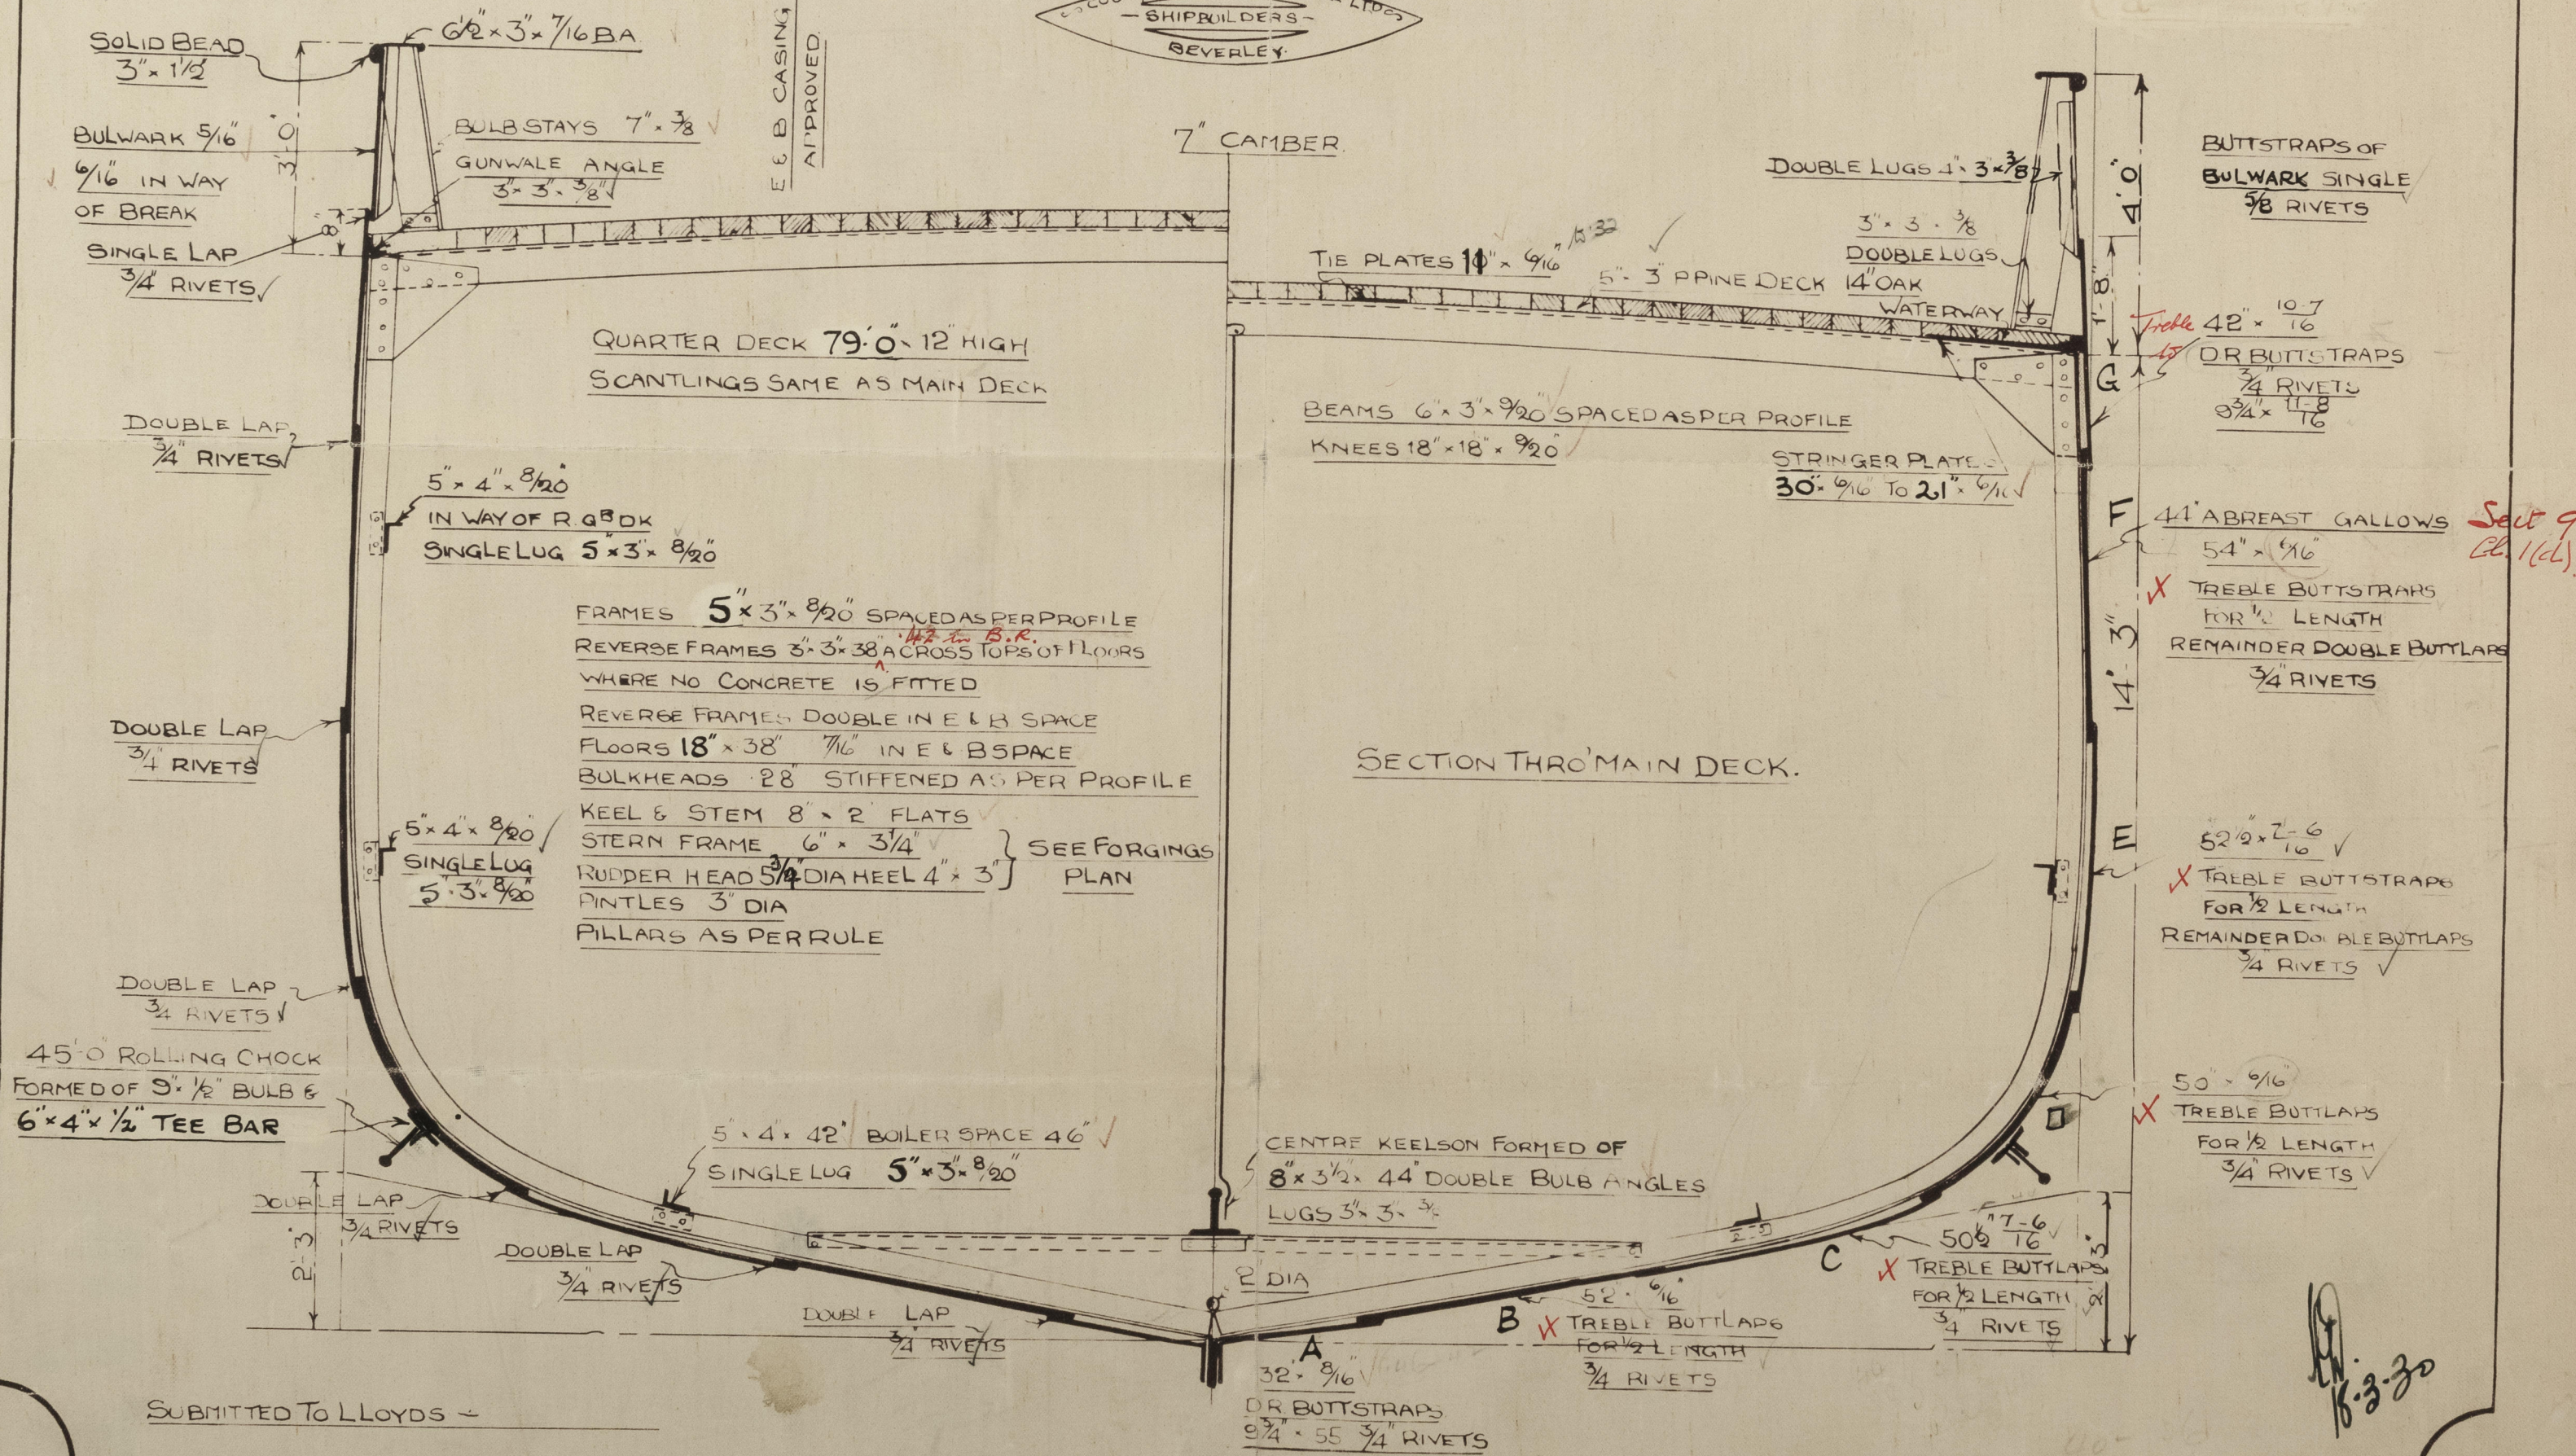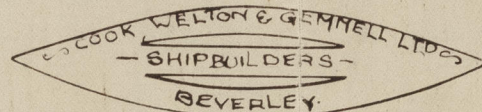

SUBMITTED TO LLOYDS -

APPROVED BY LLOYDS -

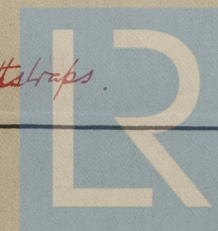

© 2021

Lloyd's Register Foundation

003958-003966-0023



Cook, Welton & Gummell, Ltd.  
Beverley

Middlelip Section  
Nos. 549 & 550

(No. 550)

8.8. "Welsbach" \*

HULL REPORT No. 41110

(No. 549)

8.8. "Ankwright"

HULL REPORT No. 41190.