



N<sup>OS</sup> 549 & 50.

DIMS:-  $143'-7'' \text{ B.P.} \times 24'-6'' \text{ B.MLO} \times 14'-3'' \text{ D.MLO.}$

SCALE  $\frac{1}{4}" = 1 \text{ FOOT.}$  ✓

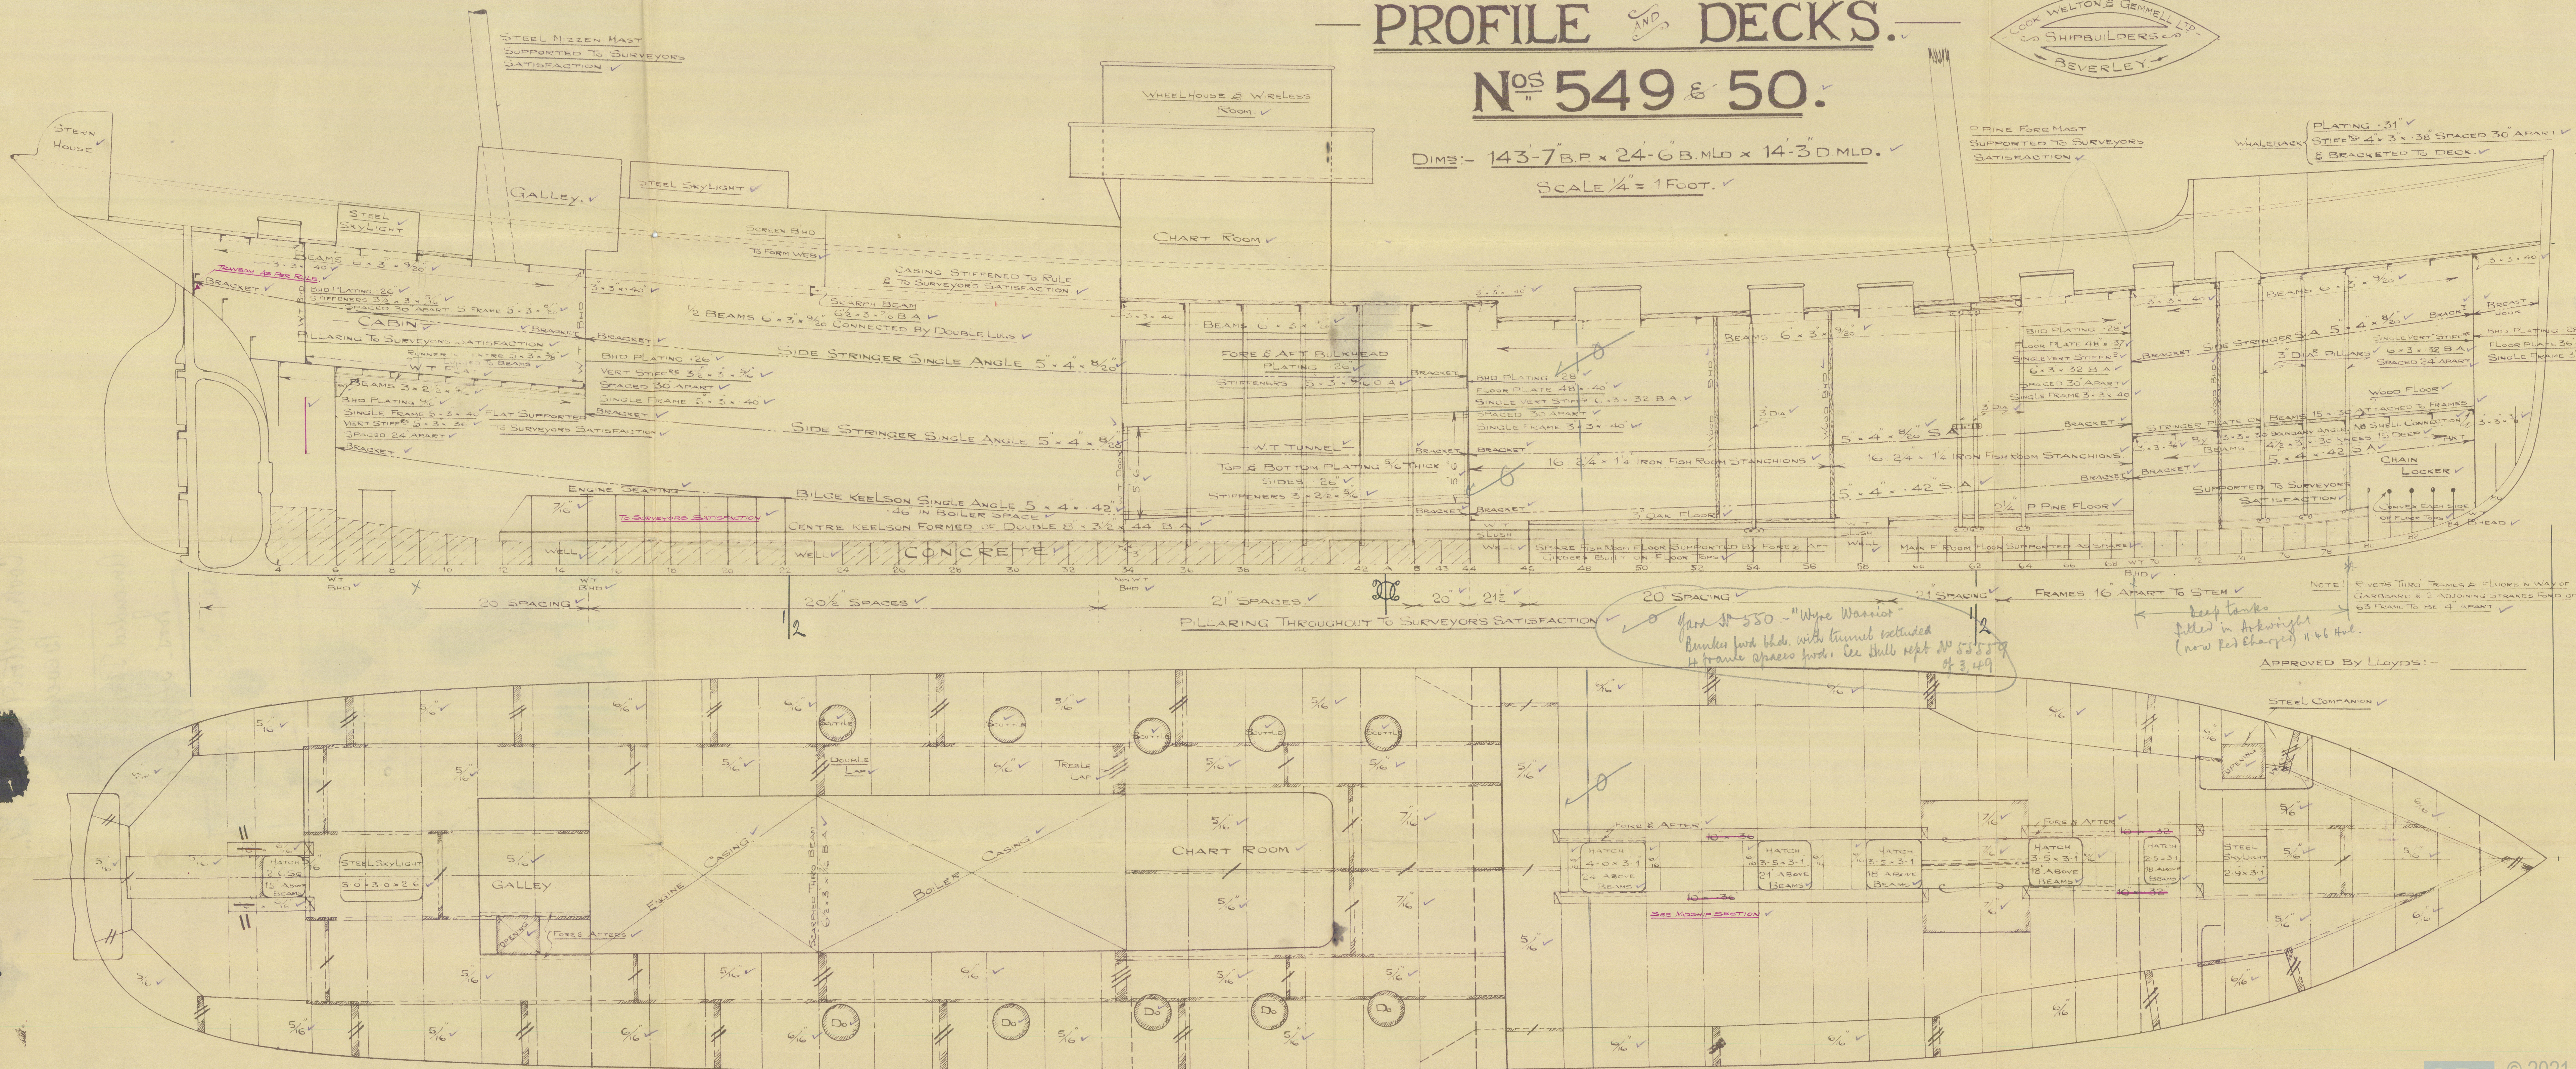

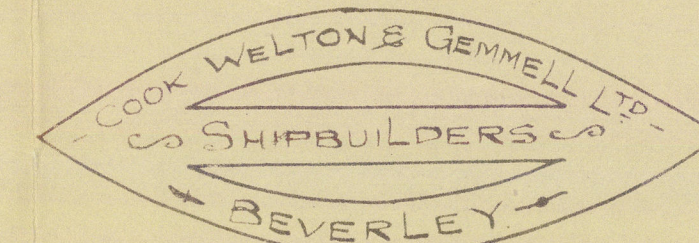

Cook, Welton & Gemmell, Ltd..  
Beverley

Amended Profile & Deck.  
Nos. 549-50

8.S. "Welsbach" (No. 550)  
HULL REPORT No. 41110

8.S. "Inkwright" (No. 549)  
HULL REPORT No. 41190