

Lloyd's Register of Shipping.

SURVEYS FOR FREEBOARD.

(CONDITIONS OF ASSIGNMENT.)

Ship's Name

~~Forsberg~~ NESTE

Port of Survey

Rotterdam

Official Number

Surveyor's Signature

J. H. J. Hoff


Nationality and Port of Registry

Norwegian Farsund

Date of Survey

9 - 10 - 11 - 12 / 4 1940.

Disposition and dimensions of superstructures, trunks, deckhouses and machinery casings to be inserted in the diagrams and tabular statement: -

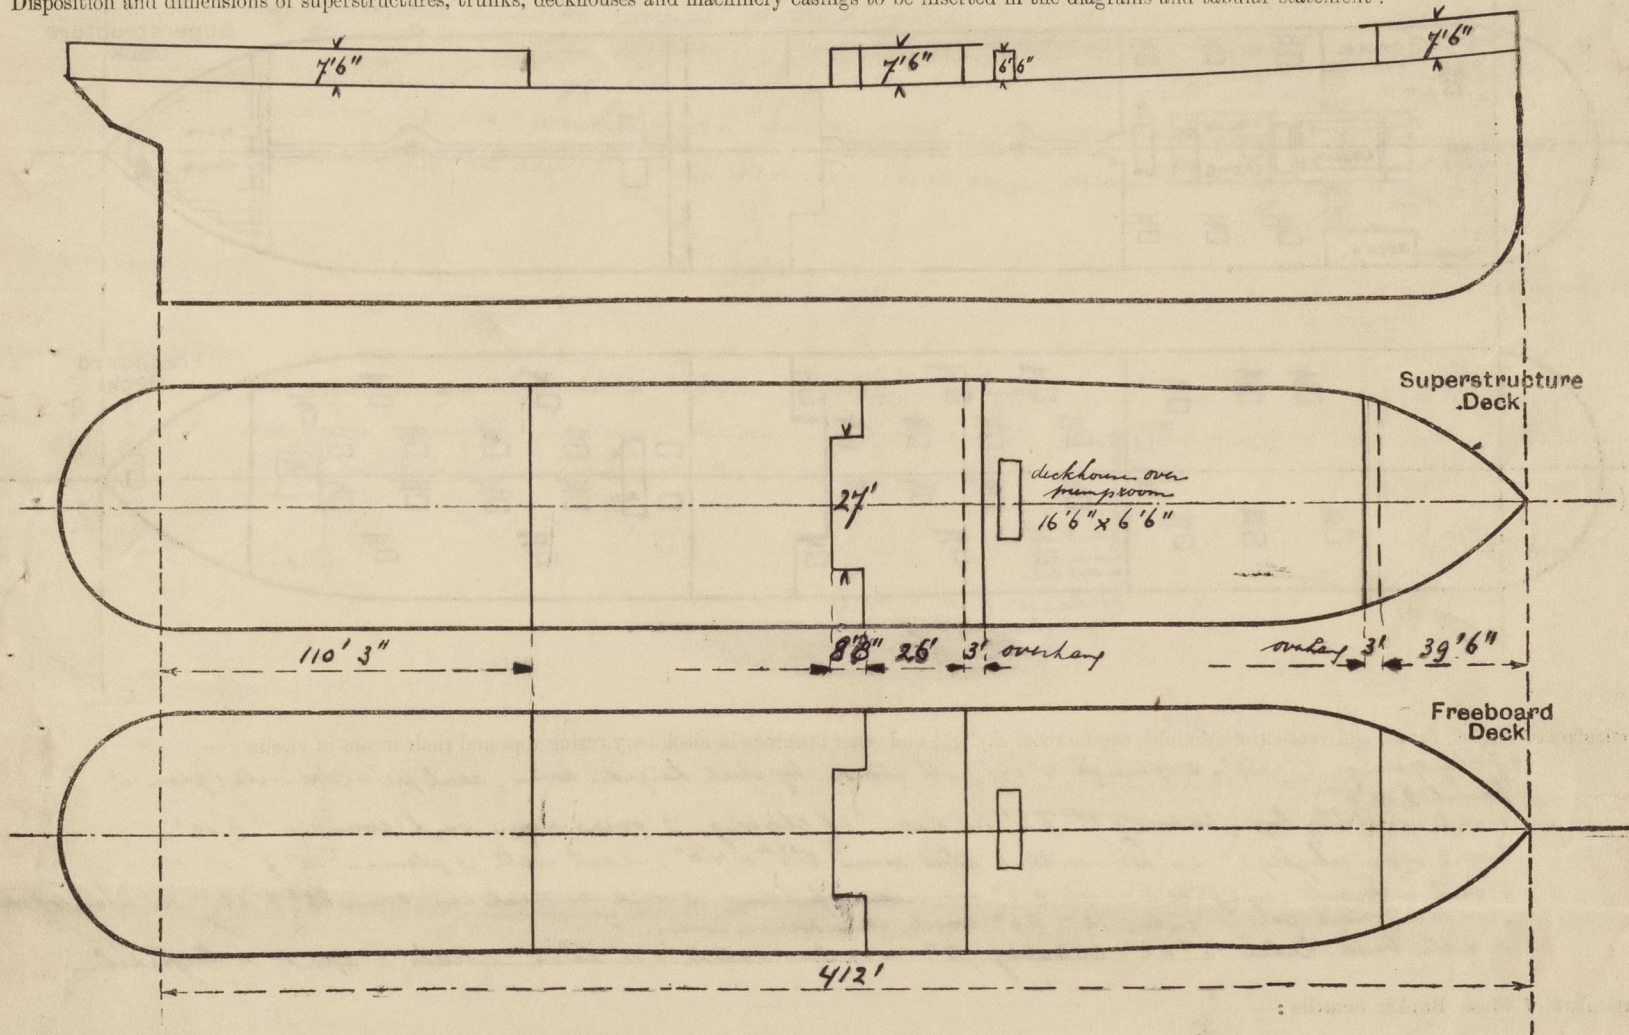

Particulars of Superstructures, Trunks, Casings, Deckhouses.

	Coaming	Plating	Stiffeners	Spacing	End Attachments of Stiffeners	Size of Openings	Height of Sills	Height of Casings
Poop Bulkhead ...	7/16"	7/16"	longitudinal L 6 x 8 x 1/2	30"	flanged plate transverse 18" x 1/2 spaced 6' 6"	5' x 2' 2"	19"	7' 6"
Bridge, After Bulkhead ...	3/8"	3/8"	2 long bulkhead long. L 6 x 8 x 1/2 Hollowed 6' x 2 1/2 x 116 L	30"	L transverse 10 x 5 1/2 x 1/2 flanged plate transverse 21" x 1/2	4' 9" x 5' 1"	22"	7' 6"
Bridge, Forward Bulkhead ...	7/16"	7/16"	2 1/2" webs 19' 7 1/2 x 2 1/2 + 3 long bulkh	30"	flanged plate transverse 21" x 1/2 attached to long beams	5' x 2' 2"	18"	7' 6"
Exposed Machinery Casings on Superstructure Decks ...	3/8"	3/8"	1/2" stiff L 3 x 3 x 1/2"	34"	bracket top	5' x 2' 2"	15"	12' 6"

Particulars of Closing Appliances (state if capable of being manipulated from both sides).

Poop Bulkhead ...	2 w.t. steel doors, operated from both sides.
Raised Quarter Deck Bulkhead ...	1/2"
Bridge, After Bulkhead ...	2 openings with wooden board in riveted channels.
Bridge, Forward Bulkhead ...	1 w.t. steel door, operated from both sides.
Forecastle Bulkhead ...	3 w.t. steel doors and 1 wood door, operated from both sides
Exposed Machinery Casings on Freeboard or Raised Quarter Decks ...	1/2"
Exposed Machinery Casings on Superstructure Decks ...	4 steel doors, operated from both sides (1 port & 1 starb) (2 in fwdly & 2 in aftly room casing)
Machinery Casings within Superstructures not fitted with Class I Closing Appliances ...	1/2"
Deckhouses on Flush Deck Ships ...	1/2"

PARTICULARS OF PROTECTION TO OPENINGS, ETC.

		HATCHWAYS ON FREEBOARD AND SUPERSTRUCTURE DECKS.									
		I	II	III	IV	V	VI	VII	VIII	IX	X
Description of Hatchway		forepeak	forehold	forward pump room	main tank hatches	summer tank hatches	inside prop aft	2 hatches inside prop	2 hatches on bunkers	6 hatches on poop deck	1 hatch on poop deck
Dimensions of Hatchway		5' x 3'	11'6" x 9'9"	4'6" x 3'6"	6' x 4'	6' x 4'	6' x 3'4"	6' x 3'	4' x 4'	6' x 2'8"	12' x 5'6"
COAMINGS	Height above Deck	30"	30"	30"	8"	3'6"	3"	24"	24"	30"	30"
	Thickness	1/2"	1/2"	1/2"	1/2"	1/2"	1/2"	1/2"	1/2"	1/2"	1/2"
	Stiffeners	—	2 7 x 3 1/2 x 1/2	—	—	—	—	—	—	—	2 7 x 3 1/2 x 1/2
	Brackets, Stays	—	Subsidiary	—	—	—	—	—	—	—	—
HATCH BEAMS	Number	/	/	/	/	/	/	/	/	/	/
	Spacing	/	/	/	/	/	/	/	/	/	/
FORE AND AFTERS	Number	/	/	/	/	/	/	/	/	/	/
	Spacing	/	/	/	/	/	/	/	/	/	/
HATCH COVERS	Material	wood	bolled steel	sheep plate	hinged steel	hinged steel	bolled steel	hinged steel	hinged steel	wood	wood
	Thickness	3"	1/2" thick	1/2" thick	1/2" thick	1/2" thick	1/2" thick	1/2" thick	1/2" thick	3"	3"
HATCH COVERS	How fitted	—	4 stiffeners	4 stiffeners	2 x 3 x 1/2	2 x 3 x 1/2	4 x 3 x 1/2	1 stiff	with 2 stiff	—	—
	Bearing Surface	3"	6 x 3 1/2 x 1/2	6 x 3 1/2 x 1/2	2 x 3 x 1/2	2 x 3 x 1/2	4 x 3 x 1/2	1 stiff	with 2 stiff	—	—
Spacing of Cleats		18"	/	10 toggles	10 toggles	10 toggles	10 toggles	10 toggles	8 toggles	2'	2'
Number of Tarpaulins		two	/	10 toggles	10 toggles	10 toggles	10 toggles	10 toggles	8 toggles	two	two

*Are wood fore and afters steel shod at all bearing surfaces? ☒ Yes

Are battens and wedges efficient and in good condition? ☒ Yes

Are tarpaulins in good condition and in accordance with rule requirements? ☒ Yes

Are lashings provided in accordance with rule requirements? ☒ Yes

Particulars of any special features:—

A displacement scale has been attached.

Endorsement at first survey and at surveys for renewal of Certificate:—

The fittings and appliances are in accordance with the particulars shown on this form (or as now modified) and are in good condition.



© 2021

Lloyd's Register Foundation