


SCALE : 1/2" TO 1 FOOT

7 APR 1952

(AS FITTED)



LLOYDS NUMERALS

$L \times D$	2635
D	15.5
$L \times (B+D)$	7650
$B+D$	45
L/D	10.83
L/B	6.03
d	13.92

EQUIPMENT

1 STOCKLESS ANCHOR	12 CWTs
1 STOCKLESS ANCHOR	11 CWTs
1 RODGERS ANCHOR	4 1/2 CWTs (EX STOCK)
150 FATHOMS 1 1/4" STUD LINK CABLE	ALTERNATIVELY 2-60 FATHS OF 4" COMBINATION WIRE
60 FATHOMS 6" HAWSER	BREAKING STRAIN NOT LESS THAN 8.3 TONS AS PREVIOUSLY APPROVED
60 FATHOMS 6" WARP	

VESSEL TO BE BUILT TO LLOYD'S CLASS


100 A.I. ✕ STEAM TRAWLER

SCANTLINGS


FRAMES 5'x3'x 38" B.A. SPACED AS SHOWN ON PROFILE
REVERSE FRAMES 3'x3'x 38"
NO REVERSE FRAMES WHERE CONCRETE IS FITTED
REVERSE FRAMES DOUBLE IN ENGINE & BOILER SPACE
REVERSE FRAMES 42" IN BOILER ROOM
FLOORS 19" x 40" TO 44" IN E. & B. SPACE
KEEL AND STEM 8'x2' FLAT BAR
STEM ABOVE WATERLINE IS OF PLATE CONSTRUCTION
STEMPOST - SEE STEMFRAME & RUDDER PLAN

SUBMITTED TO LLOYDS :-

APPROVED BY LLOYDS :-

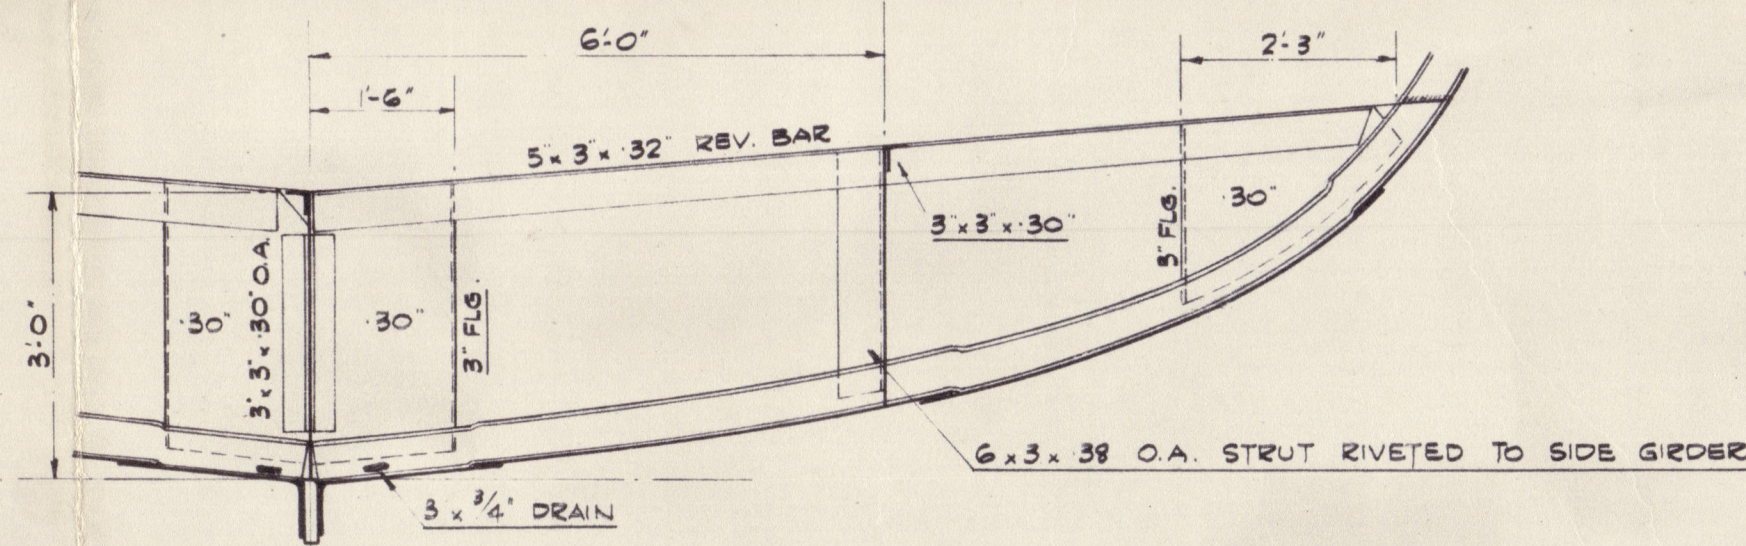


SECTION THRO' DOUBLE BOTTOM
SHOWING SKELETON FLOOR

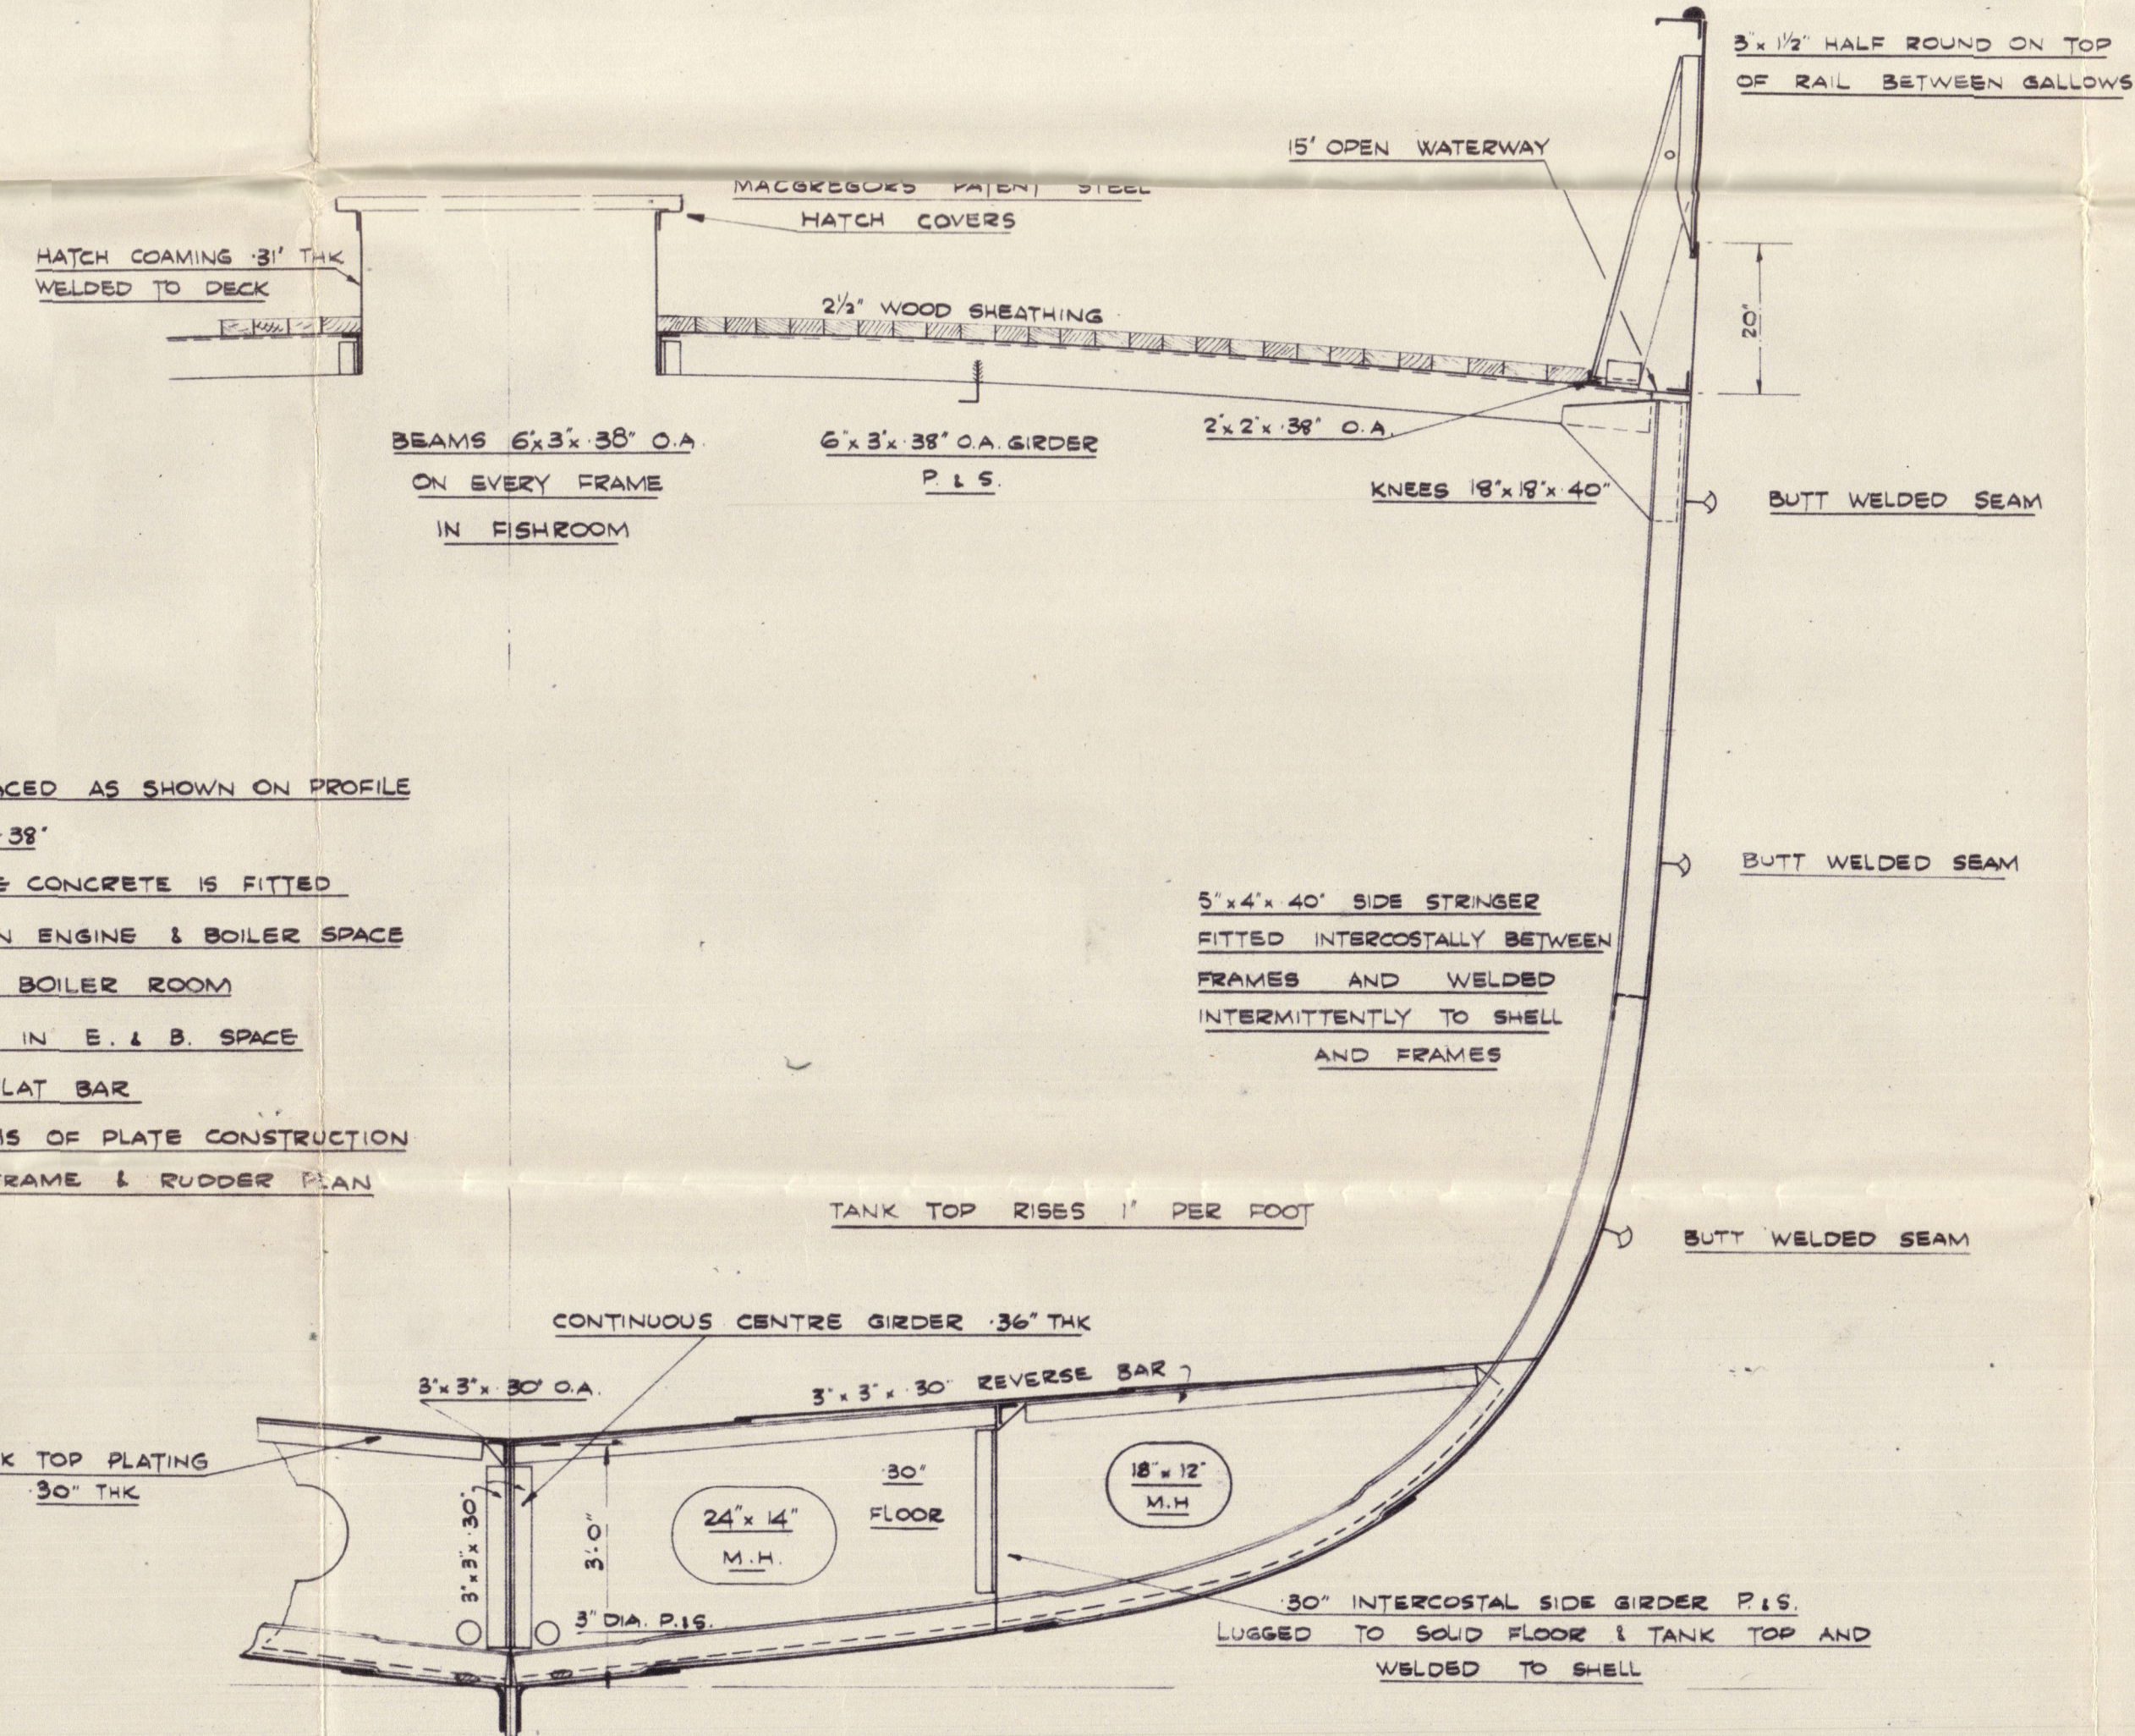

SECTION THROUGH FISHROOM

SHOWING SOLID FLOOR IN D. BOTTOM

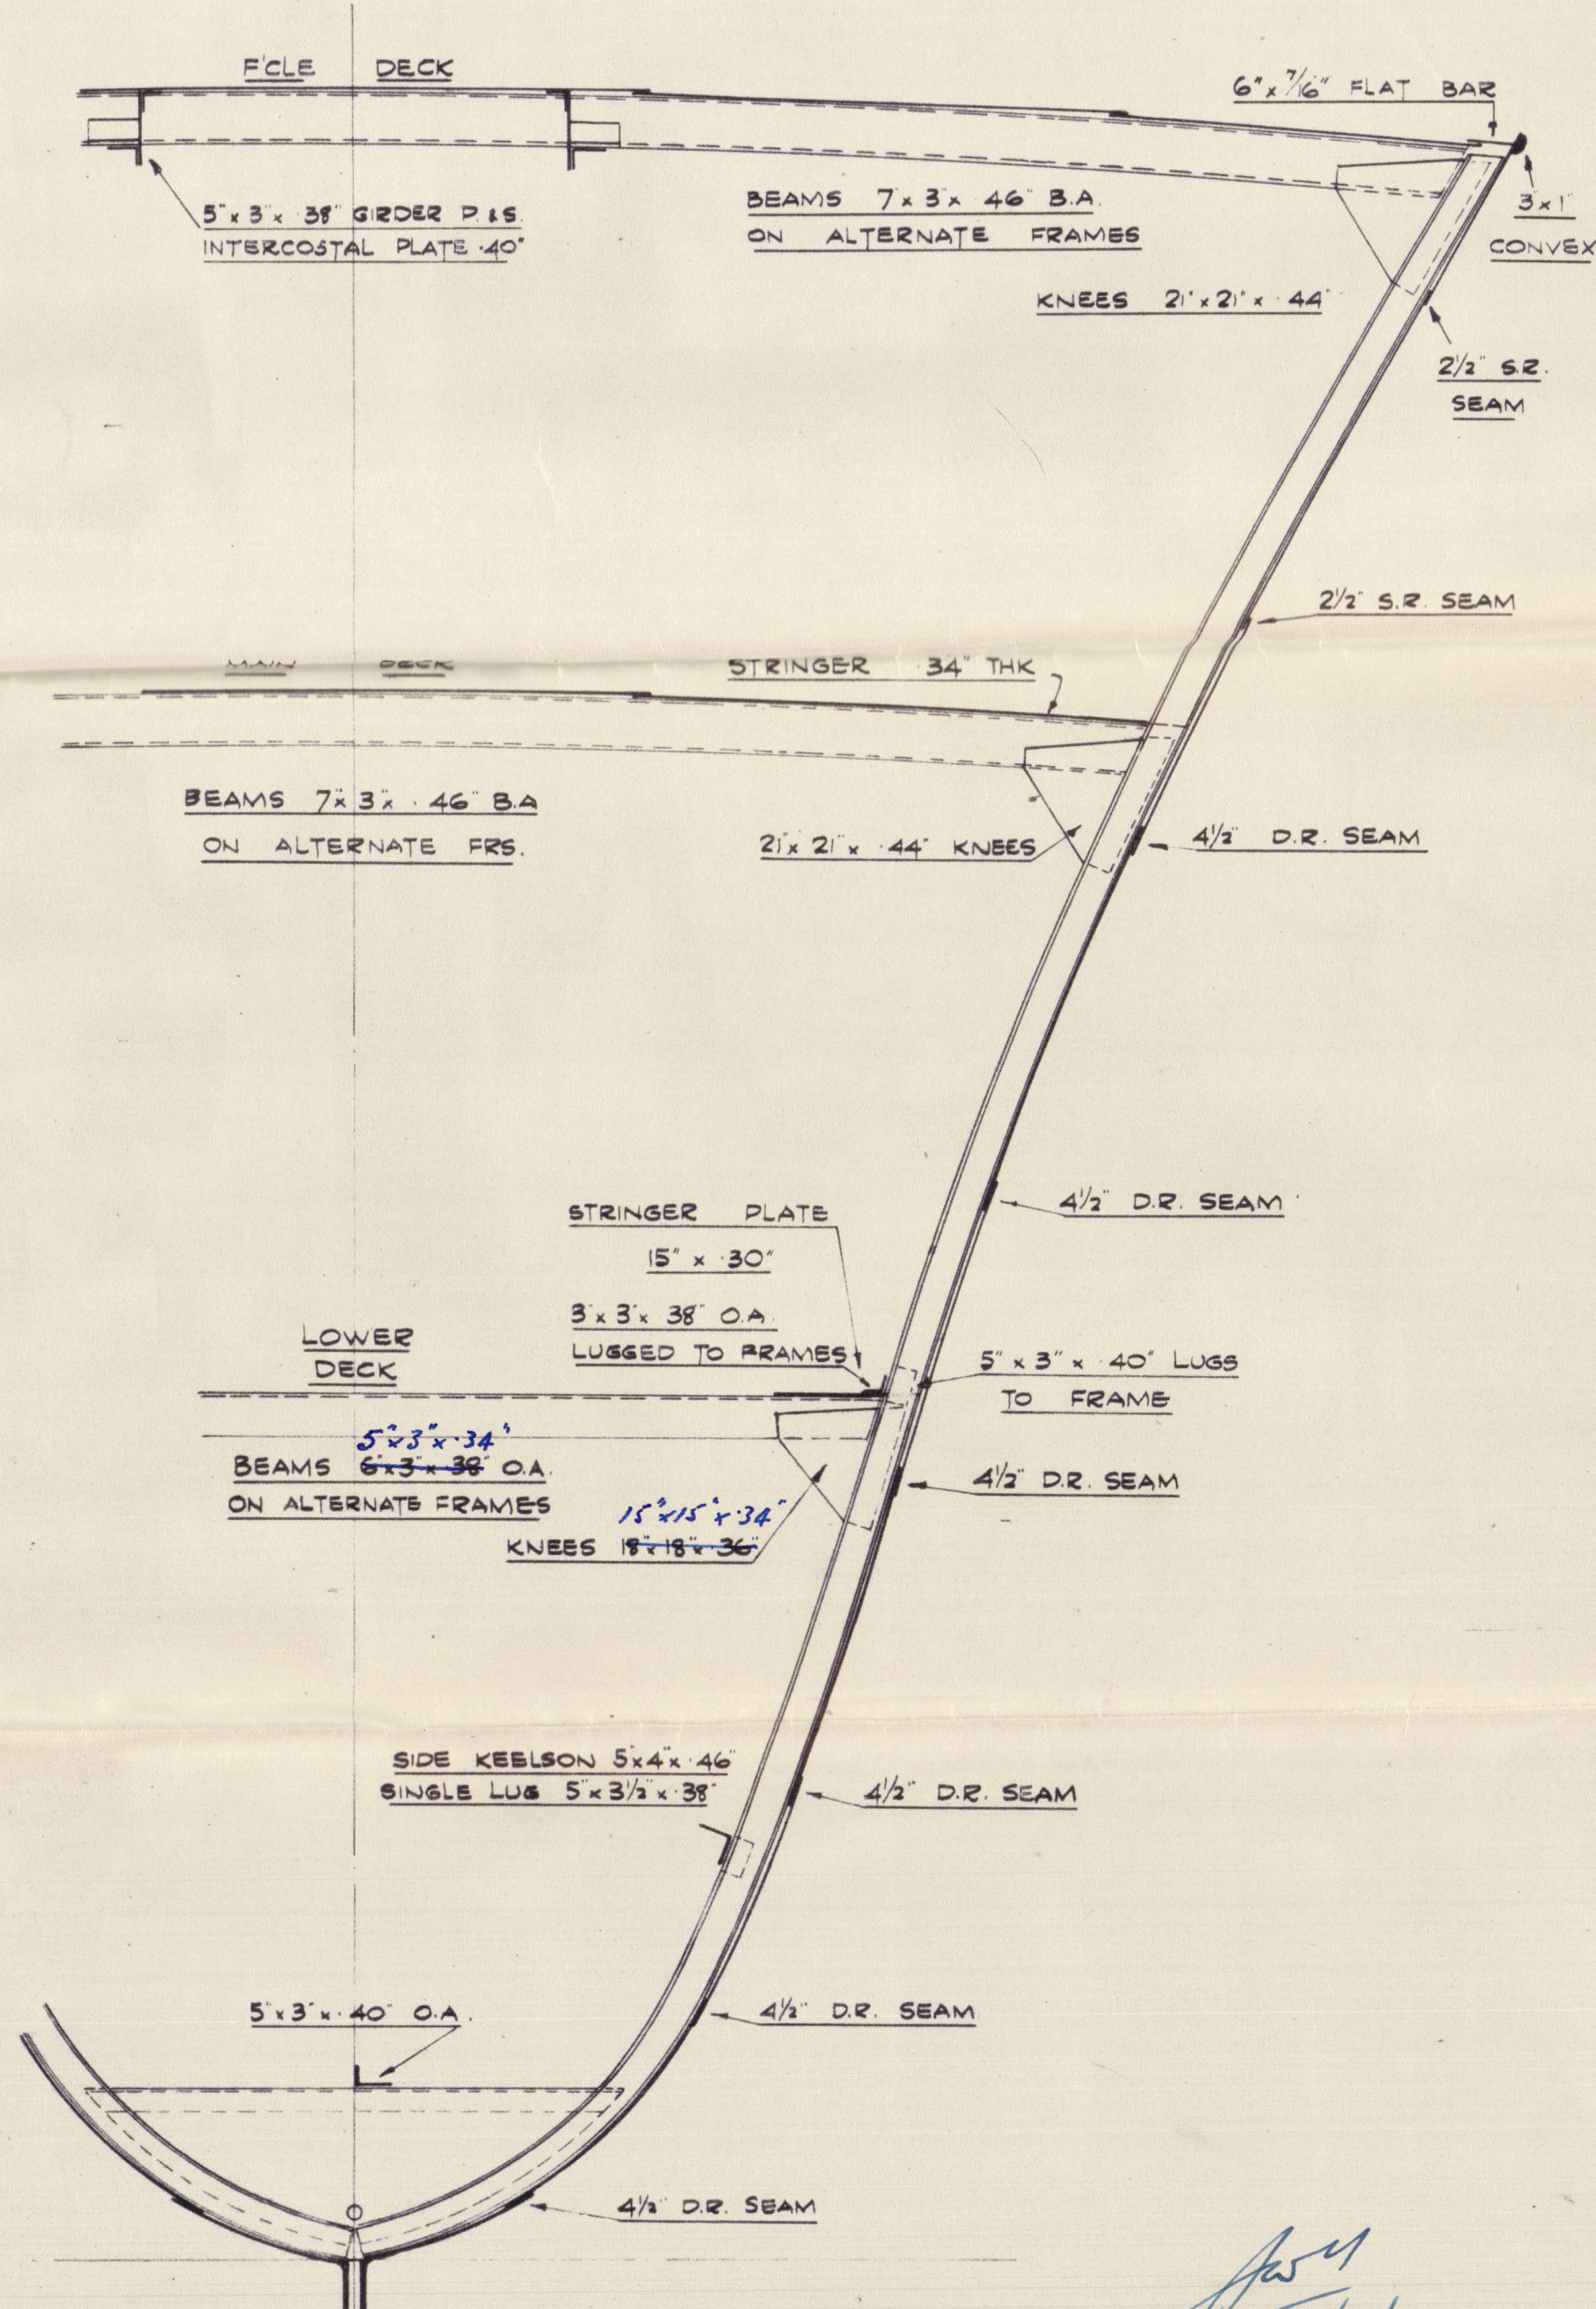


SECTION IN WAY OF FILE DECK

COOK, WELTON & GEMMELL LTD
SHIPBUILDERS
BEVERLEY

ERLEY
Lloyd's Register
Foundation

003867-003874-0022


S. BATHOLOMEW 

COOK WELTON & CEMMELL

YARD No 865

HULL V.E. REPORT No 59392

RECORDS DEPT
LONDON

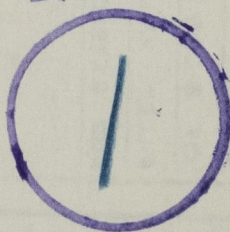

STRUCTURAL SECTIONS


(as fitted)

RETAIN

© 2020

Lloyd's Register
Foundation

003867-003874-0022

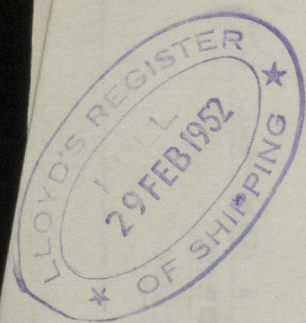

© 2020

Lloyd's Register
Foundation