
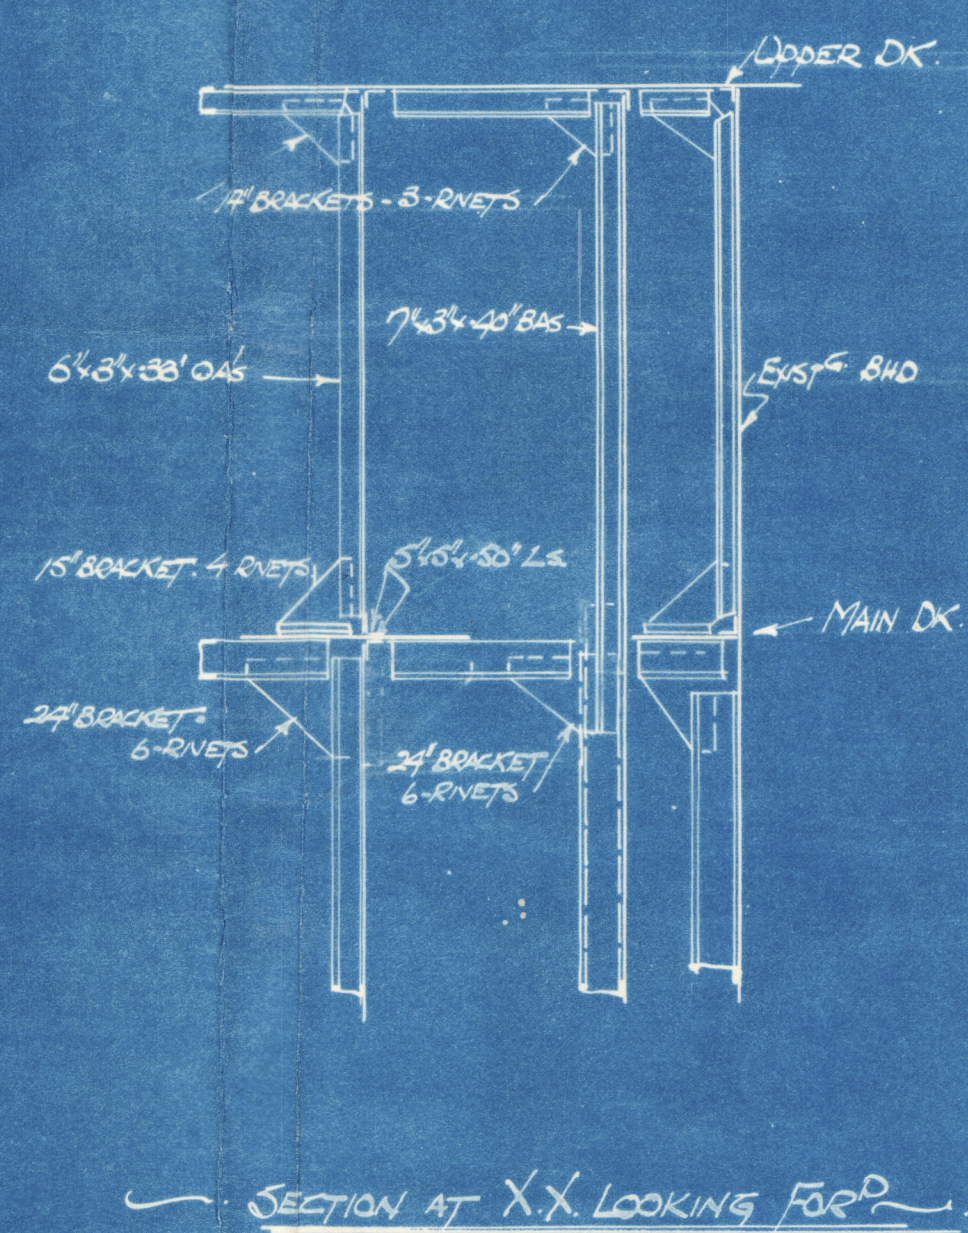
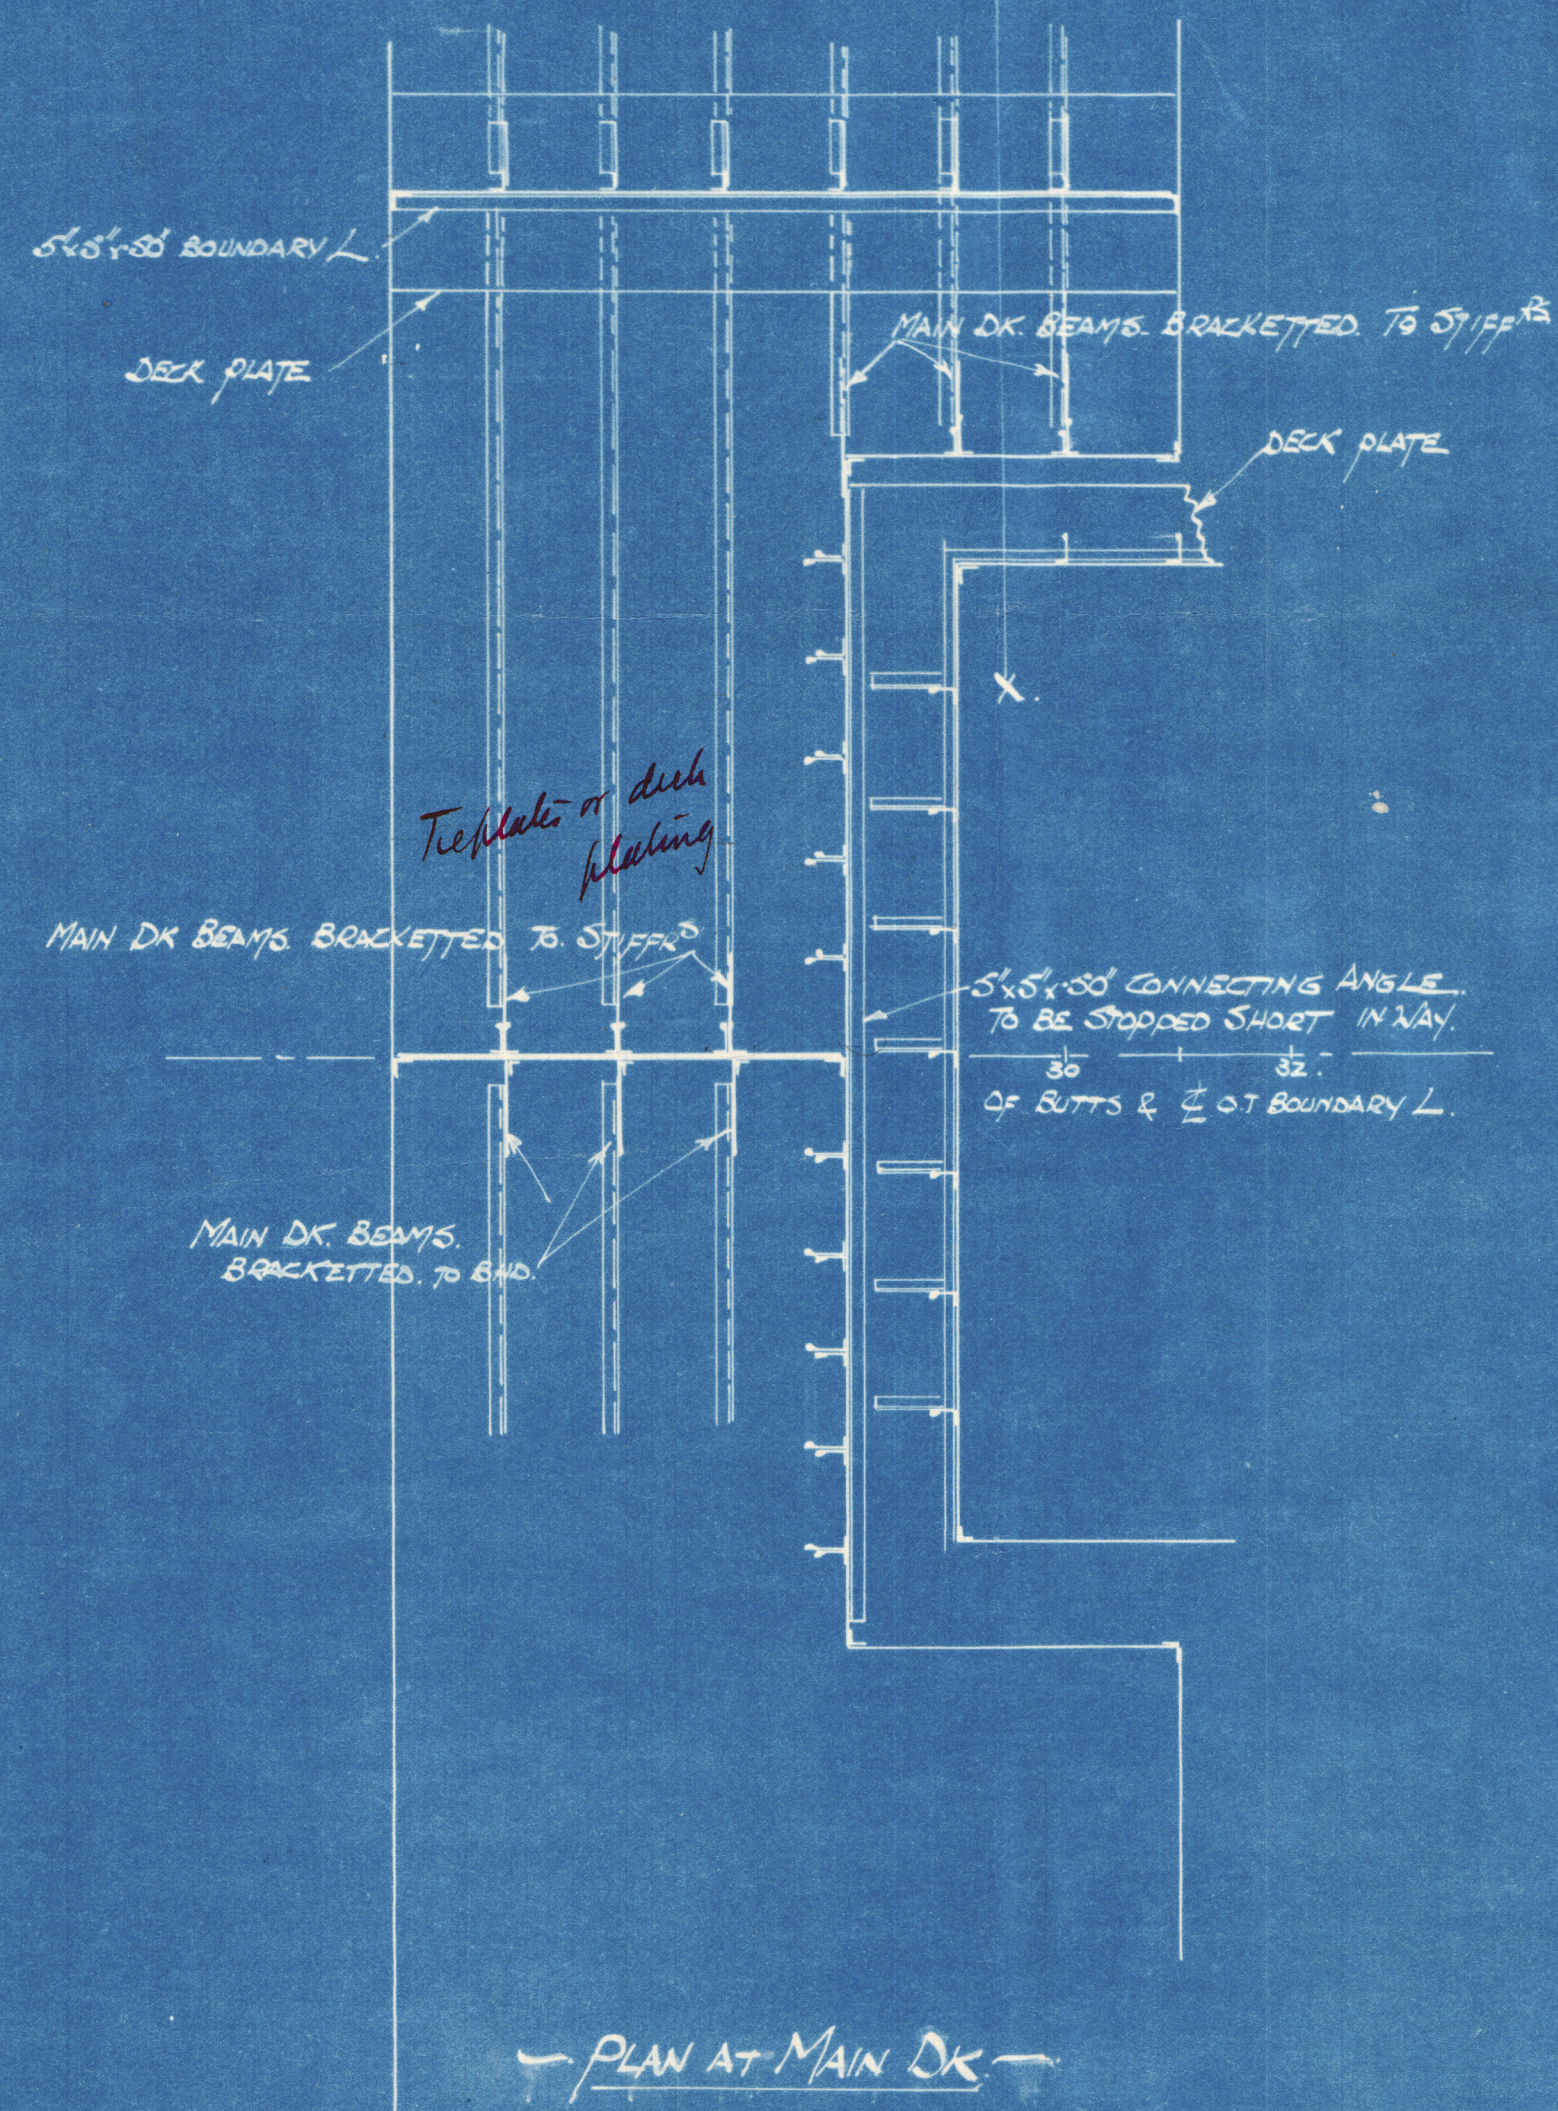
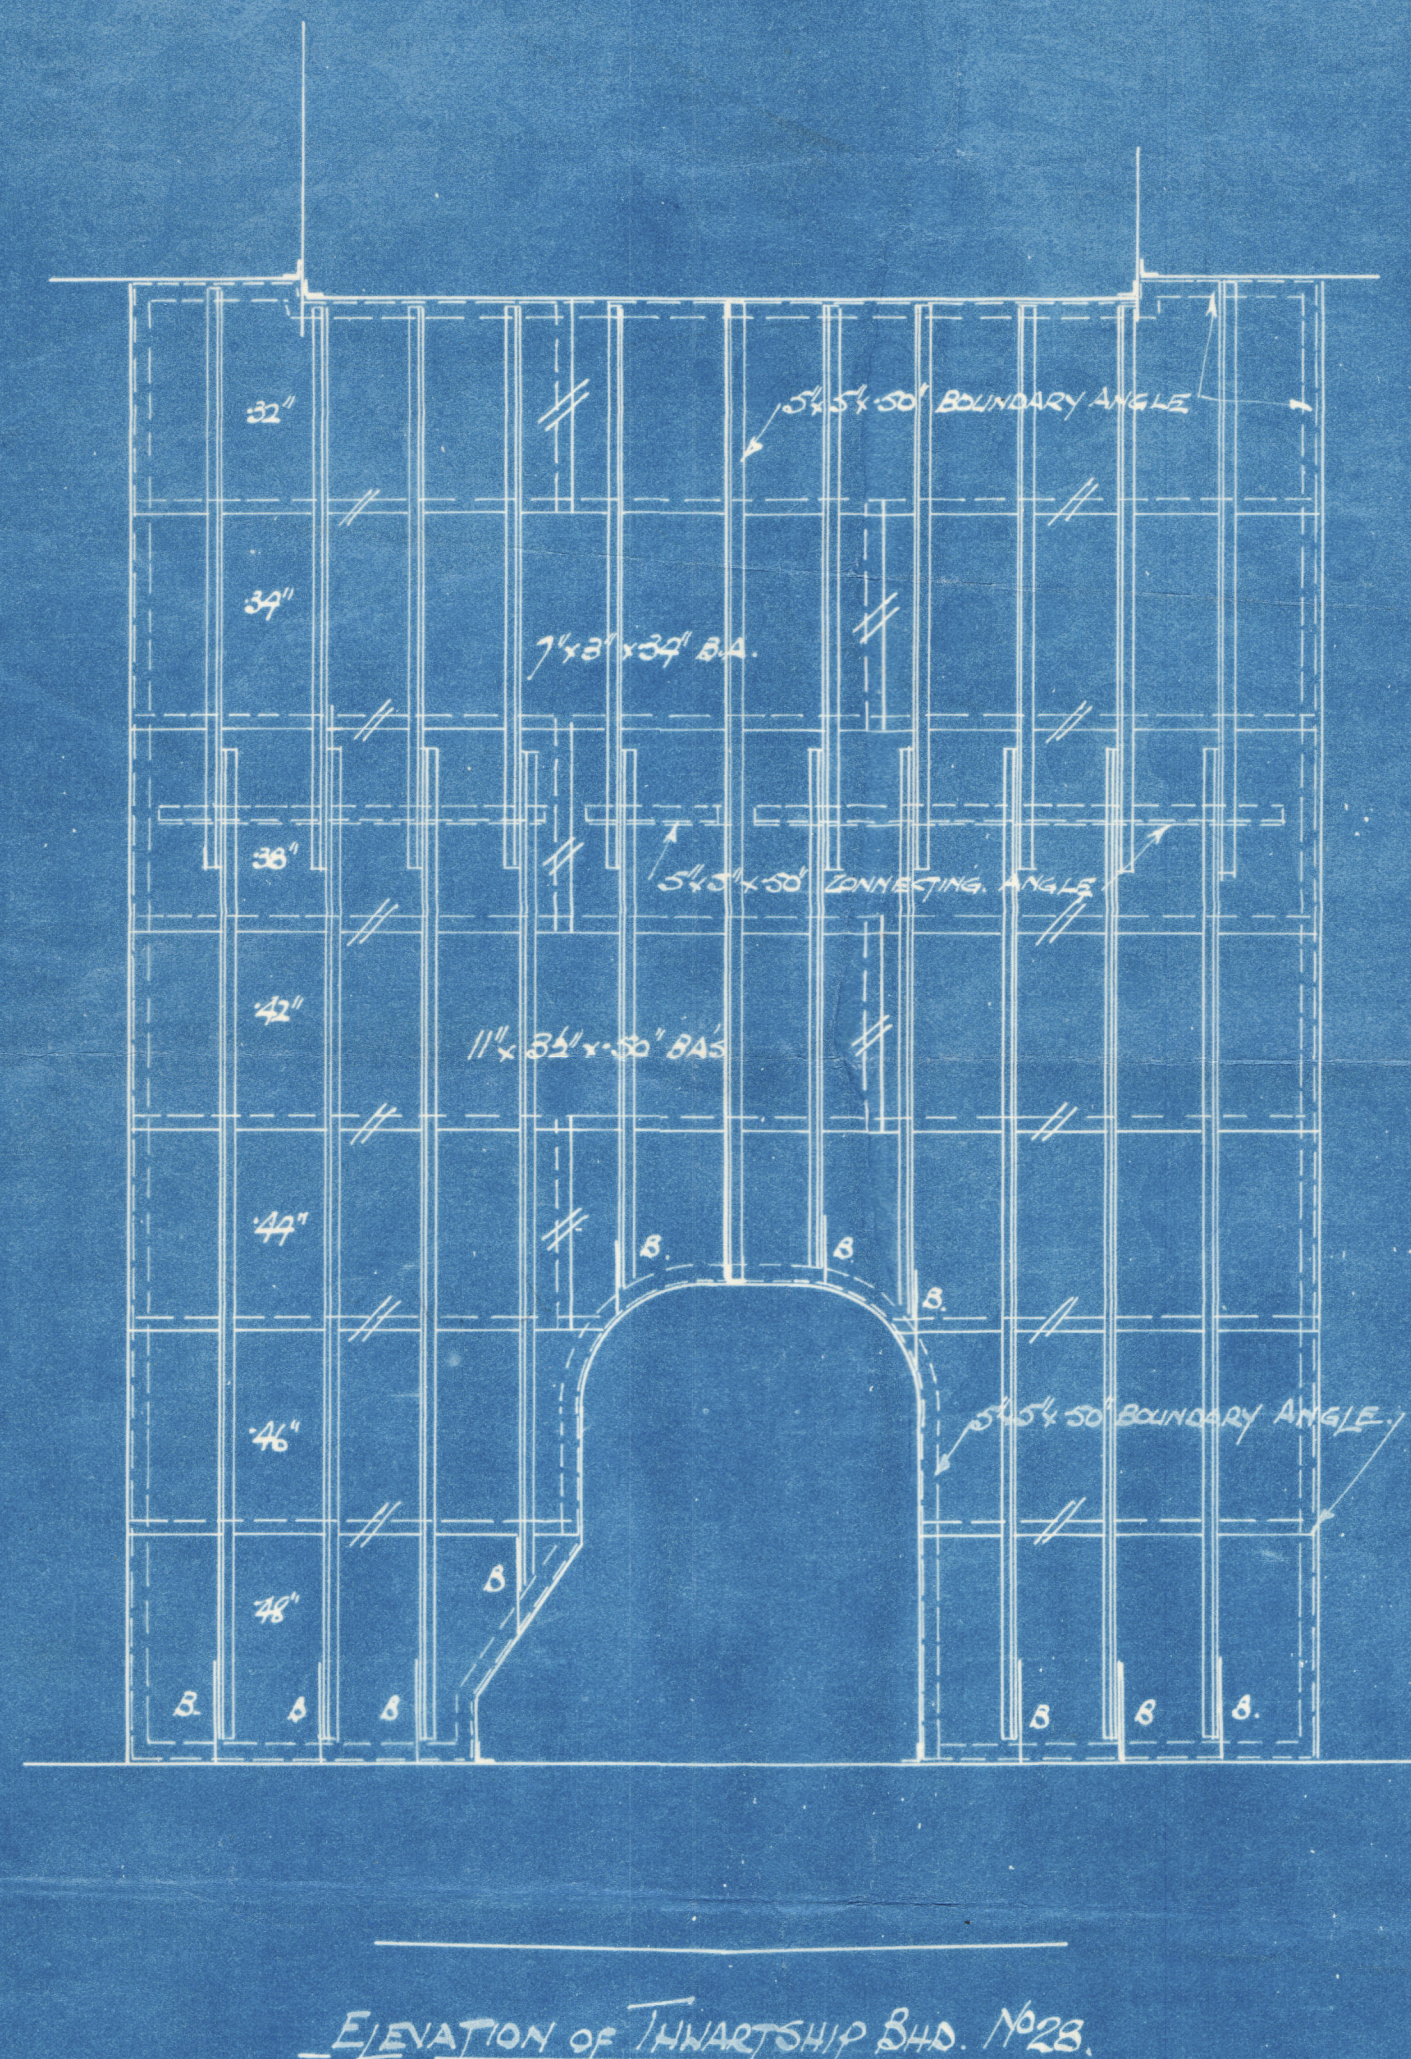
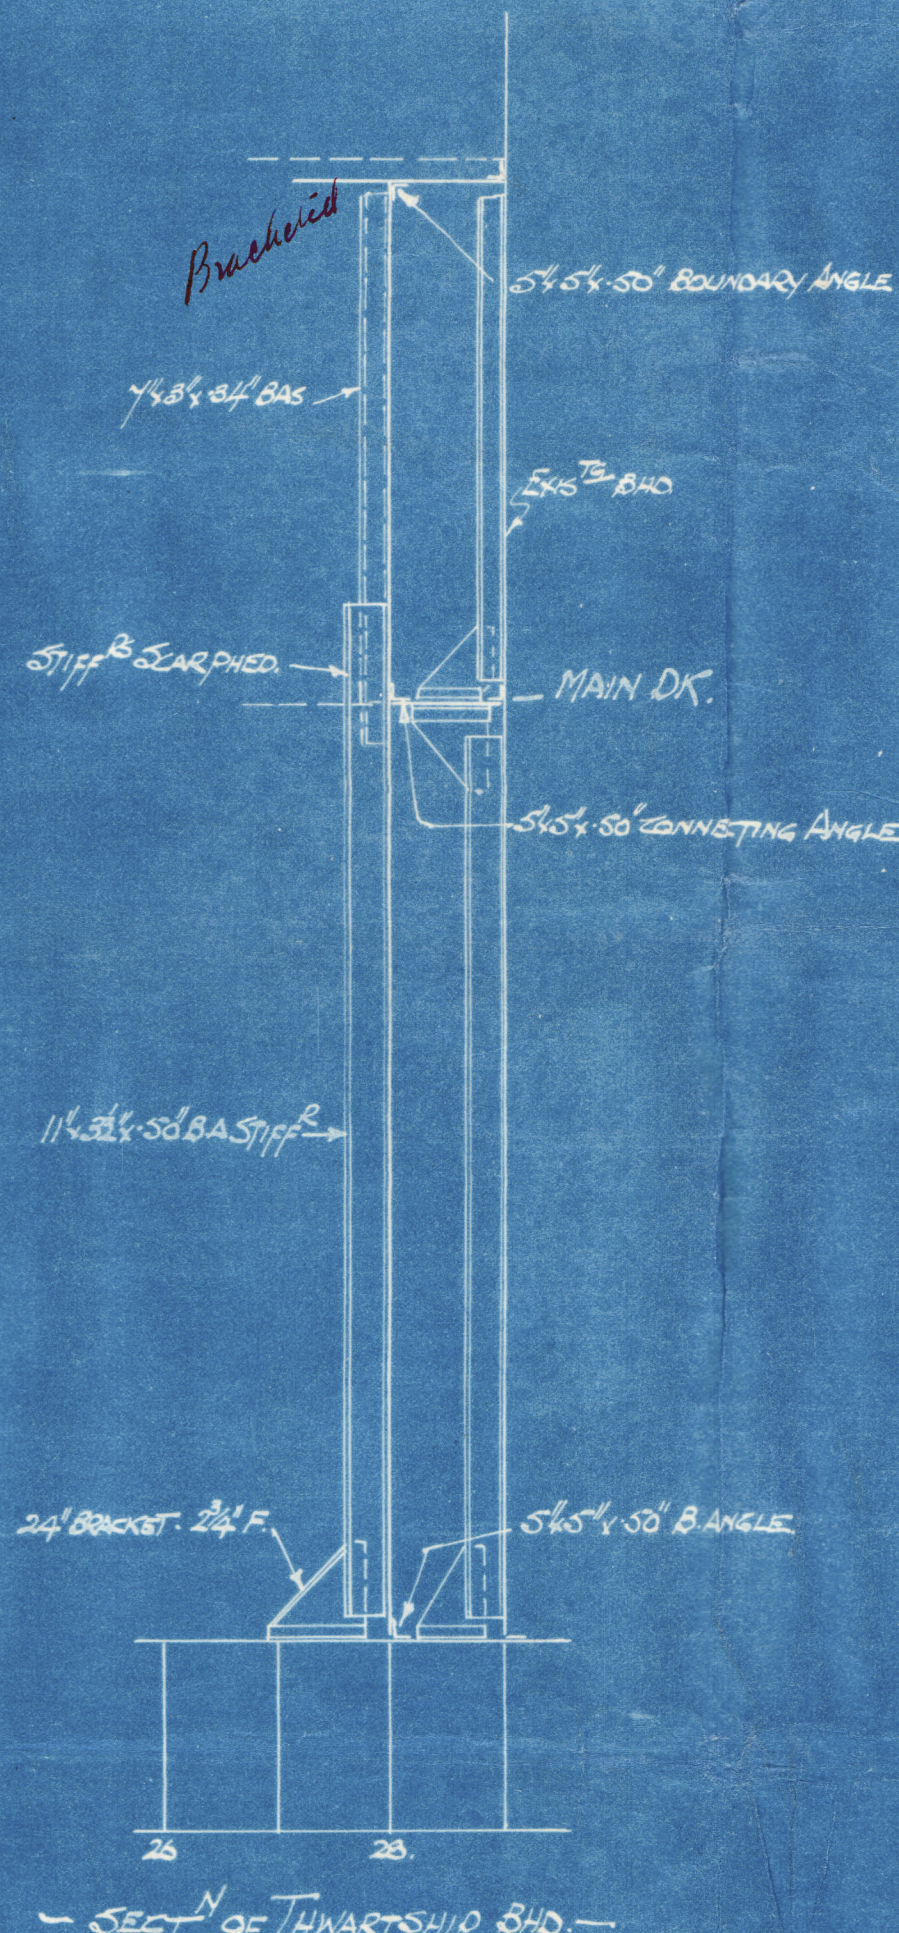


S. S. TAMAROA ex Sophocles.
 S.S. MATAROA ex Diogenes.
 Q.T. BHDs FOR 'A' & 'B' TANKS.
 SCALE - 1/4" = ONE FOOT.

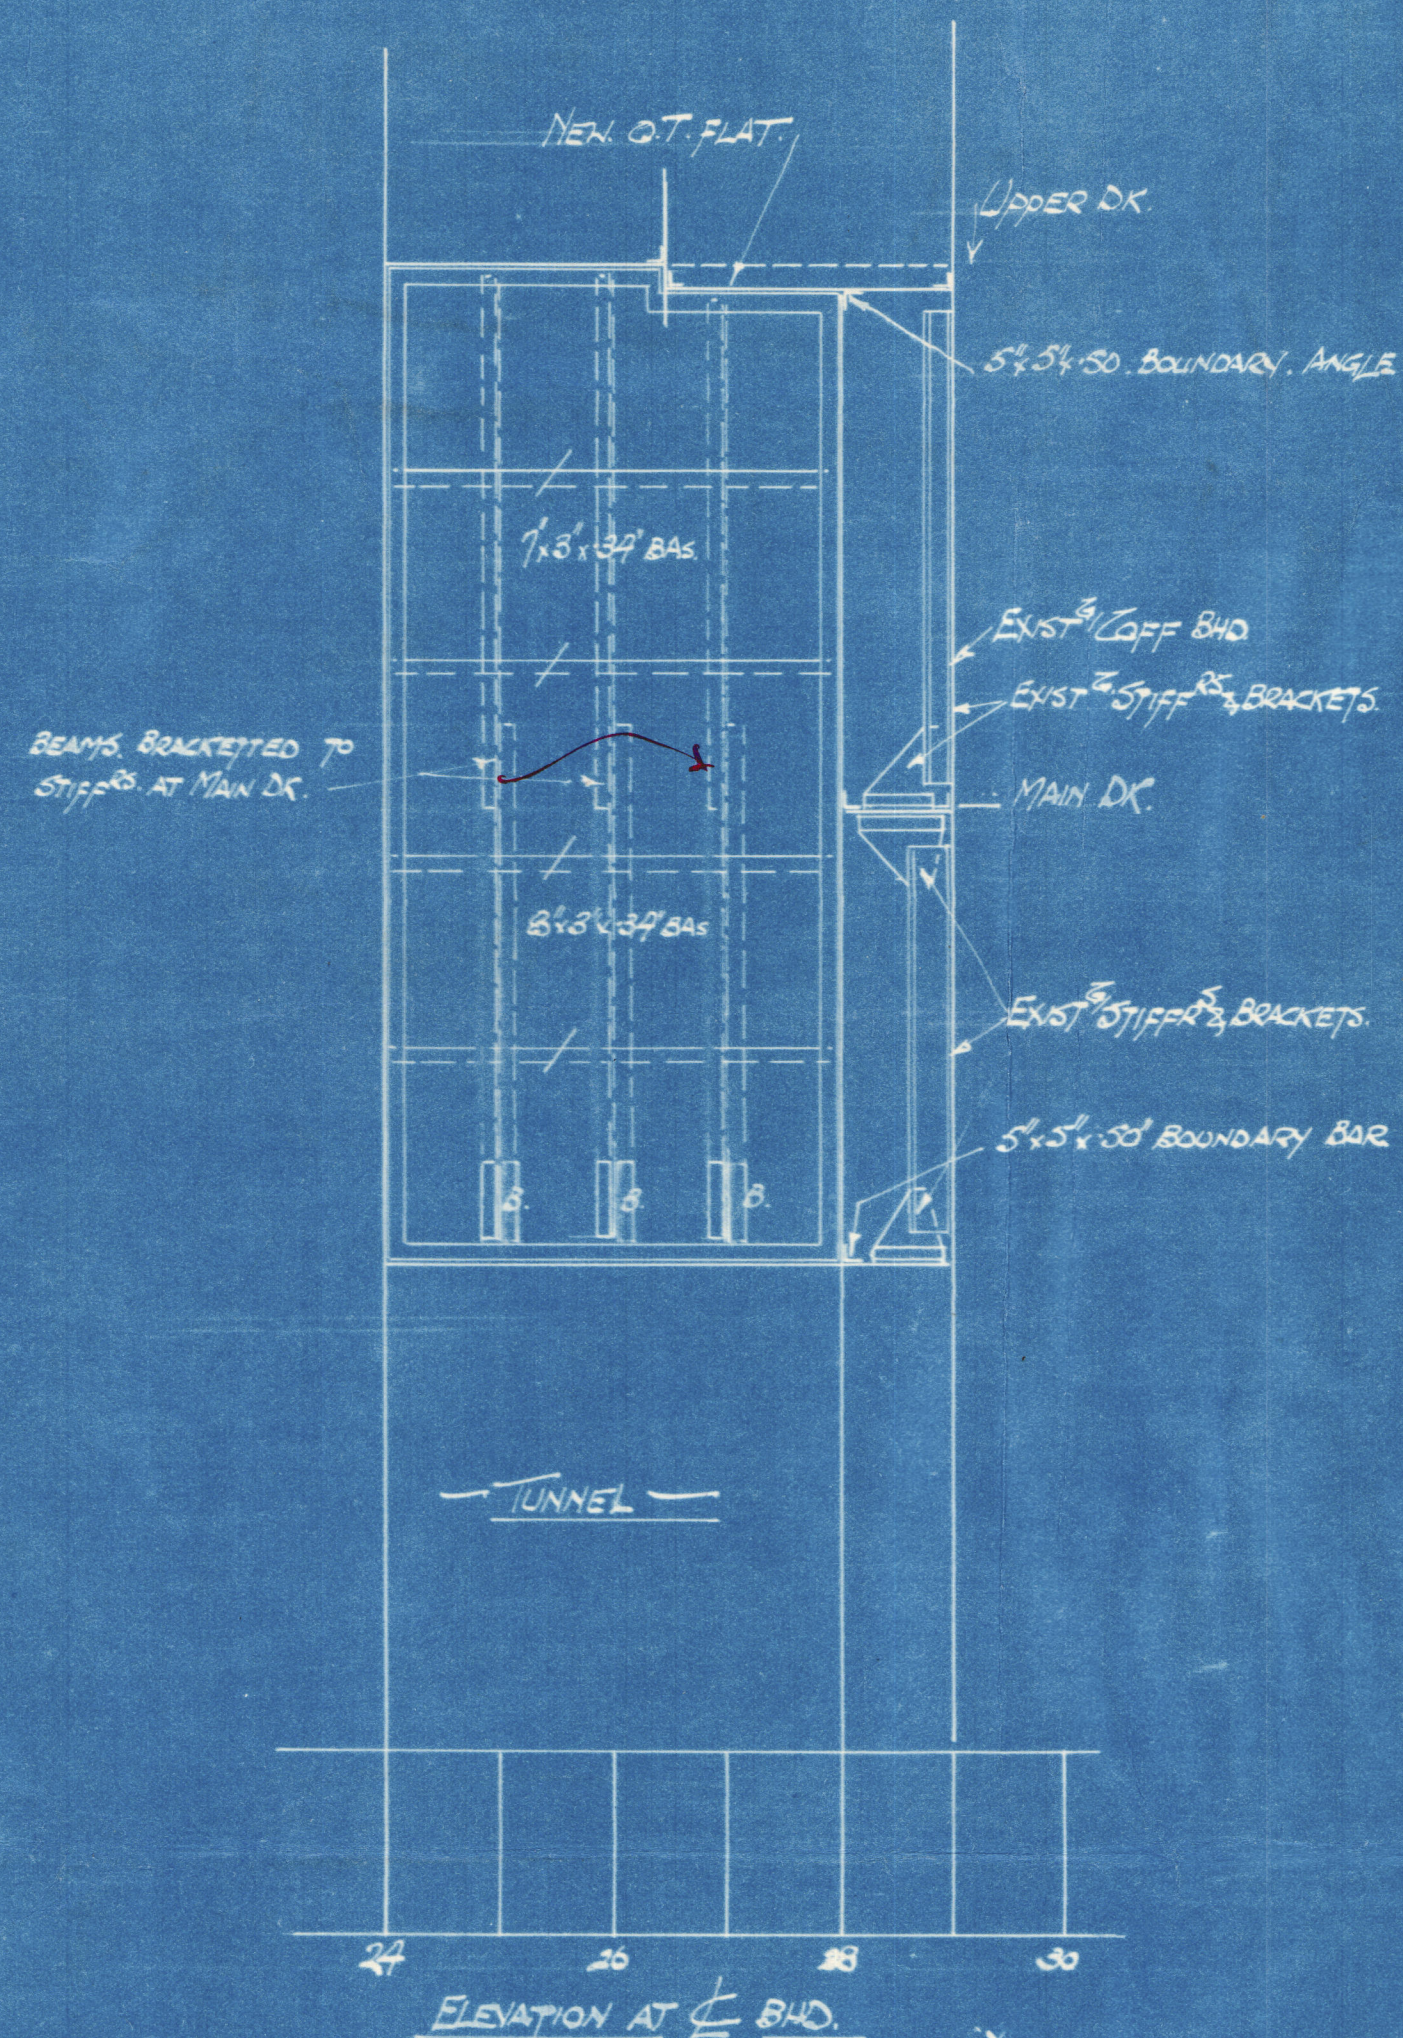

bb
 27.7.26

Tamaroa London Rpt- 90519

also for Matāroa

London Rpt 90746

003867-003874-0144



© 2020

Lloyd's Register
Foundation

003867-003874-0111

26/7/96

matar oq

003867-003874-0111



© 2020

Lloyd's Register
Foundation