



S.S. TAMAROA ex Sophocles
 S.S. TAMAROA. ex "Drogonis"

DETAIL OF FORE & AFT BHD'S
 SCALE 1" = 1'-0"

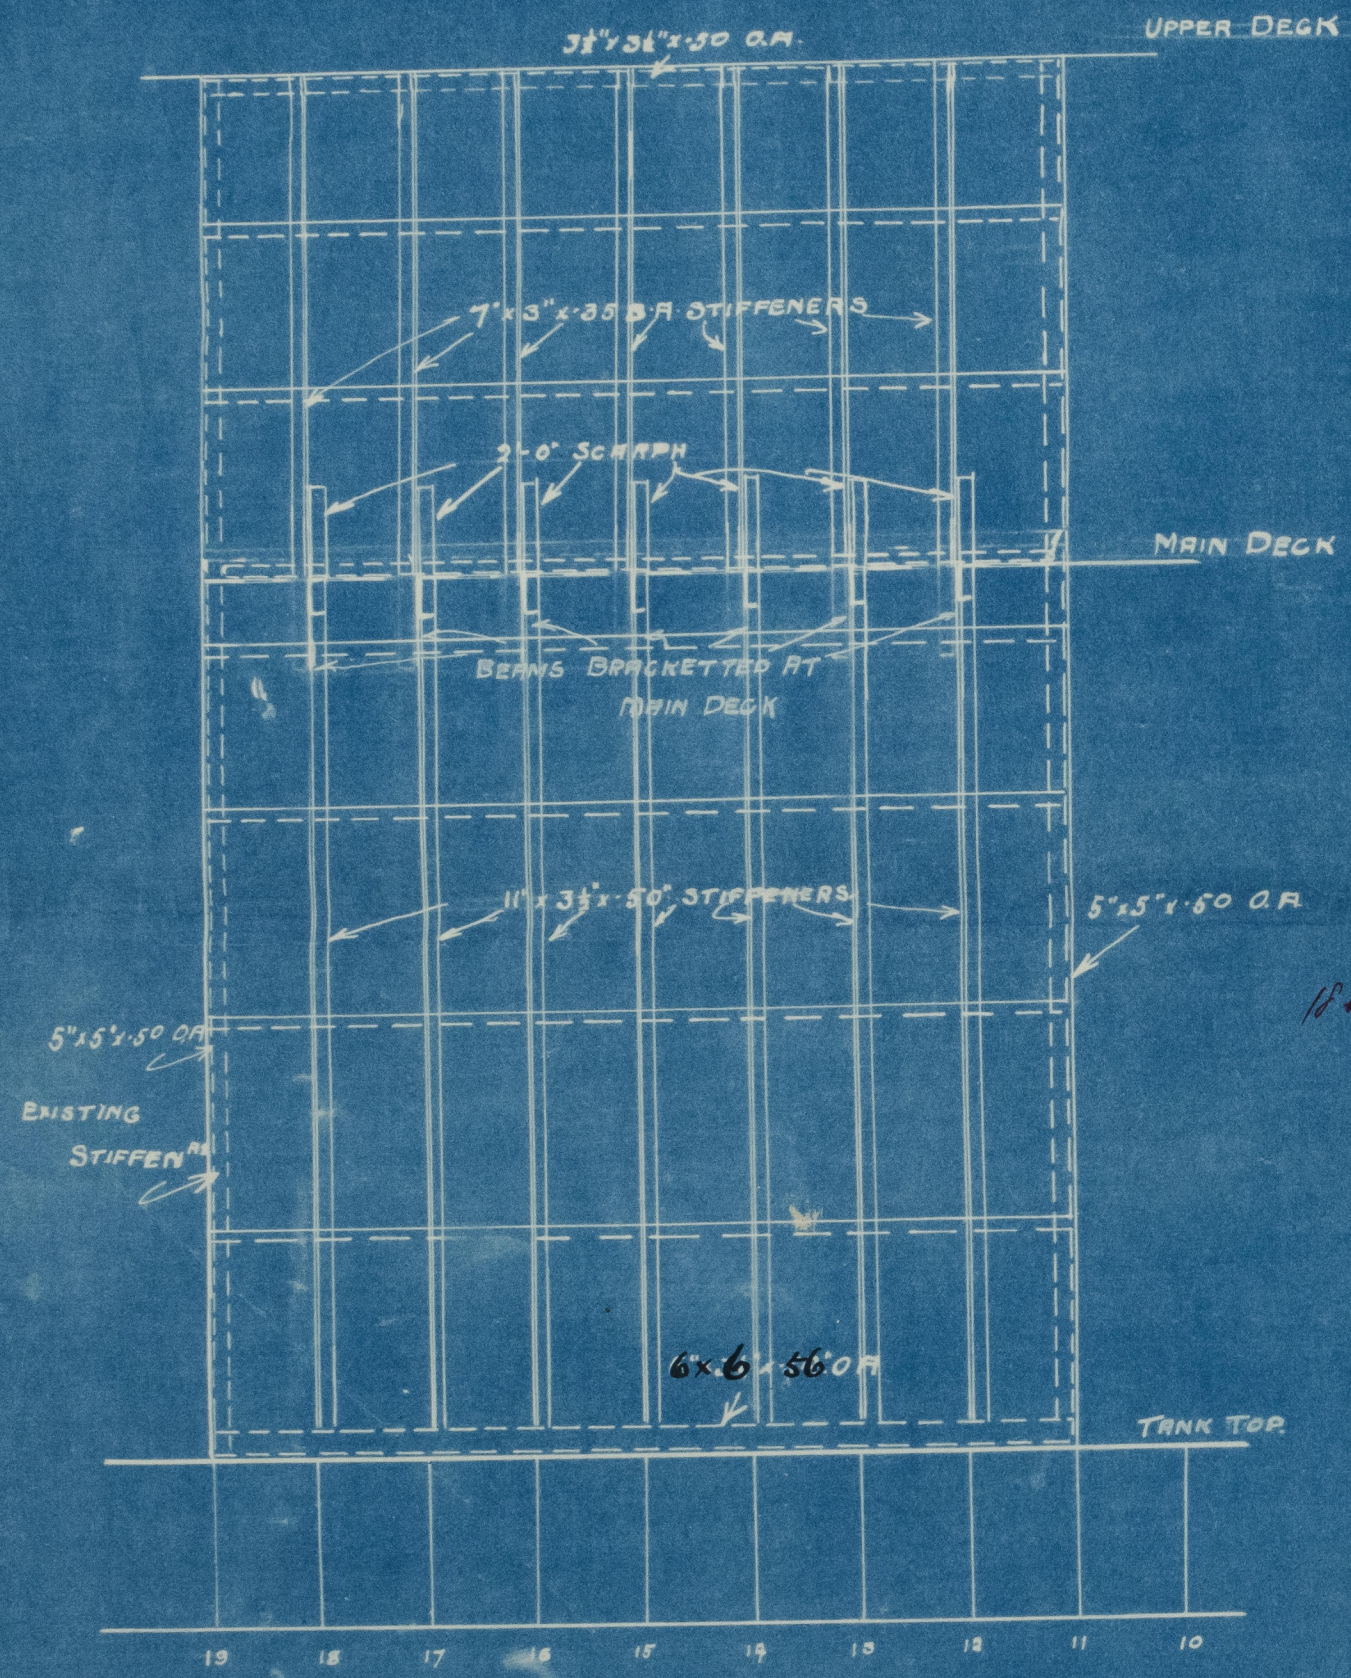

FORE & AFT BHD BETWEEN C & H
 LOOKING INBOARD

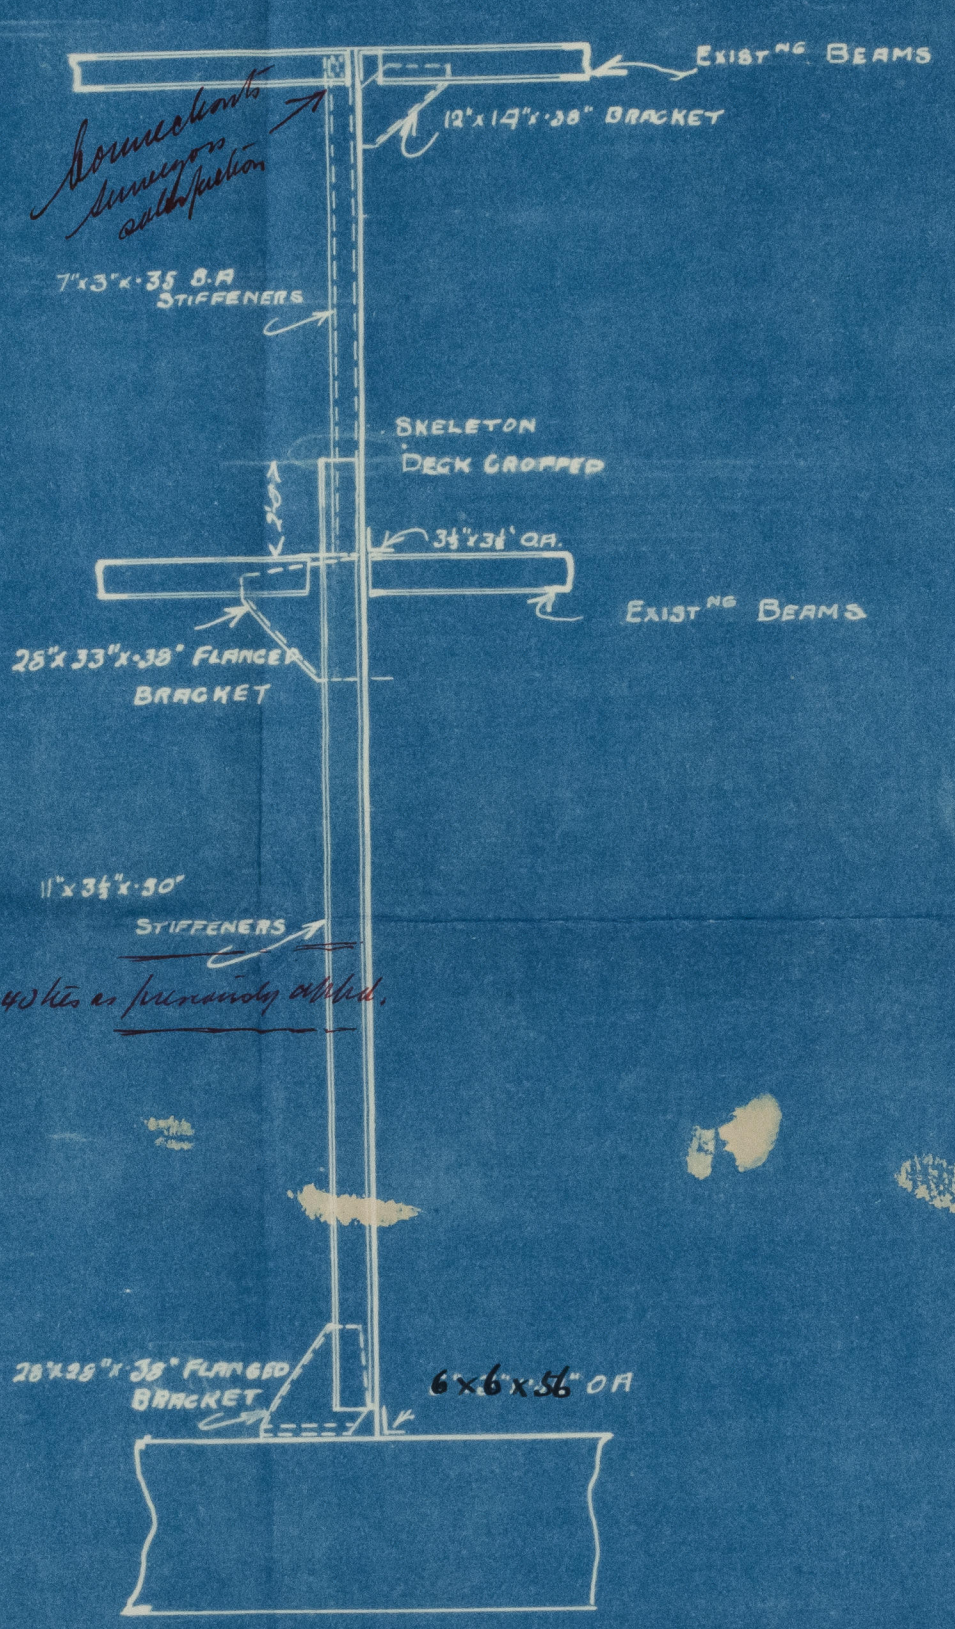


ELEVATION AT FRAME 14
 LOOKING AFT

NOTE
 ALL FORE & AFT BHD'S TO BE
 SIMILARLY CONSTRUCTED

poly
 27.7.26.

R. & H. GREEN AND BILLEY WEIR, LTD.	
GENERAL OFFICES: LONDON, E.	
STAFF DRAWING OFFICE	
DRAWING NUMBER	STORAGE
2731	D 33
DRAWN BY	DATE
<i>D. Young</i>	26/7/20

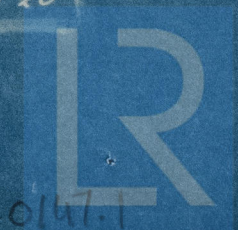

003867 003874-0147.1

Jamaroa

London Rpt 90519

Also for

Nataroa

London Rpt 90746

003867 - 003874 - 0147.1



© 2020

Lloyd's Register
Foundation