

GERIZ-PATENT-KOER


voor

S.S. MANDERAN.

SCHAAL: 1:24 & 1:12

Speed not exceeding 12 knots

DOORSNEDE A-A

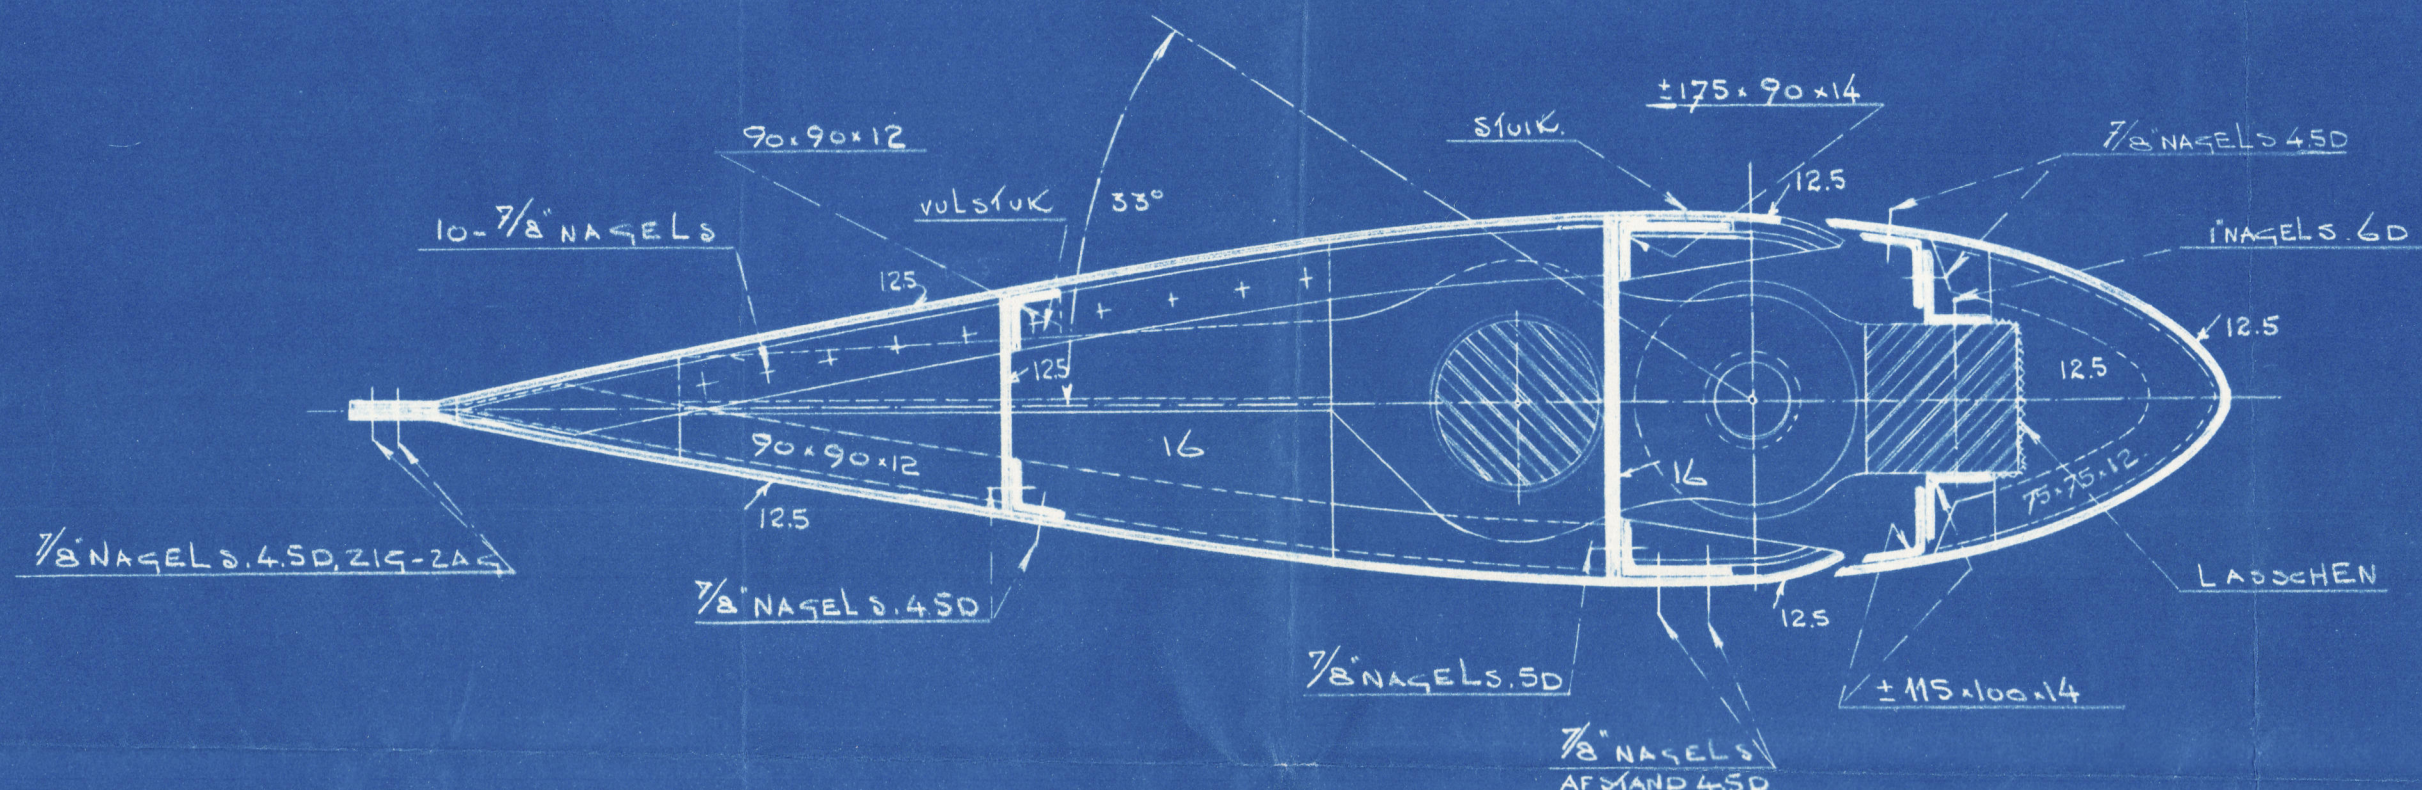

Electric Welding by an approved process.

Vertical seams at fore & after edges of rudder and
edges at top and bottom to be caulked, riveted W.T. to satisfaction of
Surveyor.

OMREKENING VAN HET ROER BUITENWERKS

N.V. CARP & HORIER'S HANDEL-MAATSCHAPPIJ

AMSTERDAM-ROTTERDAM

JULI 1929.

L.R.Σ.
13.8.29

437.

SS. Manover
Outh Rudder
hand in

GEN. BOX NO 678

003867-003874-0214



© 2020

Lloyd's Register
Foundation