

CLASS 100A1 "For West African and Spanish Boasting Service"

CHIODATURE

FASCIAME ESTERNO - ORLI

CHIGLIA	±96 CH. ± 16 IN 4½ D	ACATENA
FONDO E FIANCHI	±60 CH. ± 16 IN 4½ D	
CINTA E SOTTOCINTA	±60 CH. ± 16 IN 4½ D	

ANGOLARE TRINCARINO

CH. ± 16 IN 4½ D

CONTORNO BOCCAPORTA

CH. ± 19 IN 4½ D

COFANO

CH. ± 13 IN 4½ D

PARATIE CON FASC. EST.

CH. ± 16 IN 5 D

COSTOLE

CH. ± 16 IN 7 D

RINF. CON FASC. EST.

CH. ± 16 IN 5½ D

BAGLI E MEZZI BAGLI

CH. ± 13 IN 7 D

Welding SALDATURE

FASC. EST. E PONTI - INTESTATURE S.E. CON RIPRESA AL VERTICE

PARAMEZZALE CENTRALE ATTACCO SUPERIORE

" " " " INFERIORE

MADIERI DALL' ORD. 10 - 41

" " " " 42 - 51

PARATIE

FASCIAME - ORLI INTESTATURE - S.E.

ANGOLARI CONTORNO PARATIE CON FASC. PARATIE - S.E.

CARATTERISTICHE PRINCIPALI

LUNGHEZZA FUORI TUTTO (Lowall)	m 33.106	L.B.P. 100.23
LUNGHEZZA AL GALLEGGIAMENTO (L.W.L.)	m 31.220	19.22
LARGHEZZA F.O. B.M.C.	m 5.860	9.25
ALTEZZA IN FIANCO AL MEZZO D.M.C.	m 2.820	8.2
ALTEZZA AL GALLEGGIAMENTO	m 2.500	
PORTATA LORDA Deadweight	T.214	
BOLZONE m/m 125	Cantier	
DISTANZA ORD. m/m 520	frame space	

ARMAMENTO SECONDO IL MODULO N° 450

- 2 ANCORE DA POSTA DAL PESO OGNUNA DI Kg 220
- 1 ANCORA DI TONNEGGIO CON CEPPLO DA Kg 35 ESCLUSO IL CEPPLO
- LUNGHEZZE CATENA CON TRAV. CALIBRO 17
- 75 m CAVO ACCIAIO ± 15 m CARICO ROTT. 7400 Kg FORM. 6-12 PER ANCORA T.
- 130 m CAVO CANAPE CIRC. 140 m hemp
- 165 m GHERLINO IN CAVO CANAPE CIRC. 80 m hemp

Equipment Manual

100.23 (1922 + 9.22)	2853.55
Freccante 14.12 5714.75	62.5
After Superstructure 17.12 615.75	90.3
	3,006.15


265	2848
8.6	54.5
3.57	90.3
27.17	599.28

Cable supplies
18 cups dia
2200 m.
See F.E. List-Brace
N°/Hemp

APPROVATO DAL R.I.Na 29-1-1947

Notes in pencil

NAVALE CUNIZZI	
COSTRUZIONI E RIPARAZIONI NAVALI - OFFICINE MECCANICHE	
MUGLIA - TRIESTE	
SCALA 1:20	COSTO AL. 13
SEZIONE MAESTRA	
Lloyd's Register Foundation	
DATA 20-5-47	

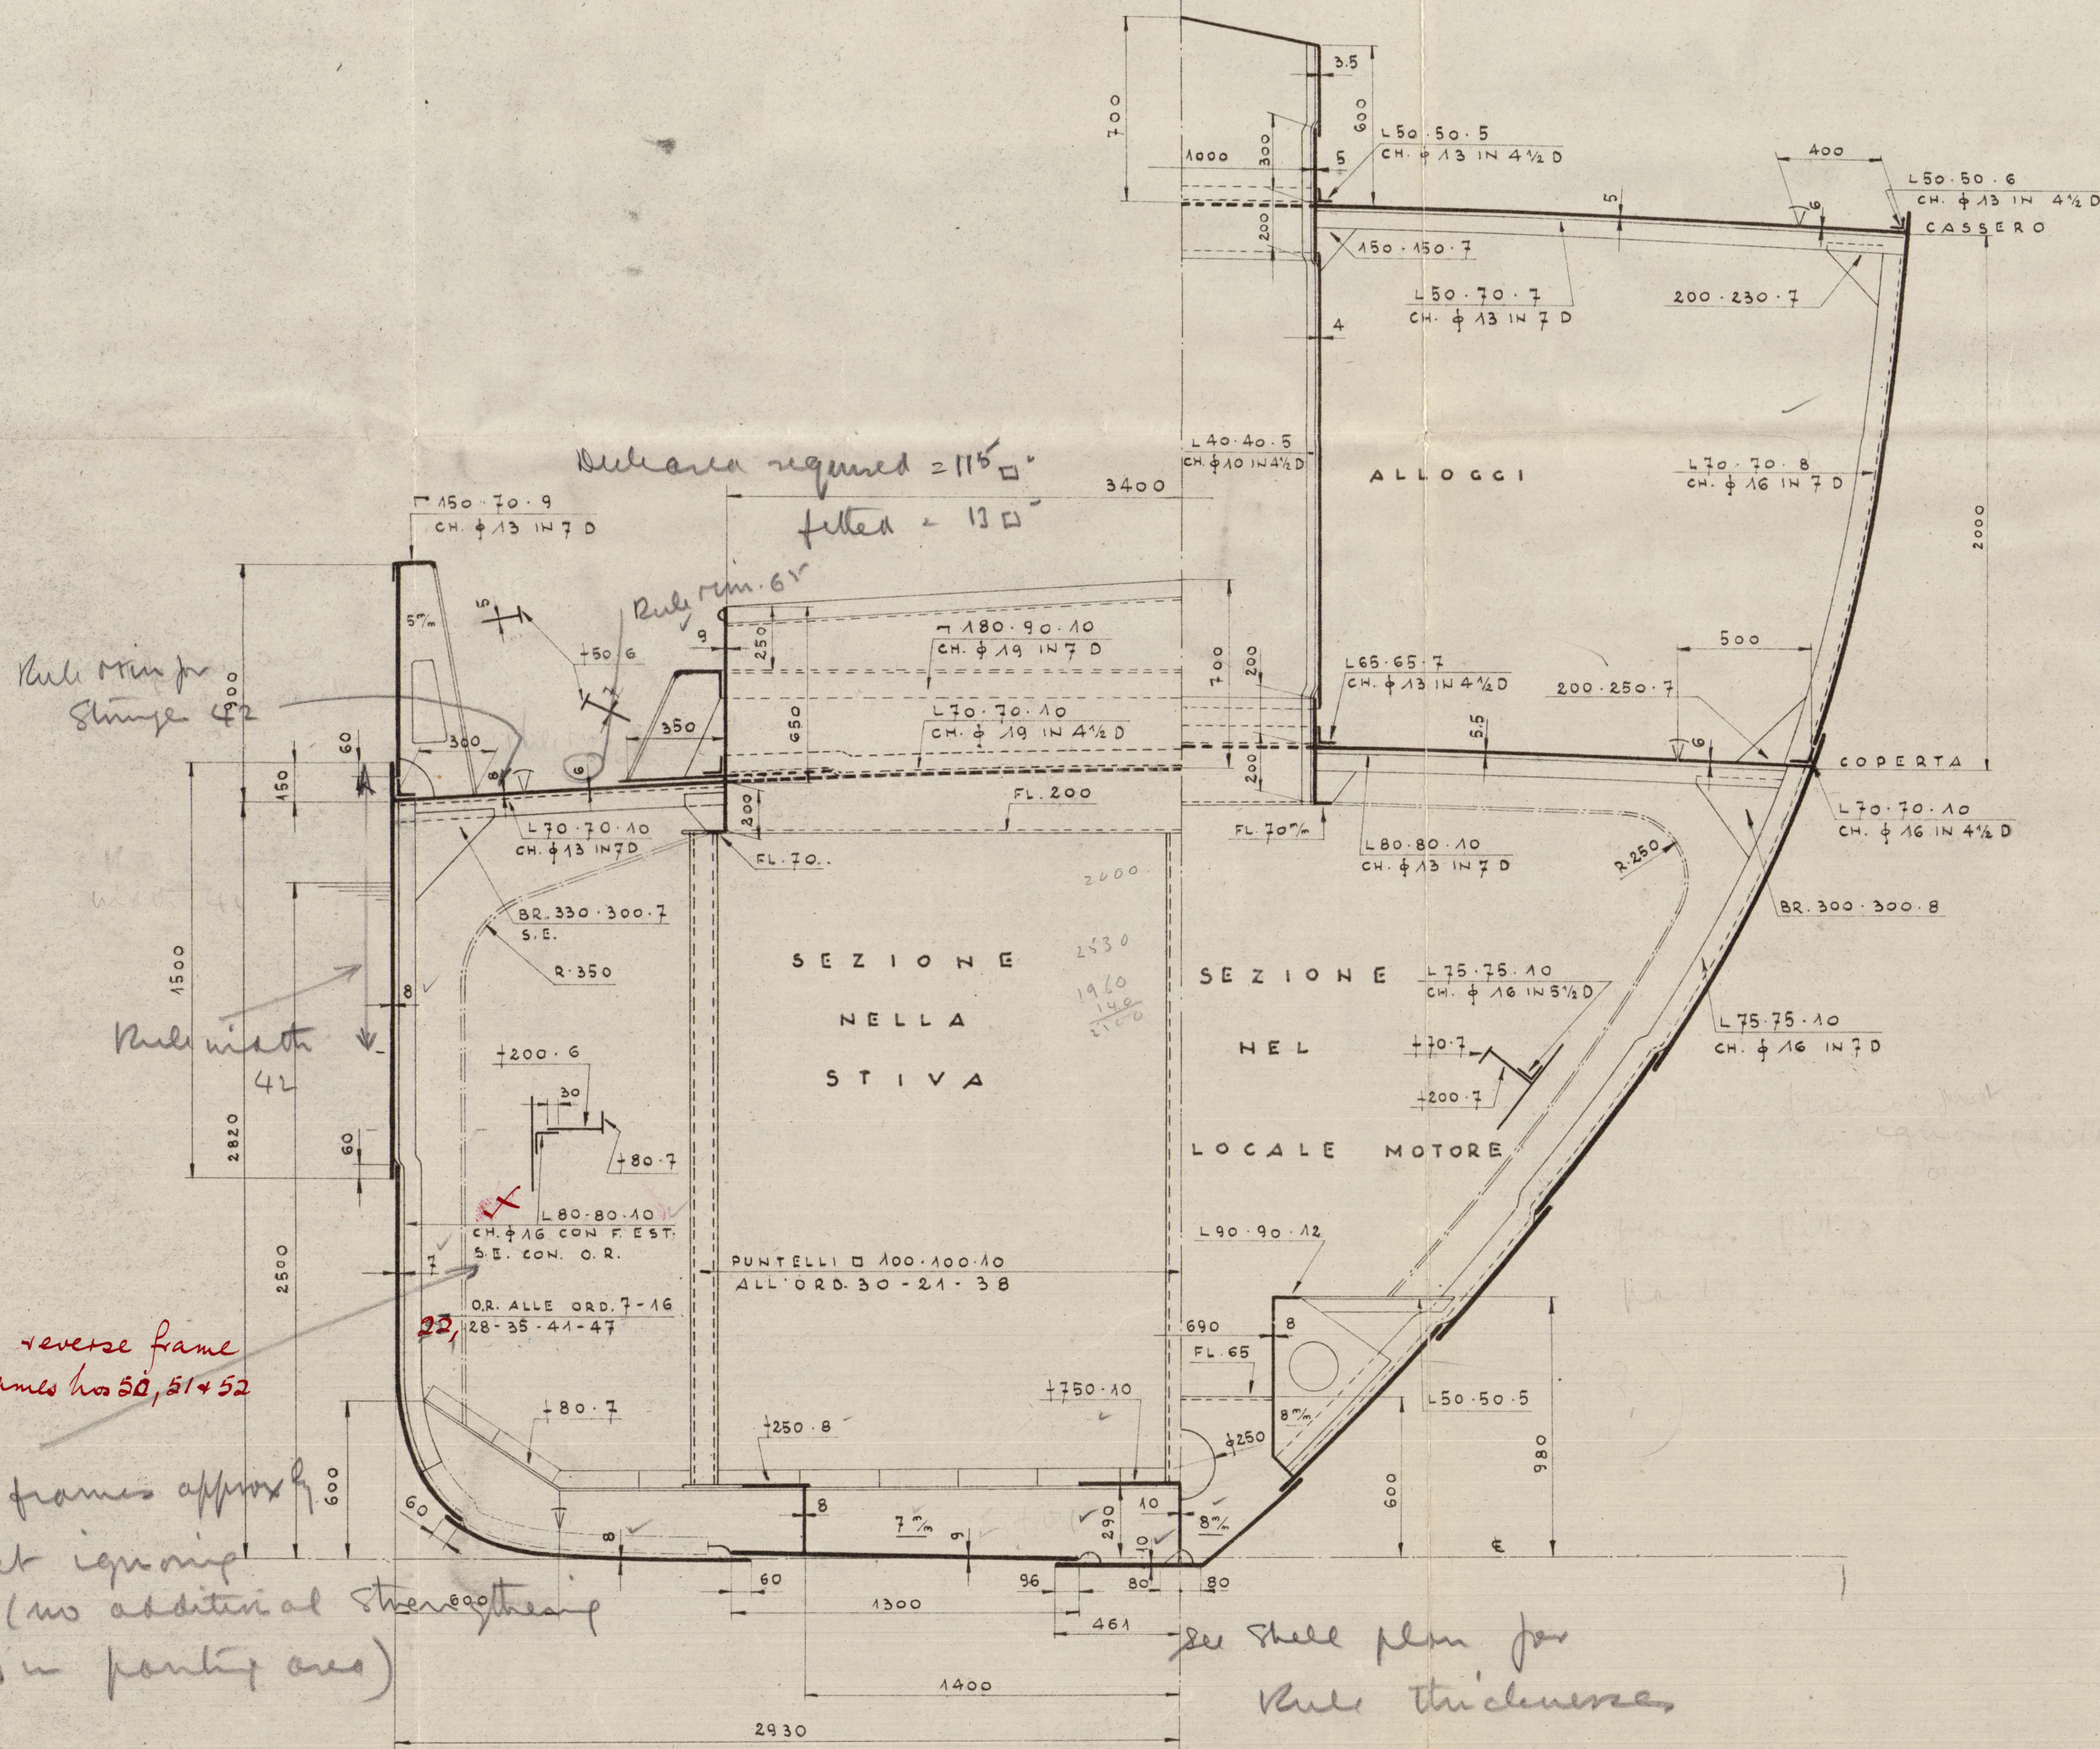

X With reverse frame at frames no 50, 51 & 52


Hold frames approx correct ignoring hols (no additional strengthening fitted in pointing area)


See shell plan for Rule thicknesses

assumed diameters

Rule
445 Kg. 5 Kg deficient
40 Kg ex st. 5 Kg
220 mts. 17.5 mts. 1/2 m/m
85 mts. 13 mts. chain
135 mts. 140 hemp
165 mts. 76 hemp

RECORDS DEPT.,
LONDON

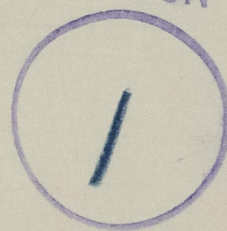

Bruna
Midship Section 



© 2020

Lloyd's Register
Foundation

003884-003894-0175