
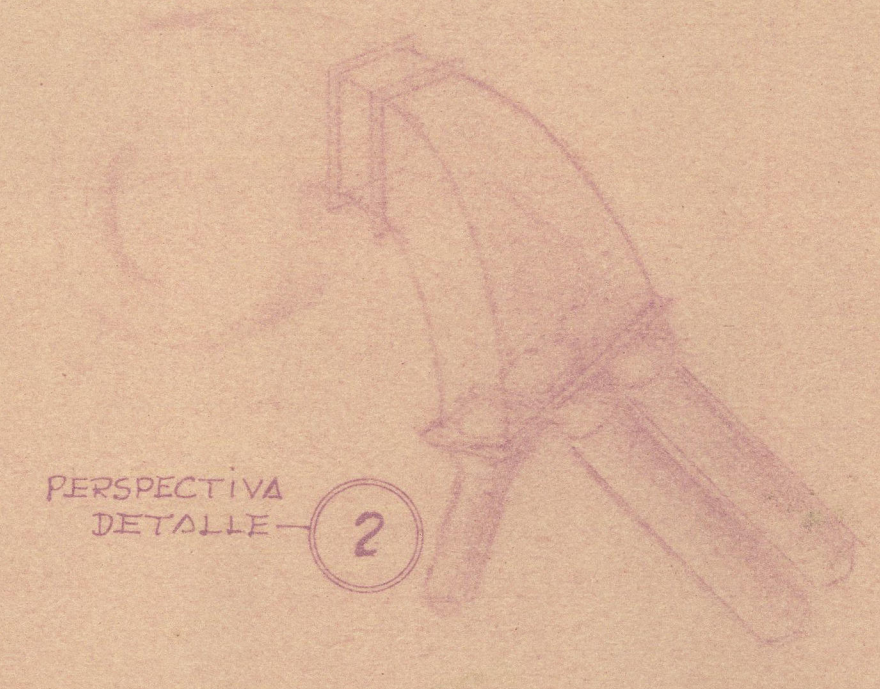
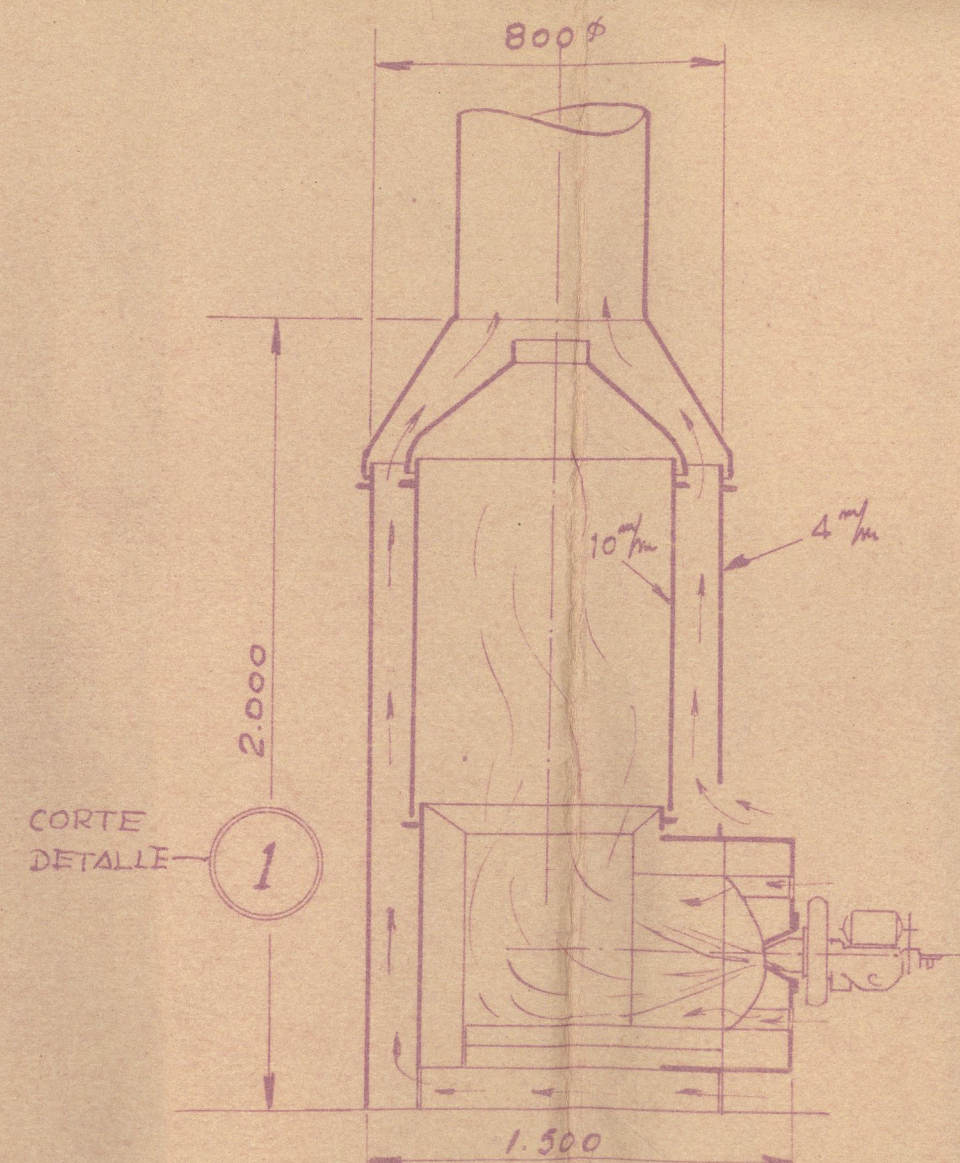
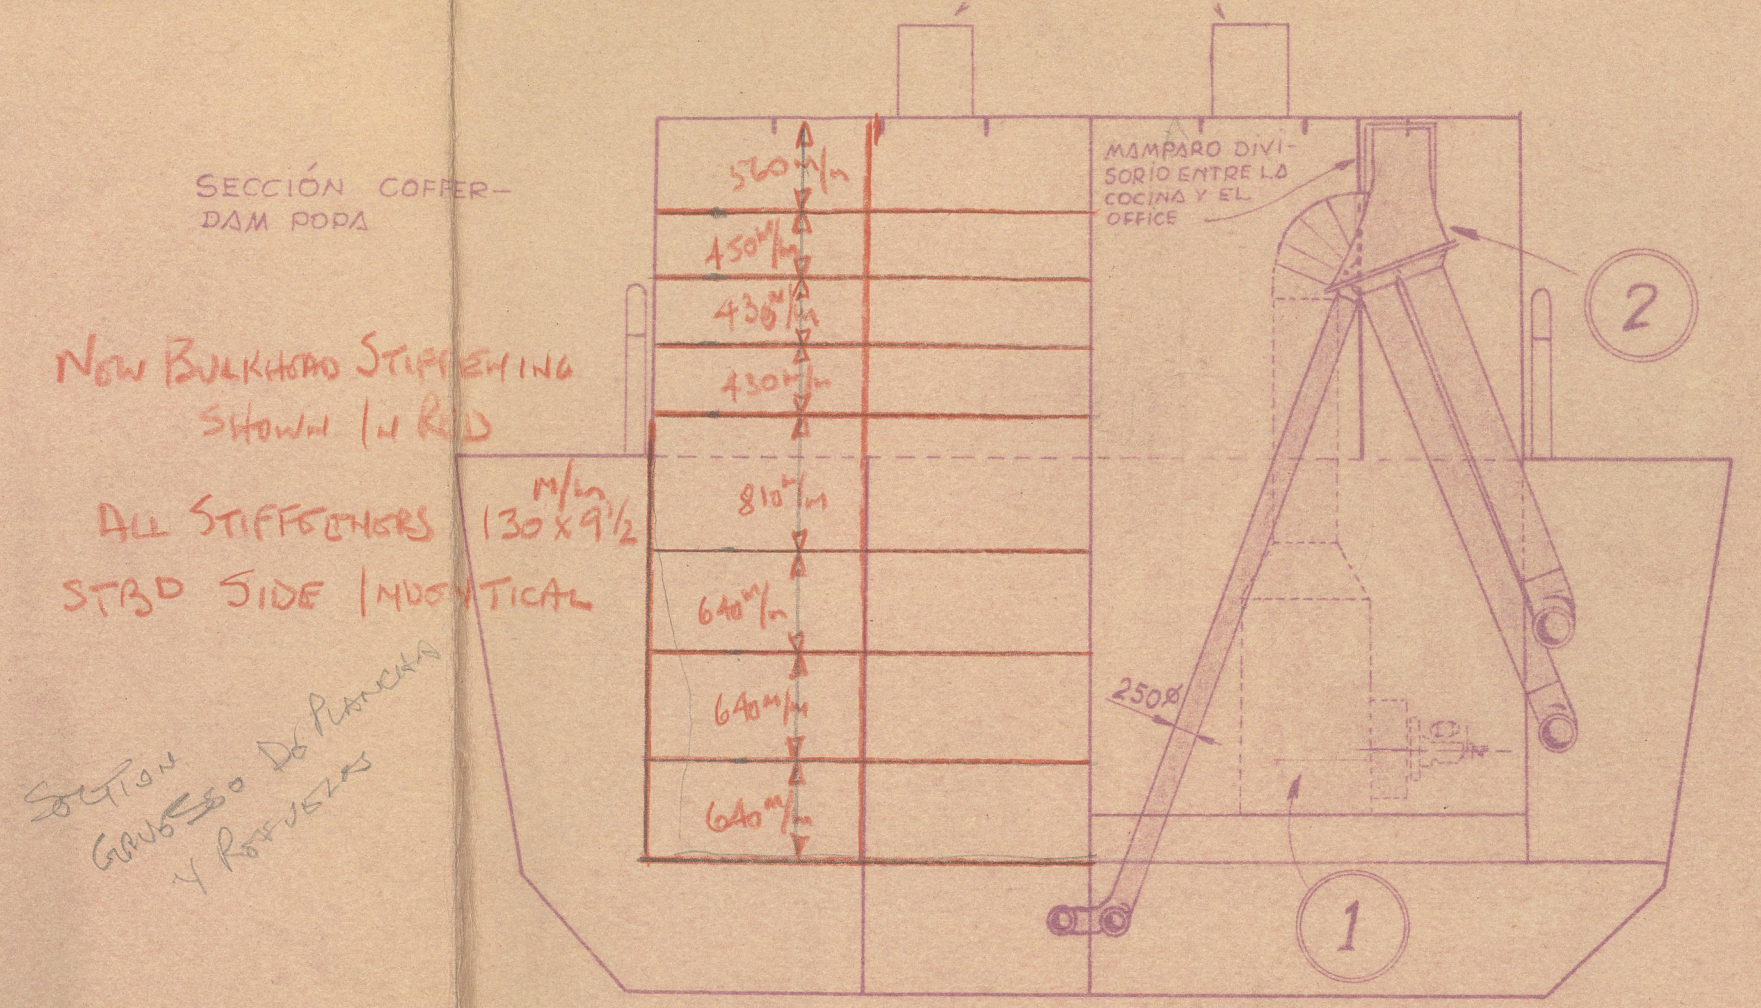
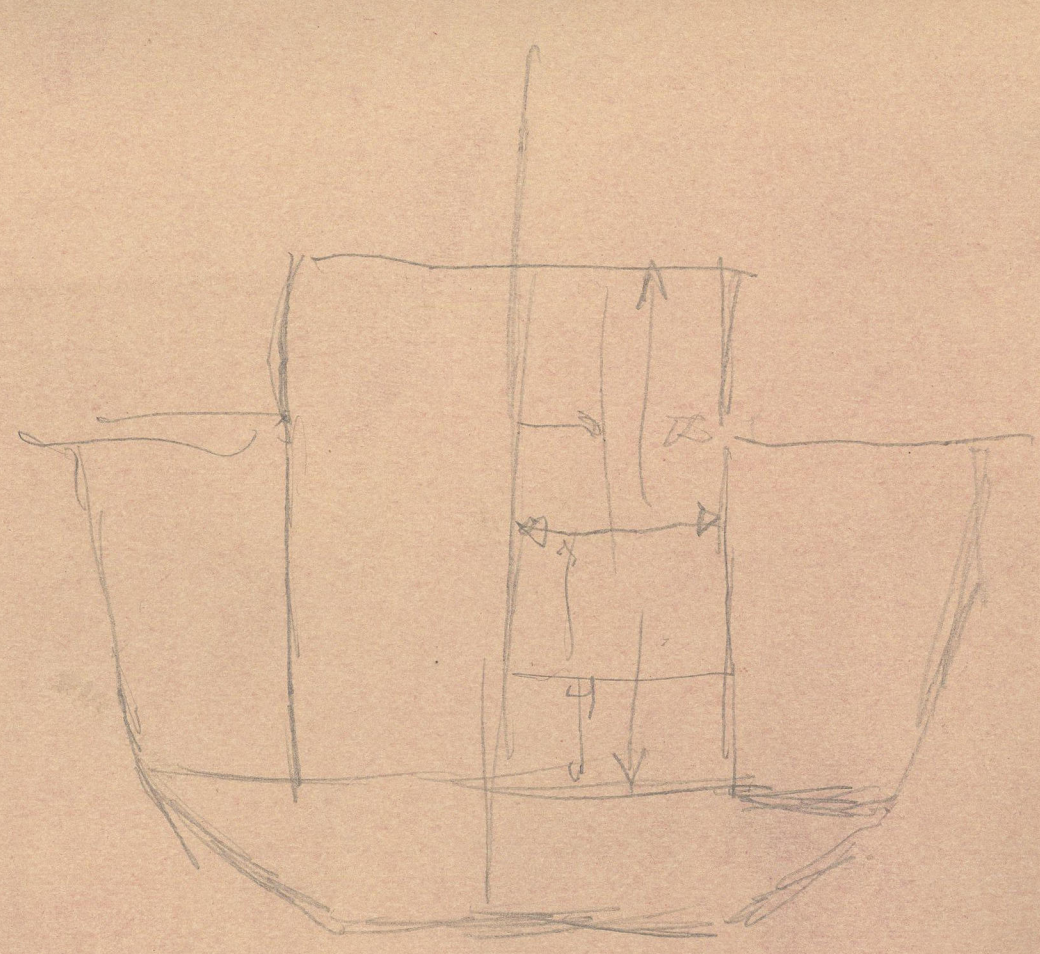


Floor 26
FRASE 29 CONTINUA FROM AFT

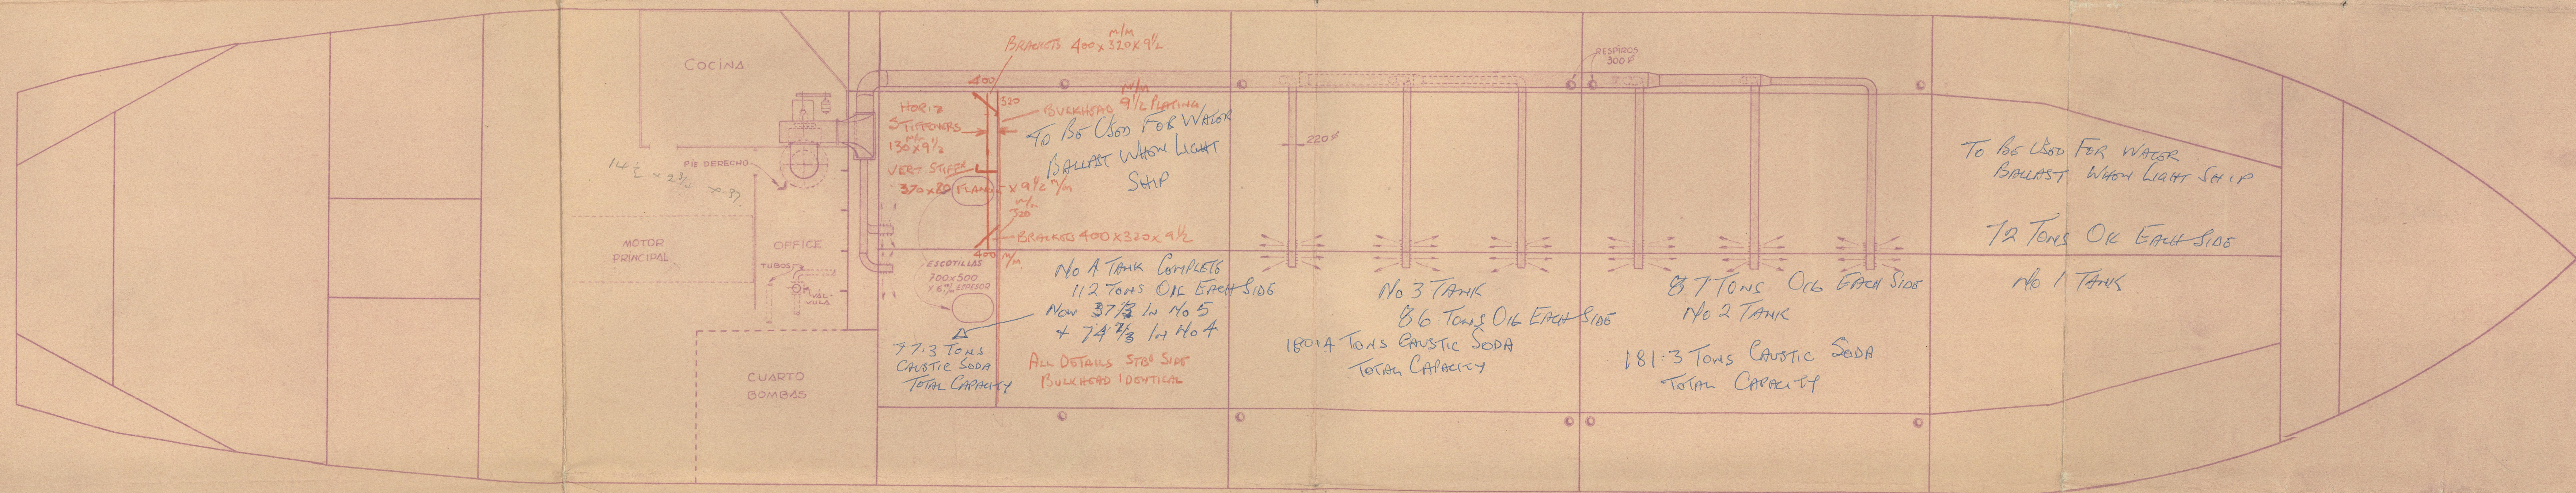

- CARACTERISTICAS -

QUEMADOR:

10 A 28 Kg/h

100.000 A 250.000 cal

VENTILADOR:

5.000 Kg. aire/h.


3 Kw

3/5/55

MARIA ROSA

152 643 89


RECORDS DEPT.,
LONDON.

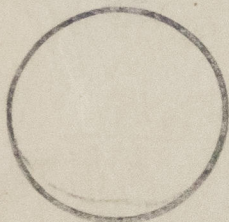

New bulkheads for

conveying of Caustic Soda.

003895-003905-0042

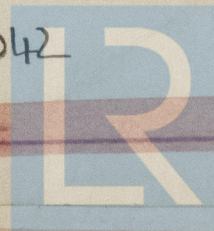

© 2020

Lloyd's Register
Foundation