


SMITH'S DOCKS CO LTD,
 DRY DOCK DEPT,
 RIVER TEES DOCKYARD,
 SOUTHBANK - ON-TEES
 27TH. OCTOBER. 1960

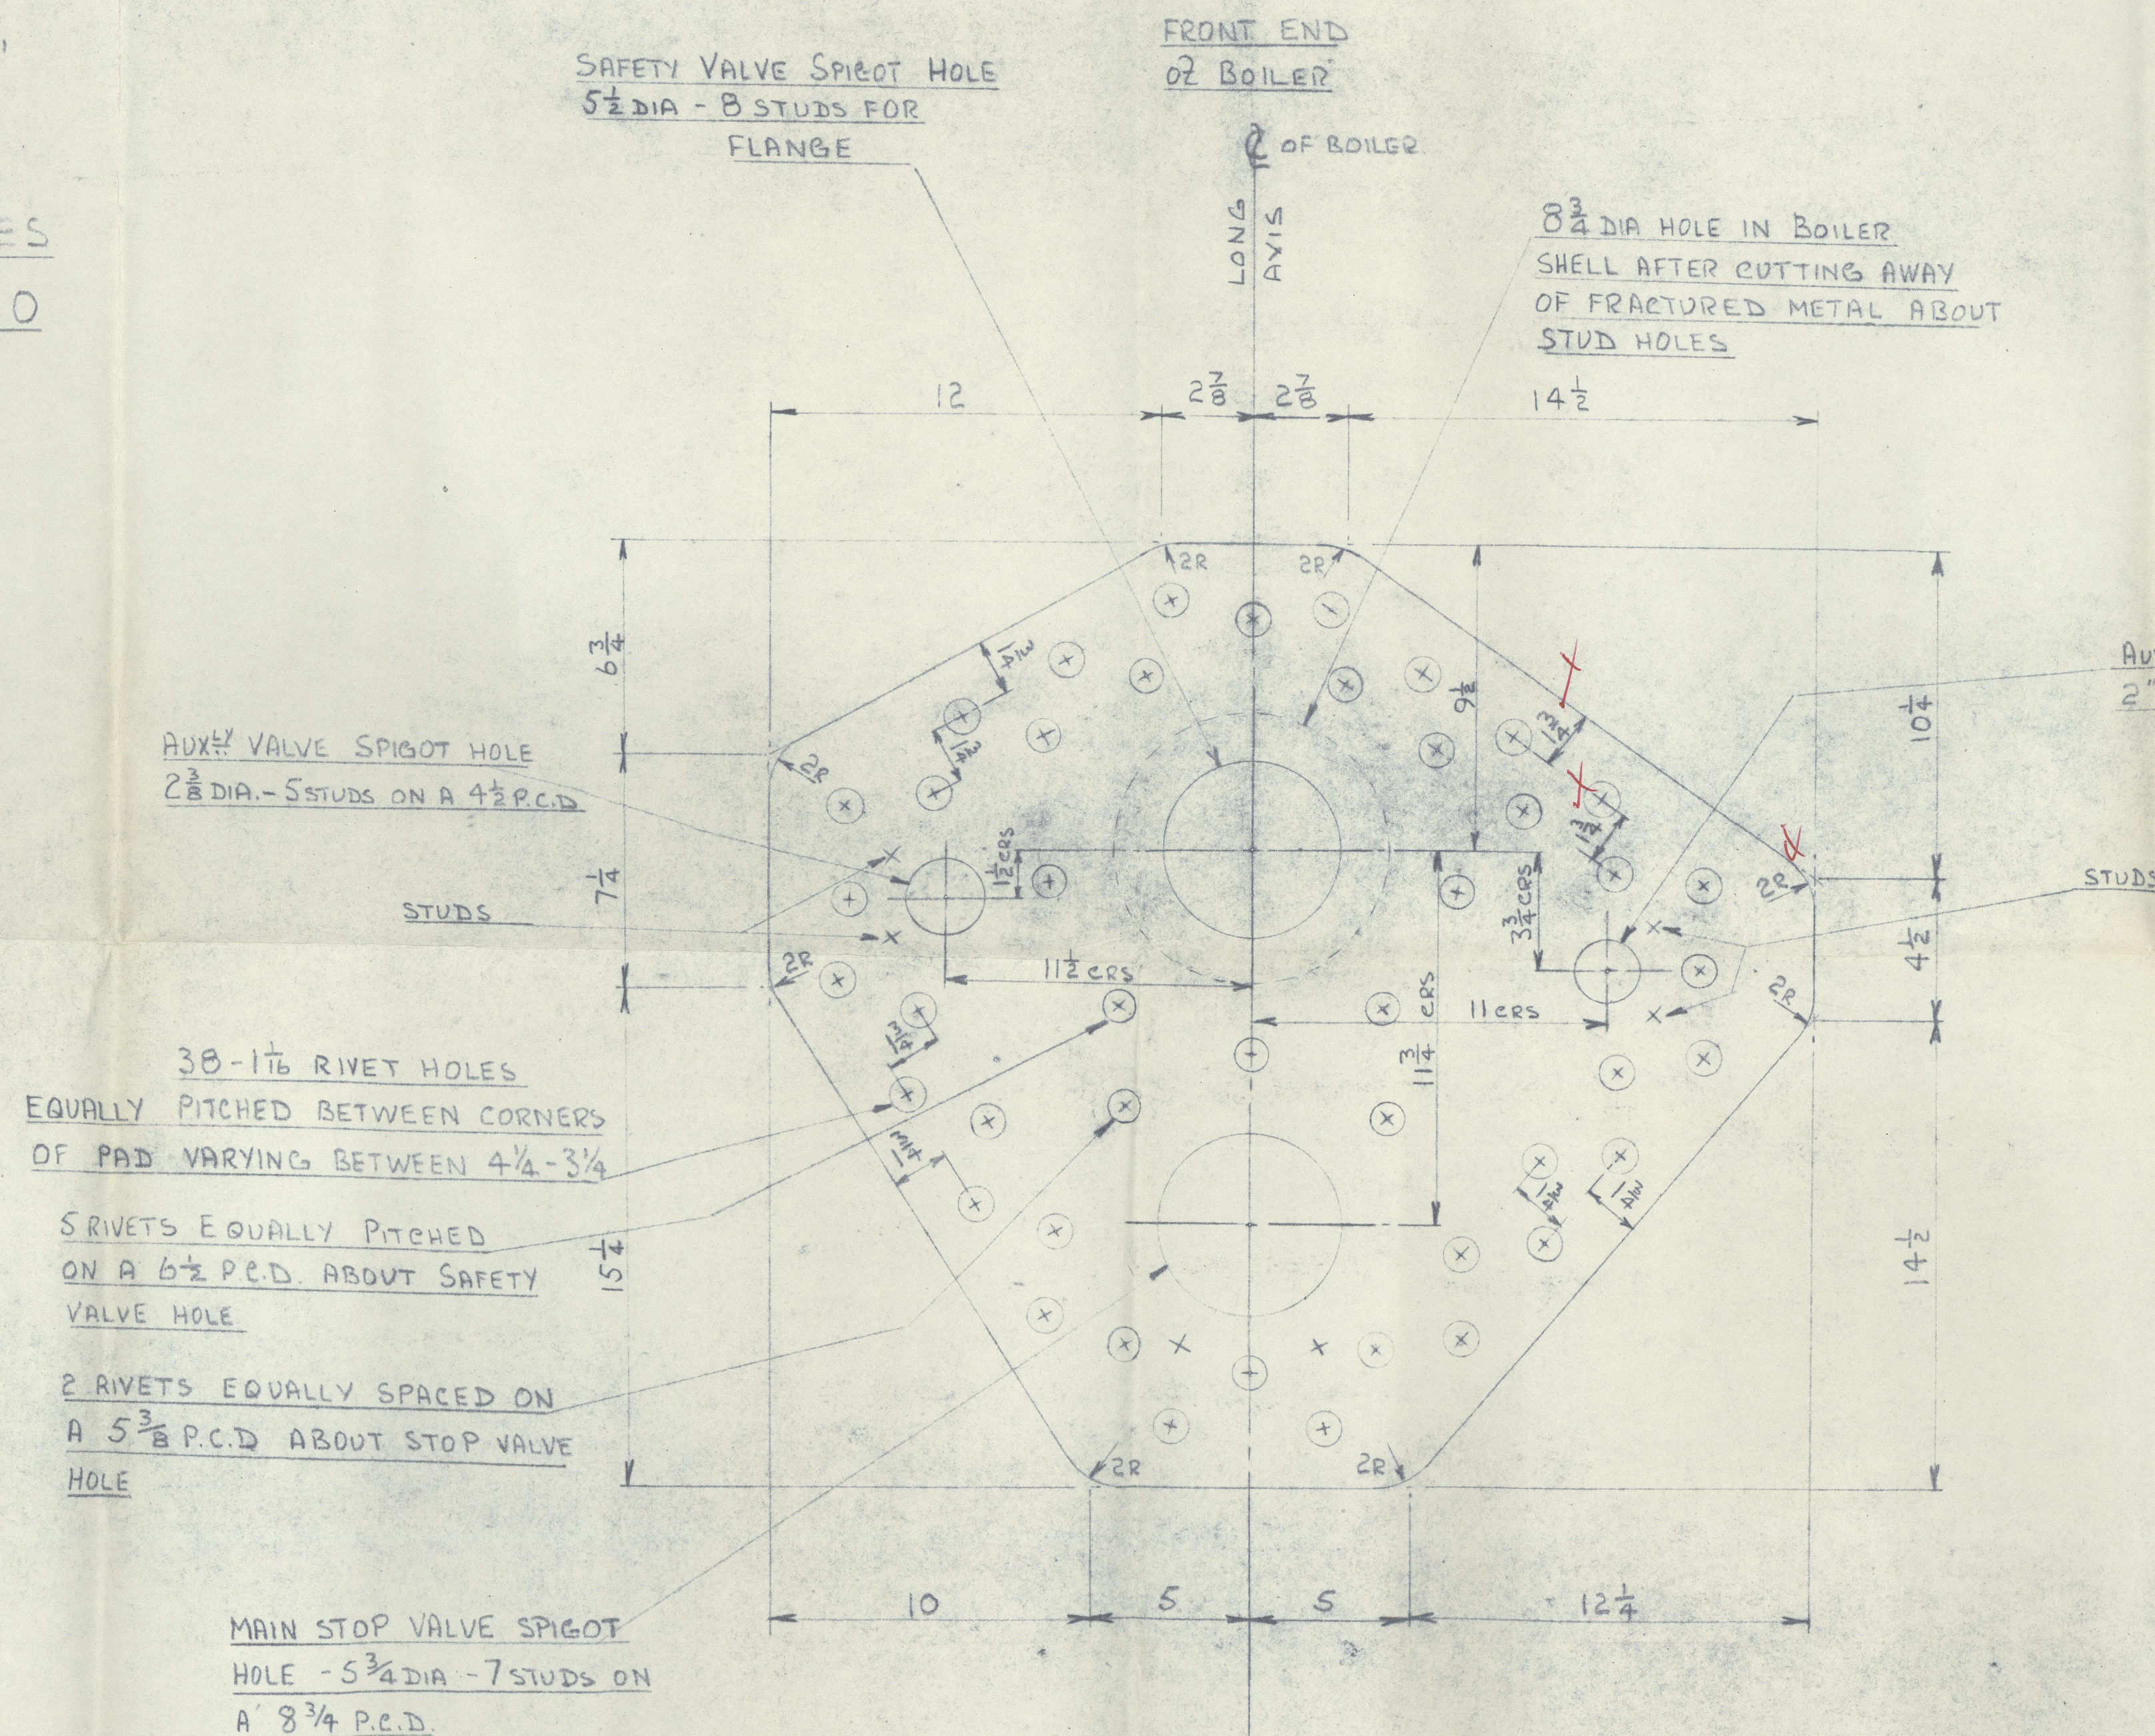

WORKING PRESSURE :- 150 LBS/D"

TYPE :- SCOTCH - COAL FIRED.

SHELL THICKNESS :- $\frac{31}{32}$ "

COMPENSATING PAD THK :- 1"

SHELL :- 14'-0" INT. DIA. - 10'-5 $\frac{1}{16}$ " LENGTH

NOTE :- HOLES IN PAD FOR VALVES TO BE CAULKED ABOUT BOILER SHELL.

TUG S.S. "TEMPLE CROSS"

BOILER REPAIR IN WAY OF STEAM MOUNTINGS

DETAILS OF PROPOSED COMPENSATING RING

SCALE :- $\frac{1}{4}$ - FULL SIZE

MAT: BOILER STEEL

ALL DIMENSIONS IN INCHES

See attached sketch.

LLOYD'S REGISTER OF SHIPPING
 LONDON

