

OFFICE

DRAWING N° 3.

PROFILE AND DECKS PLAN.

YARD N° 789.


SCALE 1/4" = 1 FOOT.

CLASS 100 & A1 STEAM TRAWLER.





DIMENSIONS : 133'0" B.P. x 26'0" MLD B. x 14'0" MLD D.

DATE SUBMITTED TO LLOYD'S

DATE APPROVED BY LLOYD'S


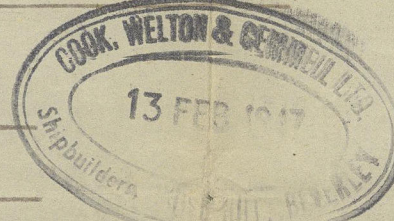


Similar to No 777 (133'5" x 25'5" x 13'5")

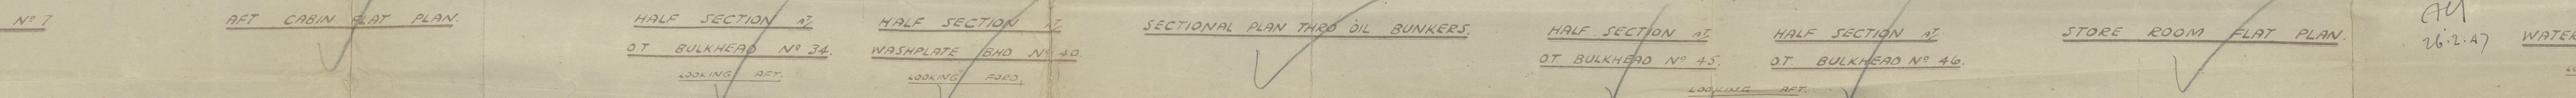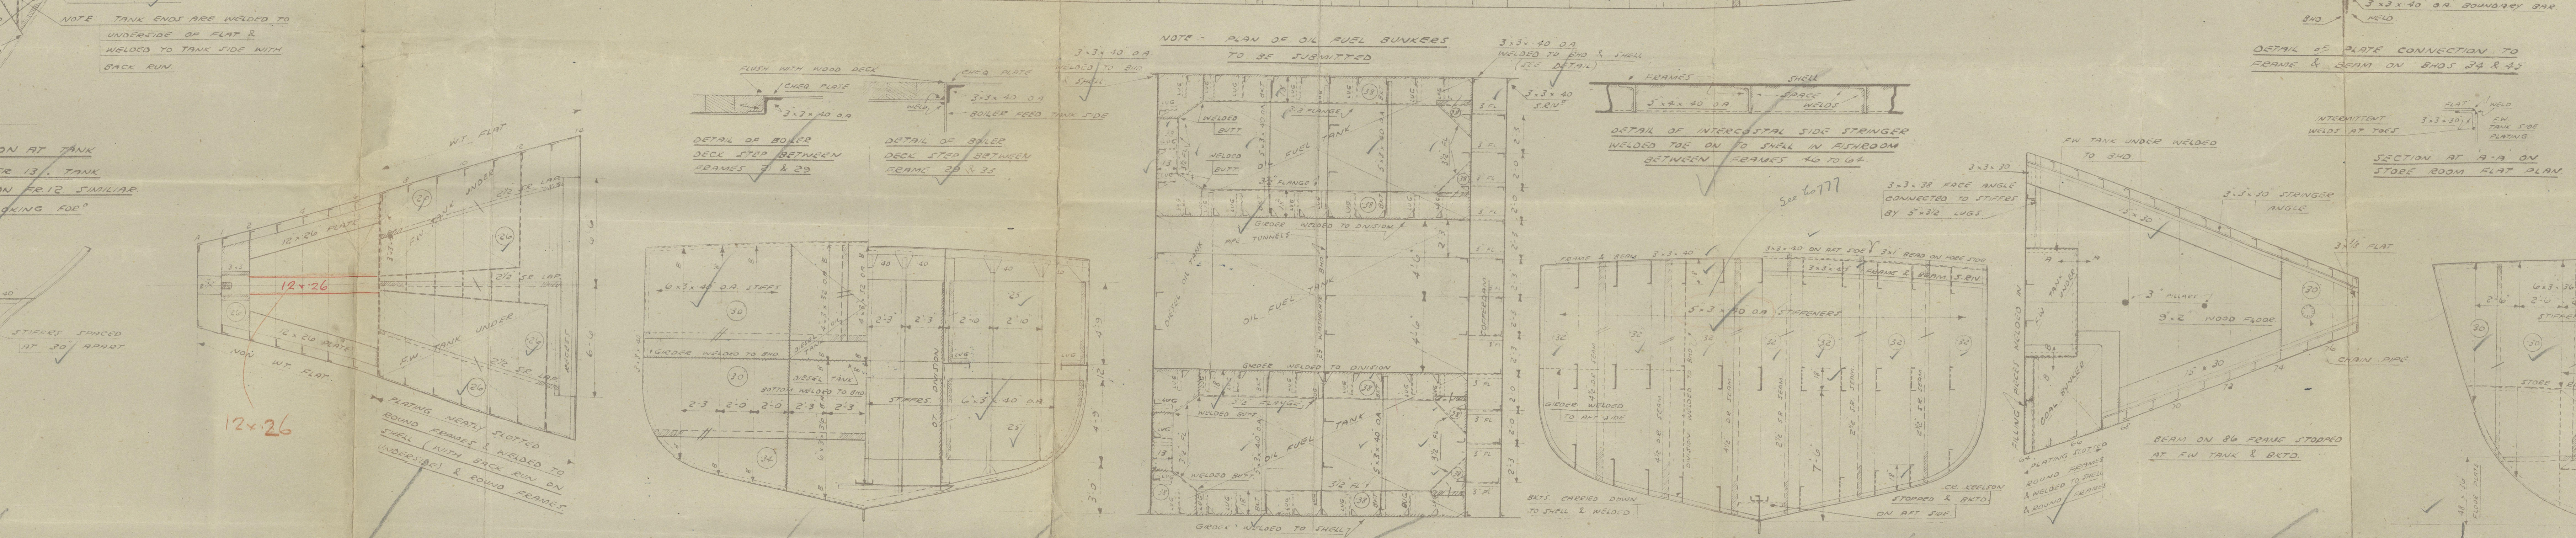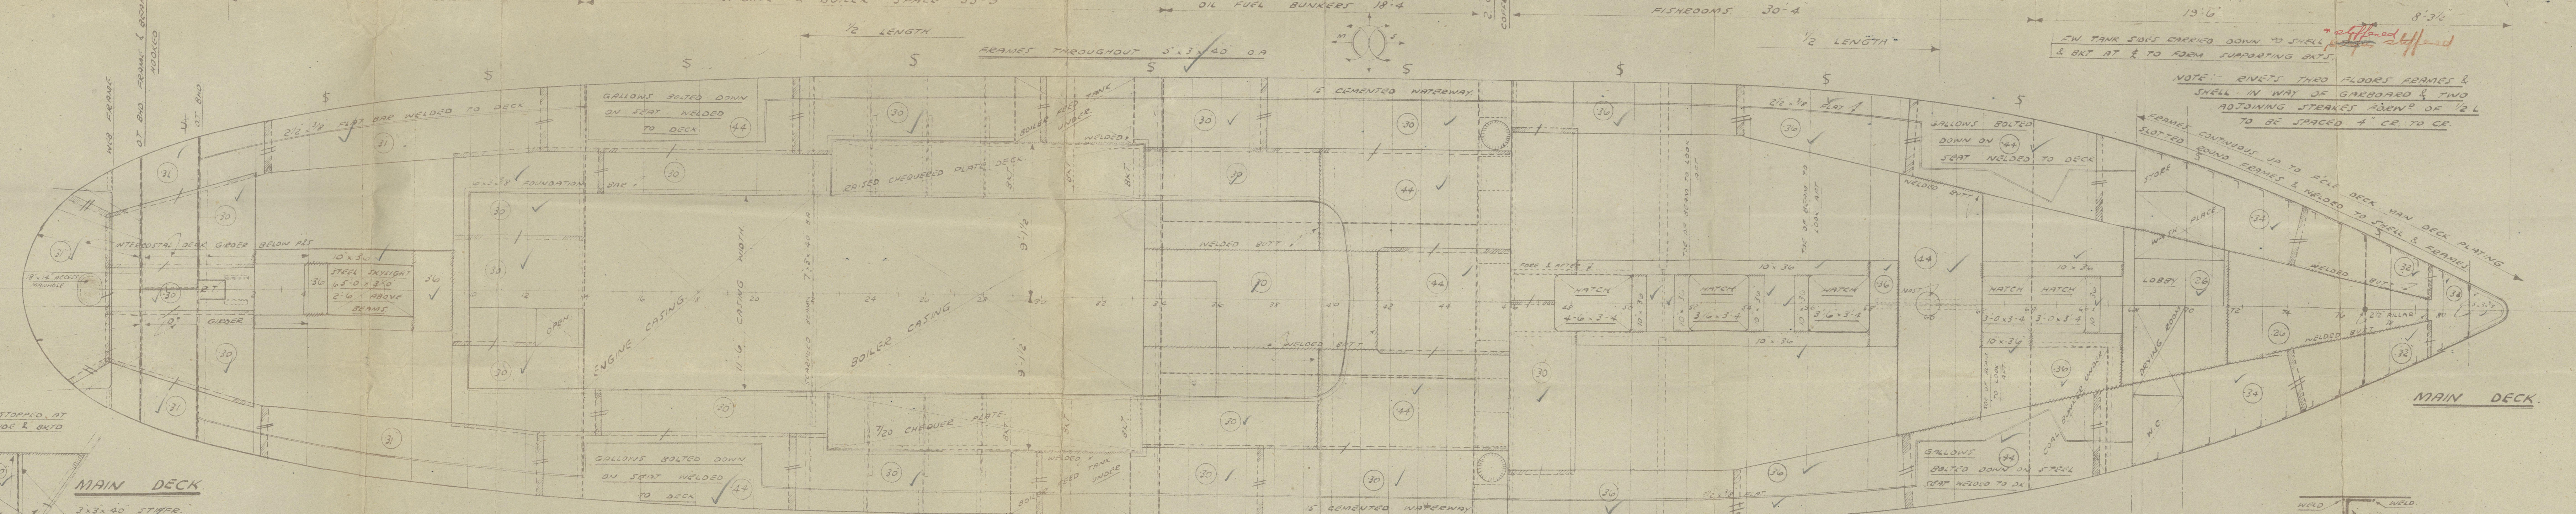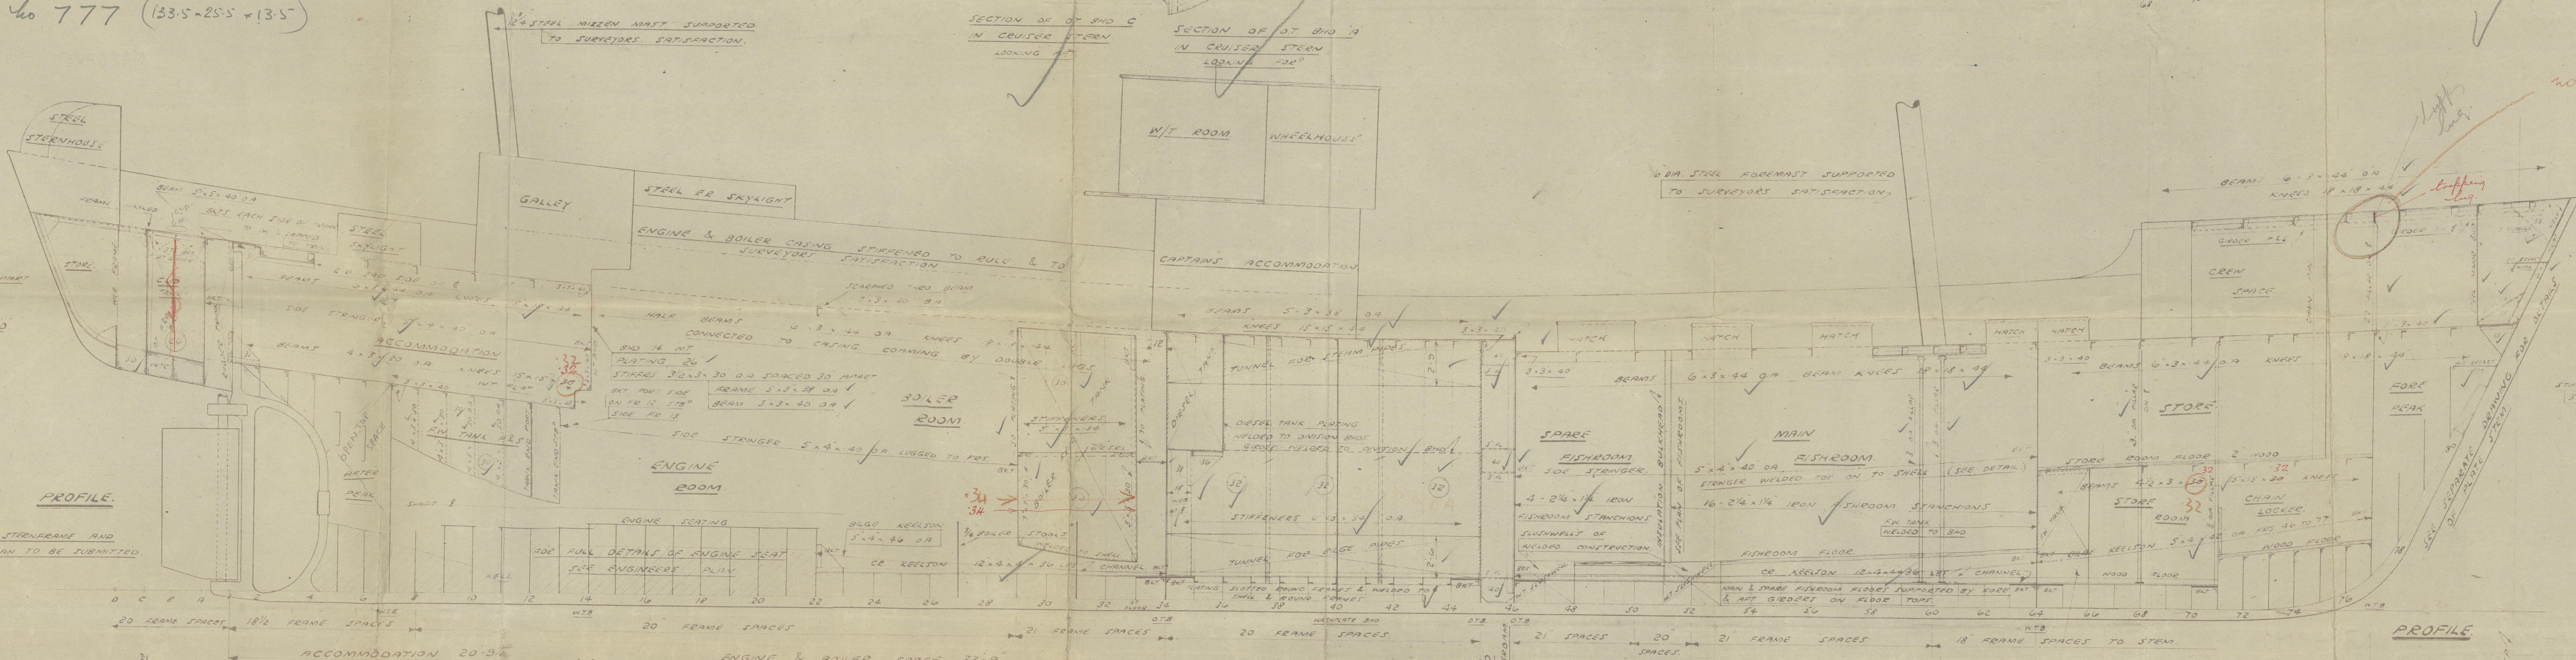

100-50960-51800



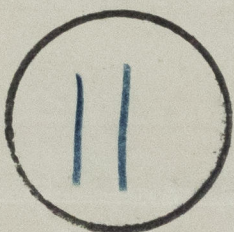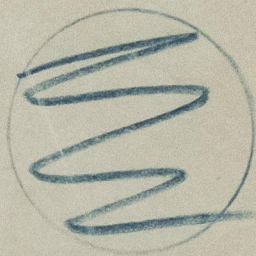

"MARGARET WICKS" ★

RETAIN

COOK, WELTON & GEMMELL

YARD No 789

—  
PROFILE & DECKS



© 2020

Lloyd's Register  
Foundation

003895-003905-0091