





18.05

PROFILE & DECK PLAN

STEEL SCREW TRAWLER
S.S. CONCORD

No 351.


DIM:- 120' 7 1/2" x 21' 9" x 11' 9" DEPTH OF HOLD
SCALE 1/4" = 1 FOOT.

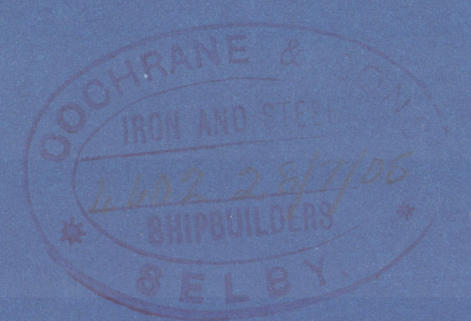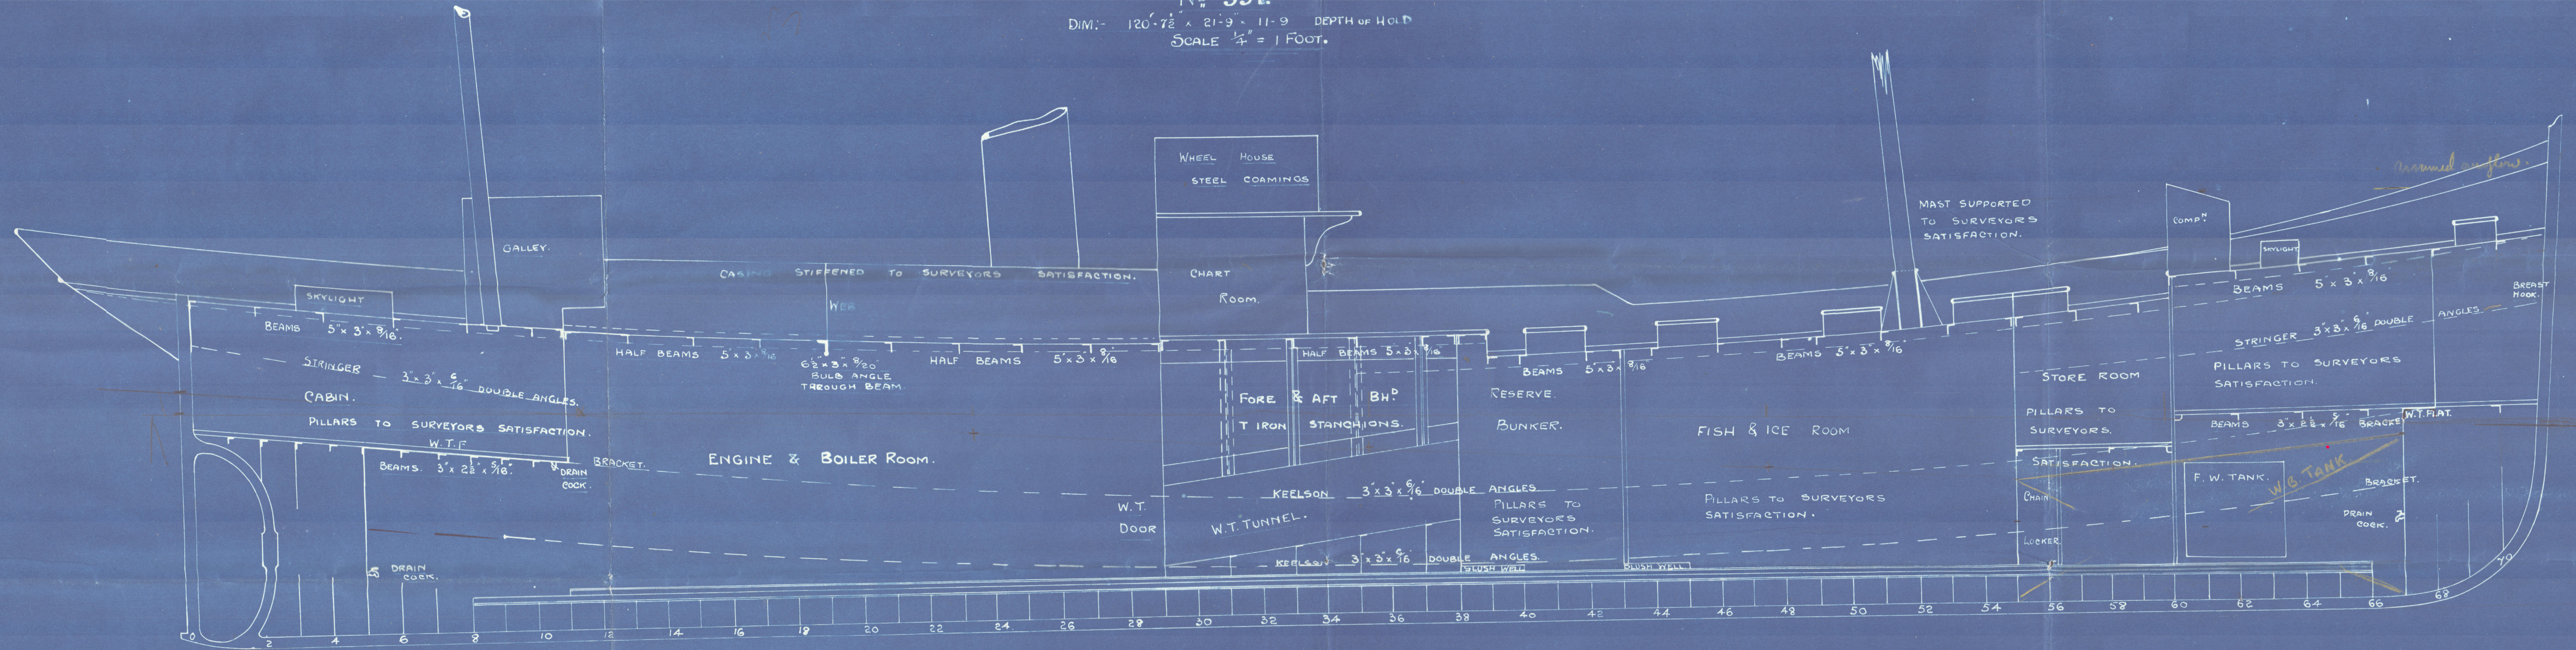

Profile

Messrs Cochrane & Sons

No 351

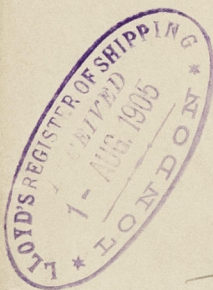

of Concord

Hull Report No 17404

Truman X

003906-003913-0105



© 2020

Lloyd's Register
Foundation