

1.8.05

# MIDSHIP SECTION.

— STEEL SCREW TRAWLER. —

— S.S. CONCORD —

— No 351. —

DIMENSIONS 120-7½ x 21-9 x 12-6 DEPTH MOULDED.  
SCALE ½" = 1 FOOT.

TO CLASS 100.A.1. AT LLOYD'S FOR FISHING PURPOSES.  
ENGINE & BOILER CASING AS PREVIOUSLY APPROVED.  
DECK PLATED IN WAY OF E & B. CASING.

## LLOYD'S NUMBERS

½ GIRTH ----- 19.73  
½ BREADTH ----- 10.83  
DEPTH ----- 12.92  
43.48 1ST NO.  
119.42  
5192.3816. 2ND NO.


## PROPORTIONS

B TO L ----- 5.5  
D " L ----- 9.2

## EQUIPMENT.

1ST BOWER 5¼ CWTs EX STOCK  
2ND " 4¾ " " "  
3RD " 2½ " " "  
90 FATHOMS 1" CABLE  
60 " 6" HAWSER  
60 " 4½" WARP.

Cochrane & Sons  
Shipbuilders  
Selby.

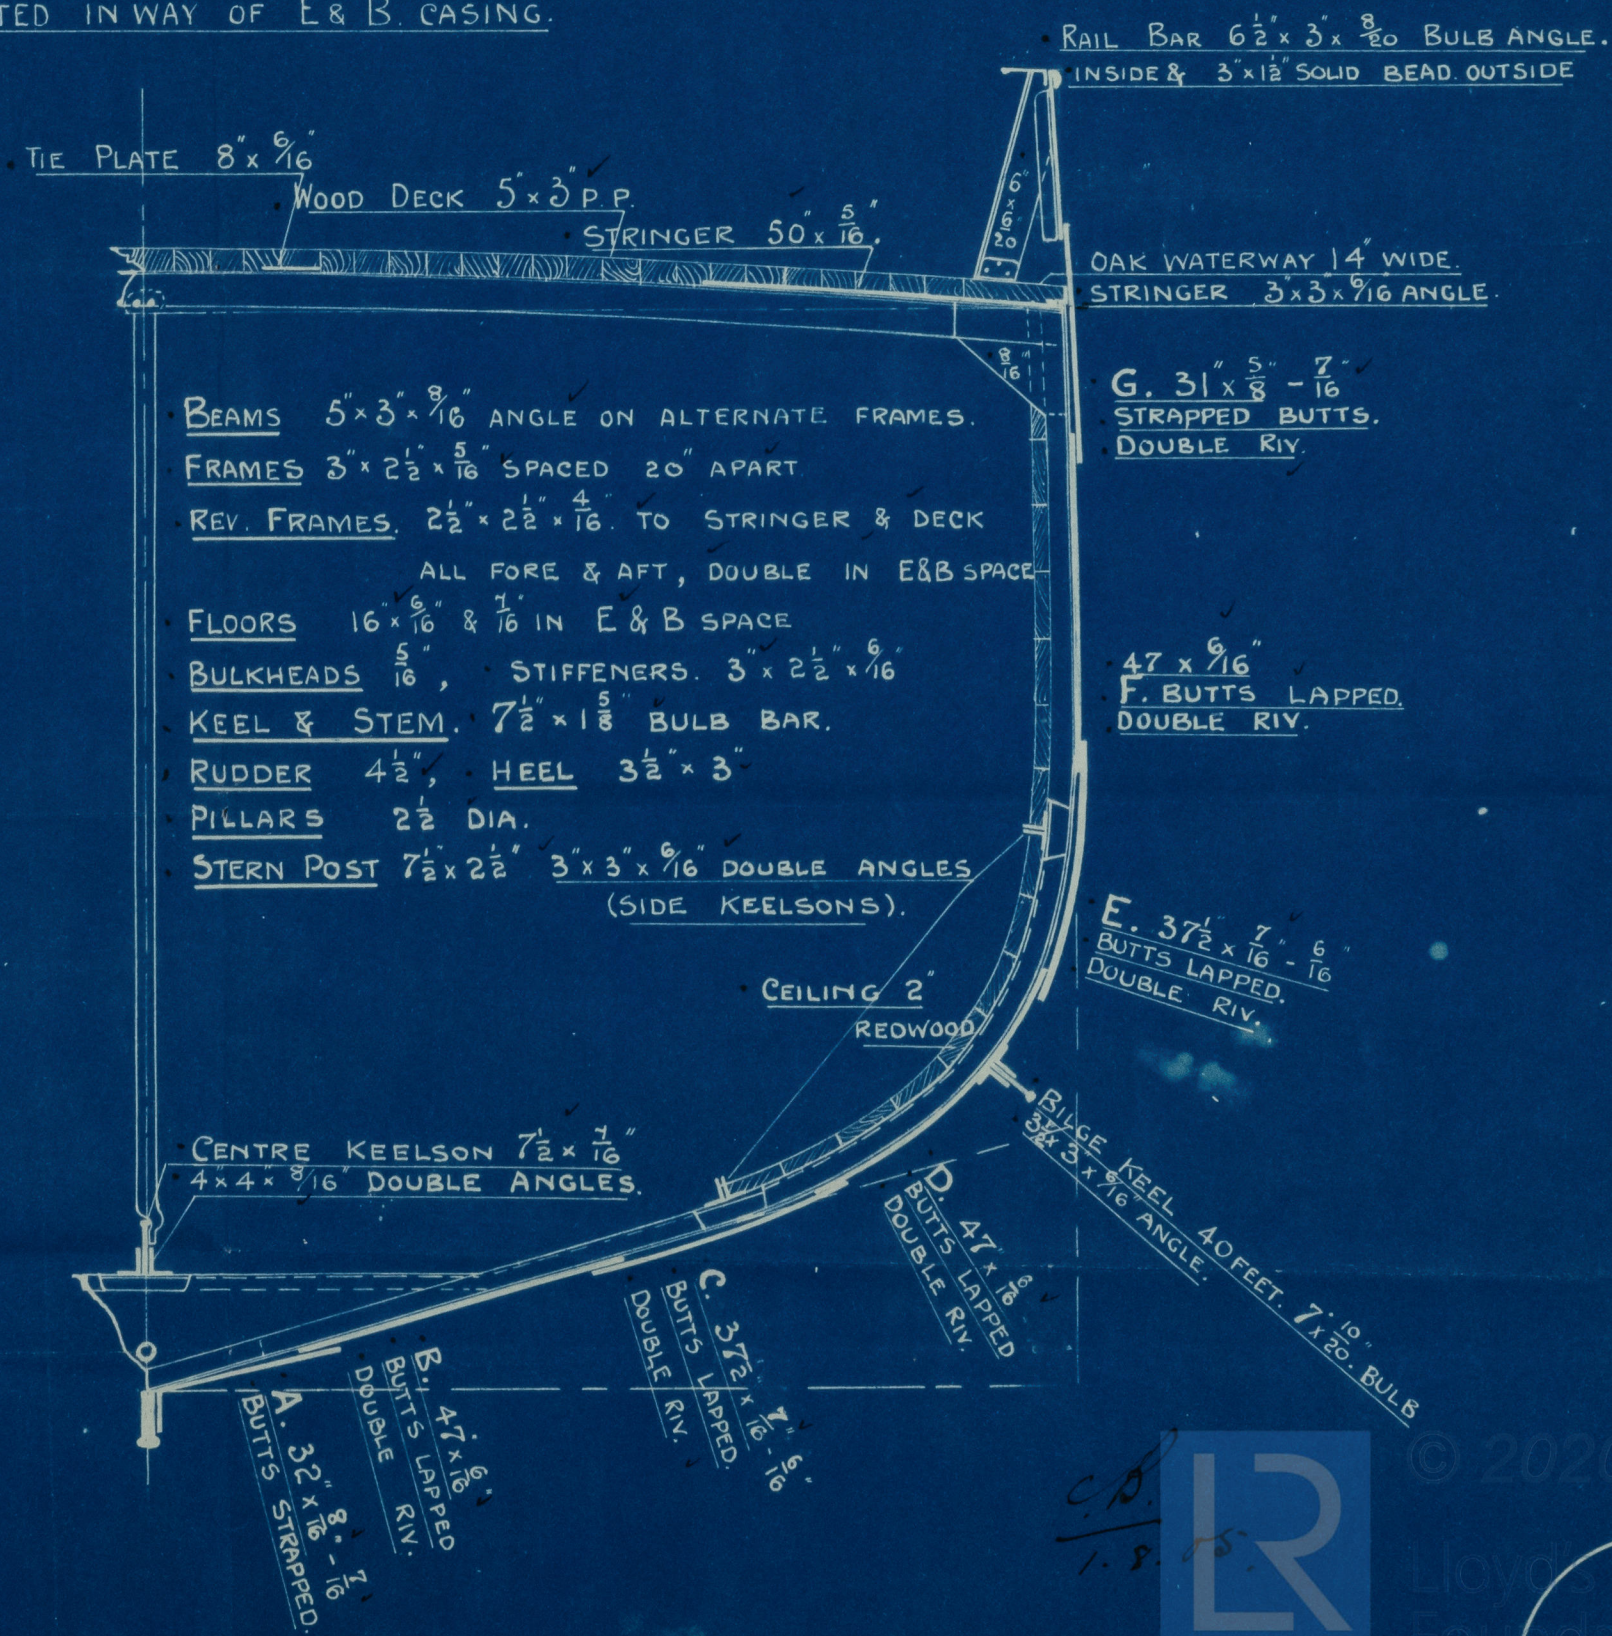

Midship section 351

9110-21500-906500




© 2020 Lloyd's Register Foundation



Midship Section

Messrs. Roeburne & Sons

No. 351

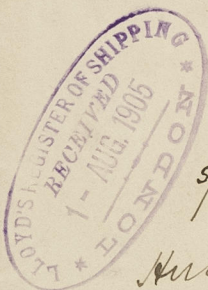

s/s 'Concord'

Hull Report No. 17404

TRUMAN X.



© 2020

Lloyd's Register  
Foundation

0039106-0039113-0106