


190'-0"
5'-0"
10'-9"
205'-9"



75
1263
6237
7.43
7.32
7
51.24 7.32
25 205
41.43
41.43
46.700
1.02
47.42
85
47.97

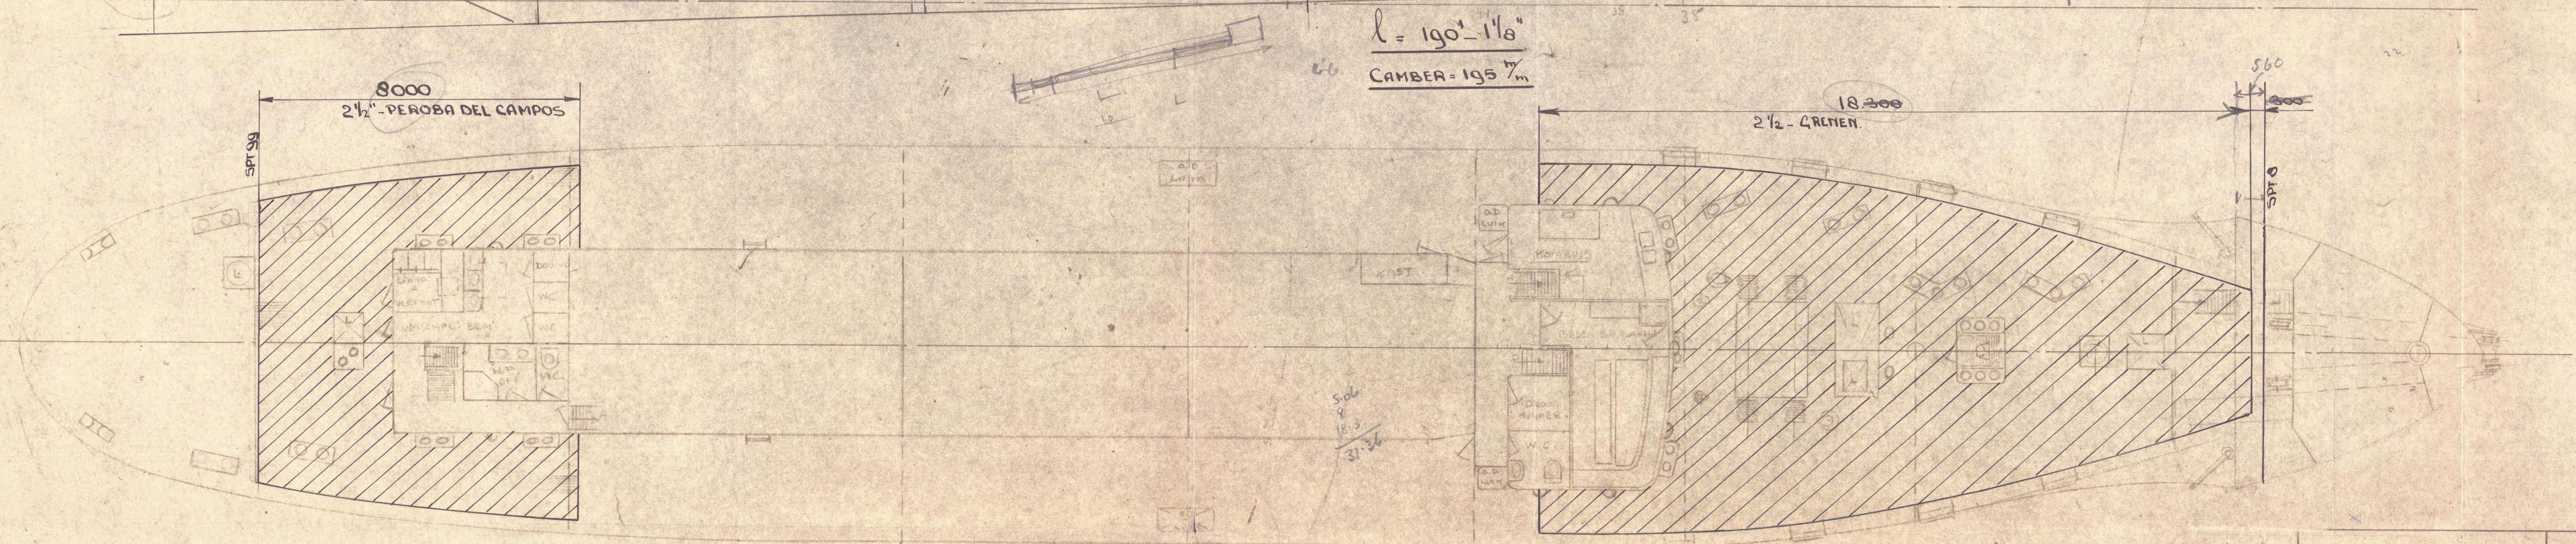

BENAMING		ONDERDEEL	MATERIAAL	OPMERKING 15 Sep. 1948	GEW. IN KG PER STUK	POST
SCHAAL	1/8" = 1'-0"	DATUM	AMST. DROOGDOK MIJ. N.V.			
GETEK.	1/4"	1/5-1/1	WALVISCH JAGER / EX FLOWER CLASS CORVET			
GEALQ.			ALGEMEEN PLAN			
GEZIEN						
GEWIJZ.						
VOOR BEW. TEK. ZIE N 785		NIEUWBOUW		ORDER 10 2020		
TEK. No:		P. 1050 Lloyd's Register Foundation				

003948-003957-01718


21

General Argt

5 1/2 A.M. 10.

now Eugene Vinke

Rotterdam. 22.9.18.

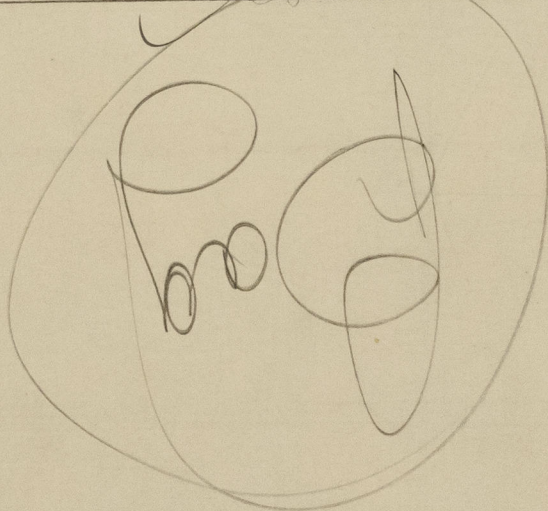


RETAIN

23 SEP 1948

Rotterdam

5 1/2 A.M. 10.

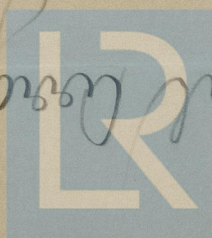

© 2020

Lloyds Register
Foundation

003948-003957-0178