


Ship's Name - "RANELIA" (ex "POINT PELEE PARK")

Official No. 173262

Memorandum of alterations reported since ship was surveyed for assignment of Load Lines.

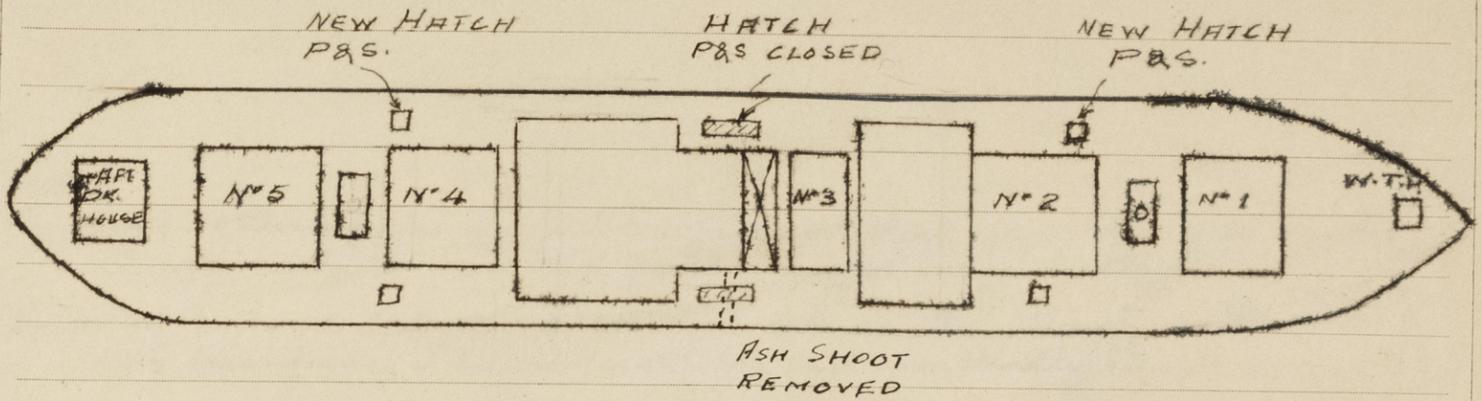

*A. F. Cantello*

Surveyor to Lloyd's Register.



© 2020

Lloyd's Register Foundation