



SCALE 1:10



(existing).

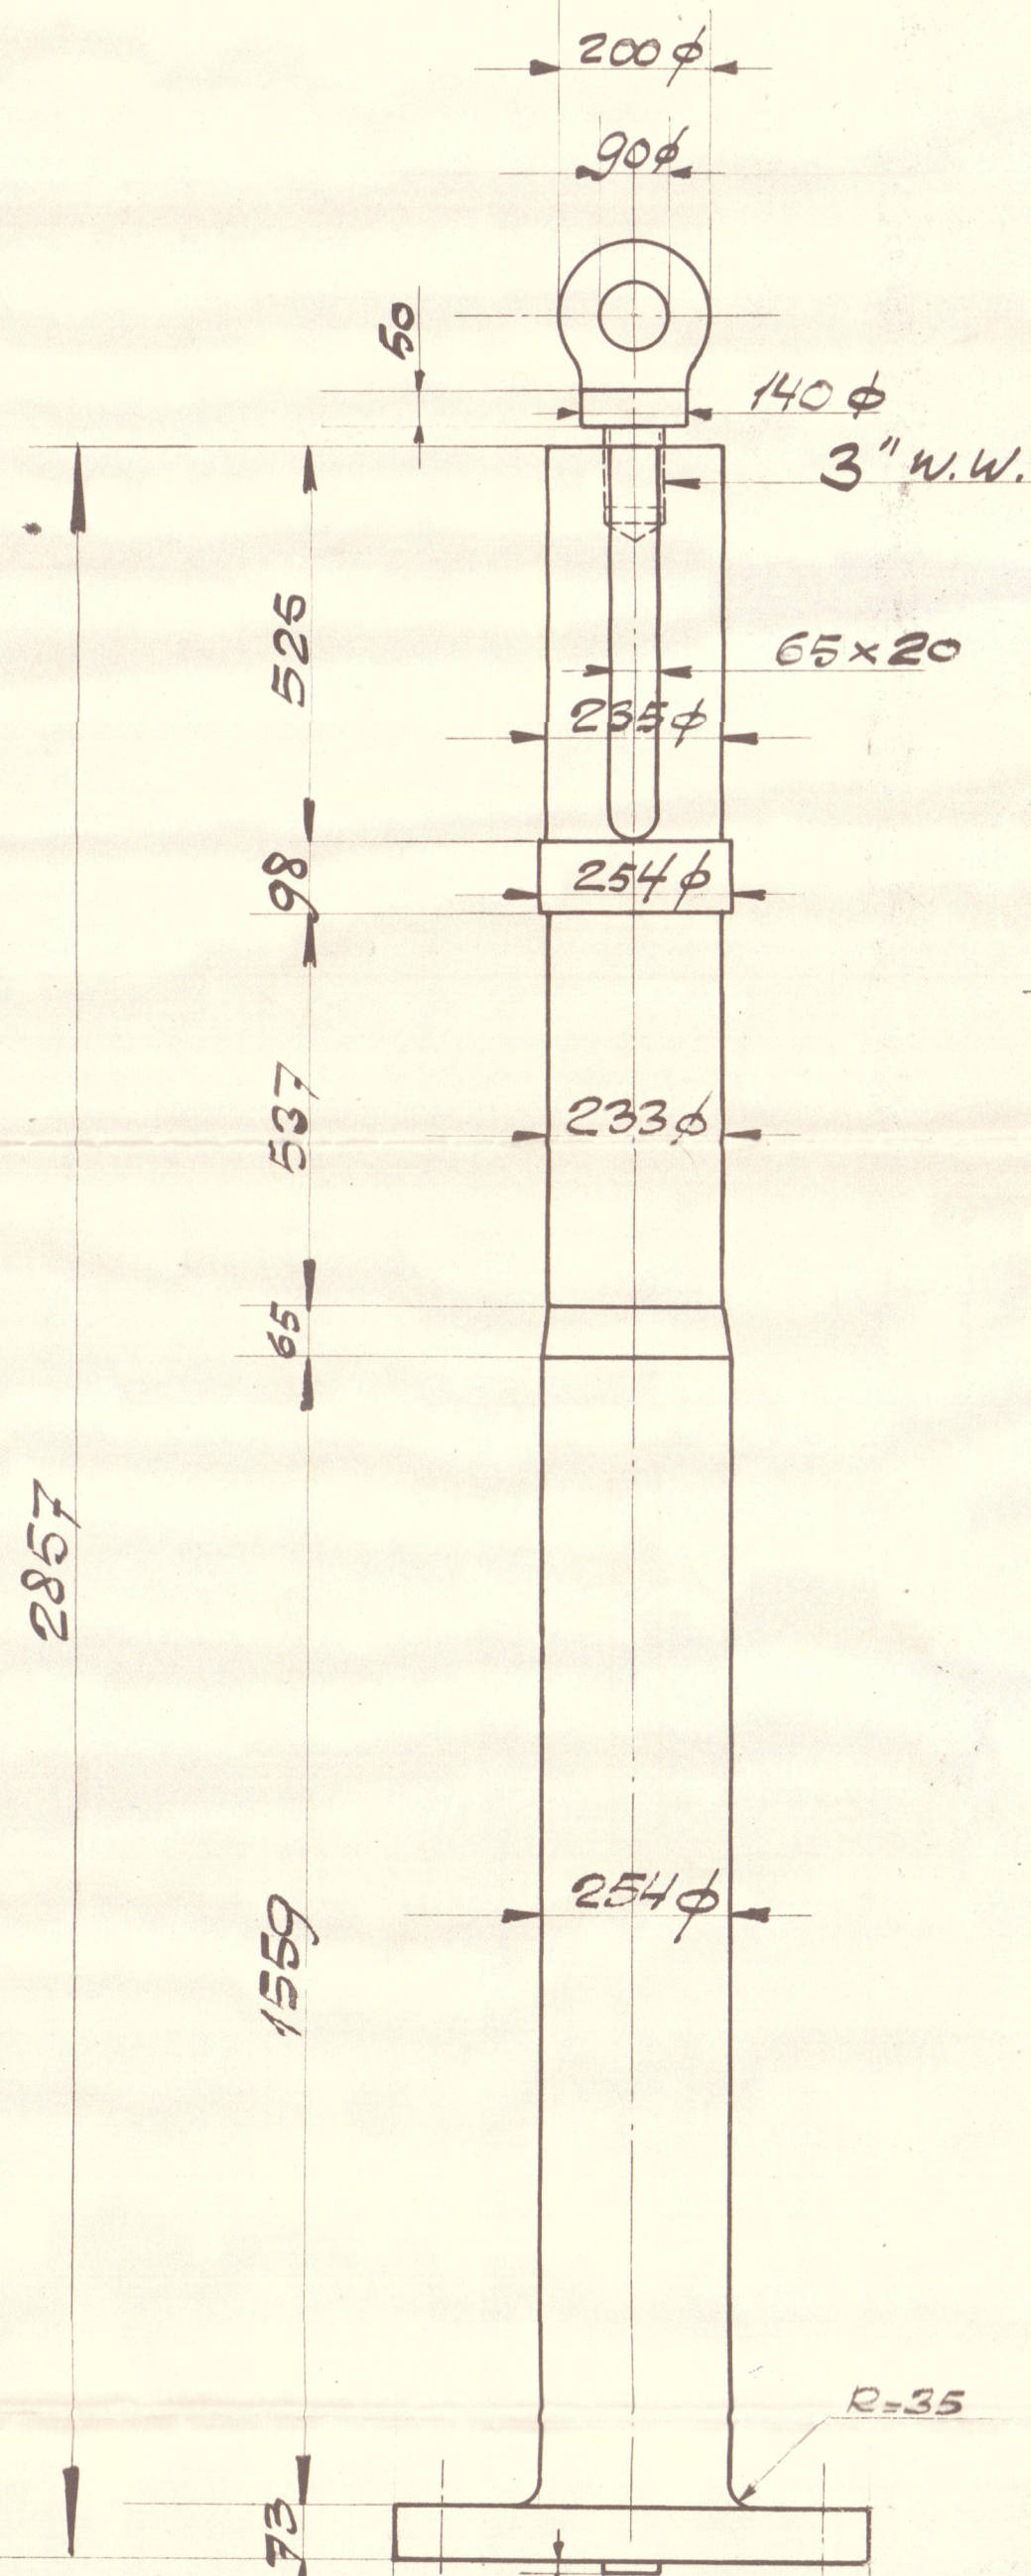

SCALE 1:25

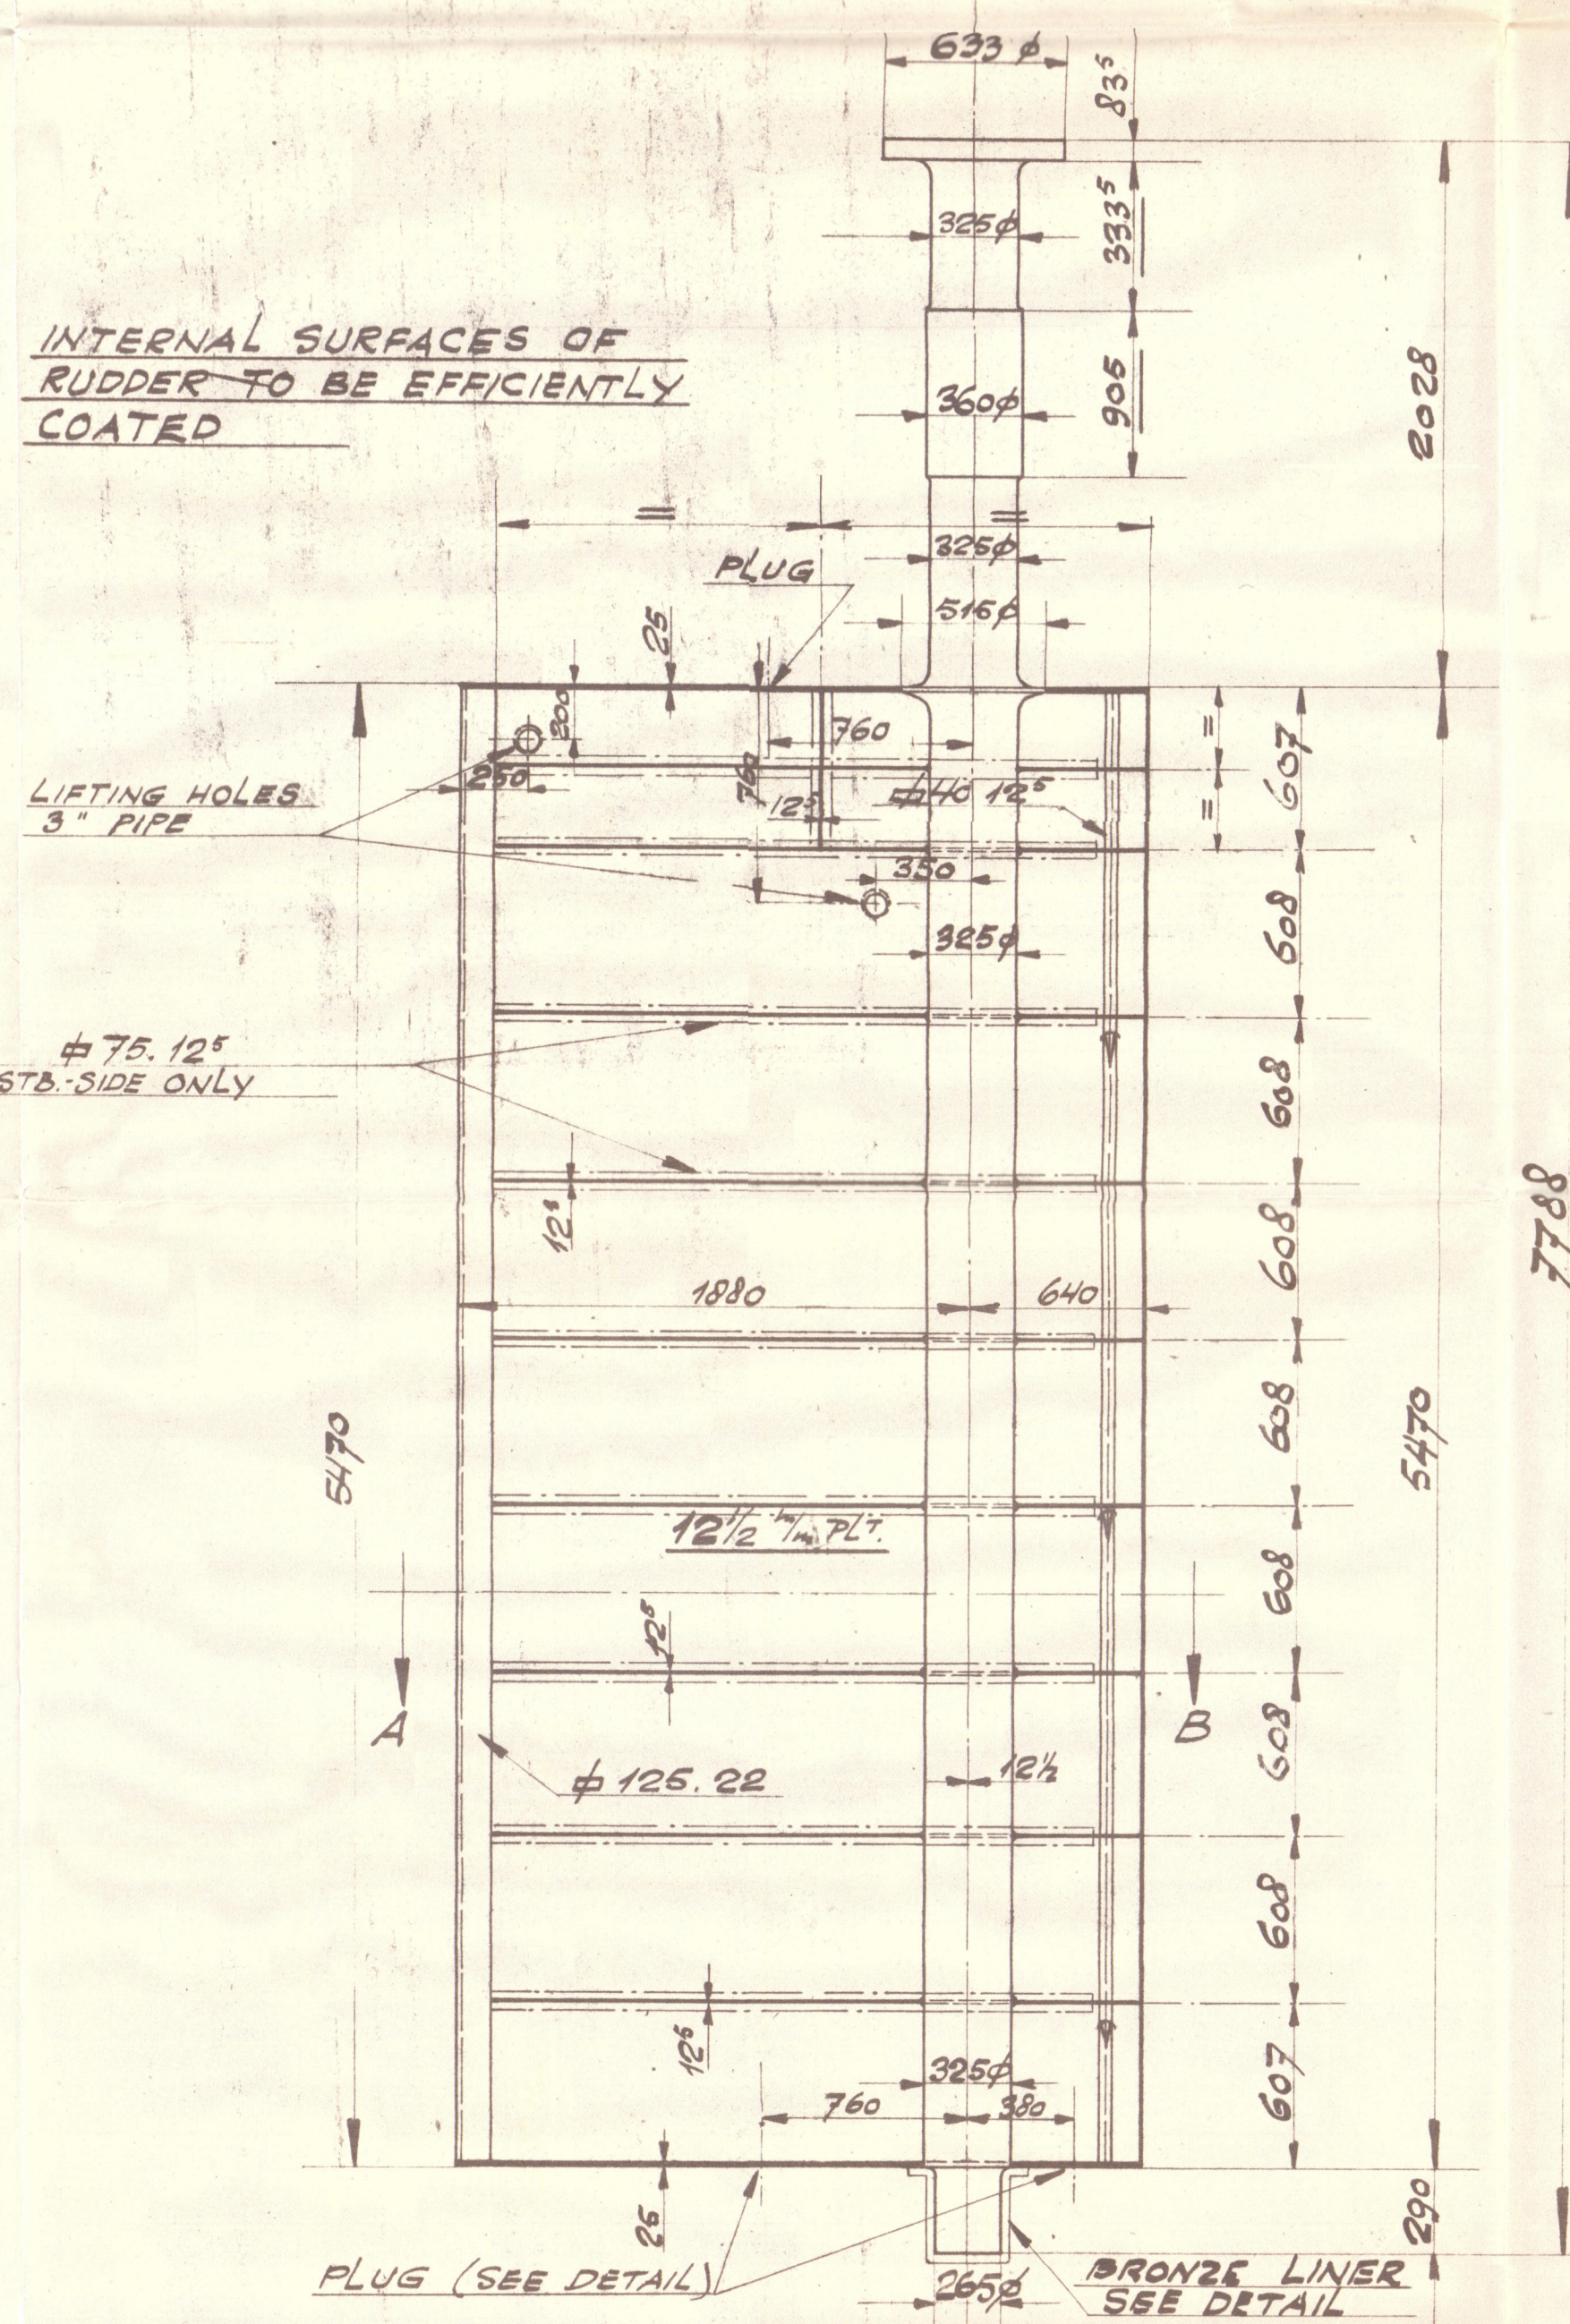


SCALE 1:10

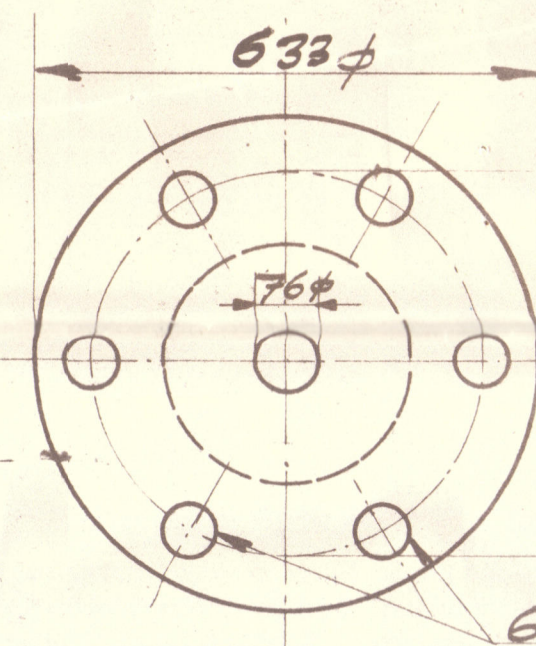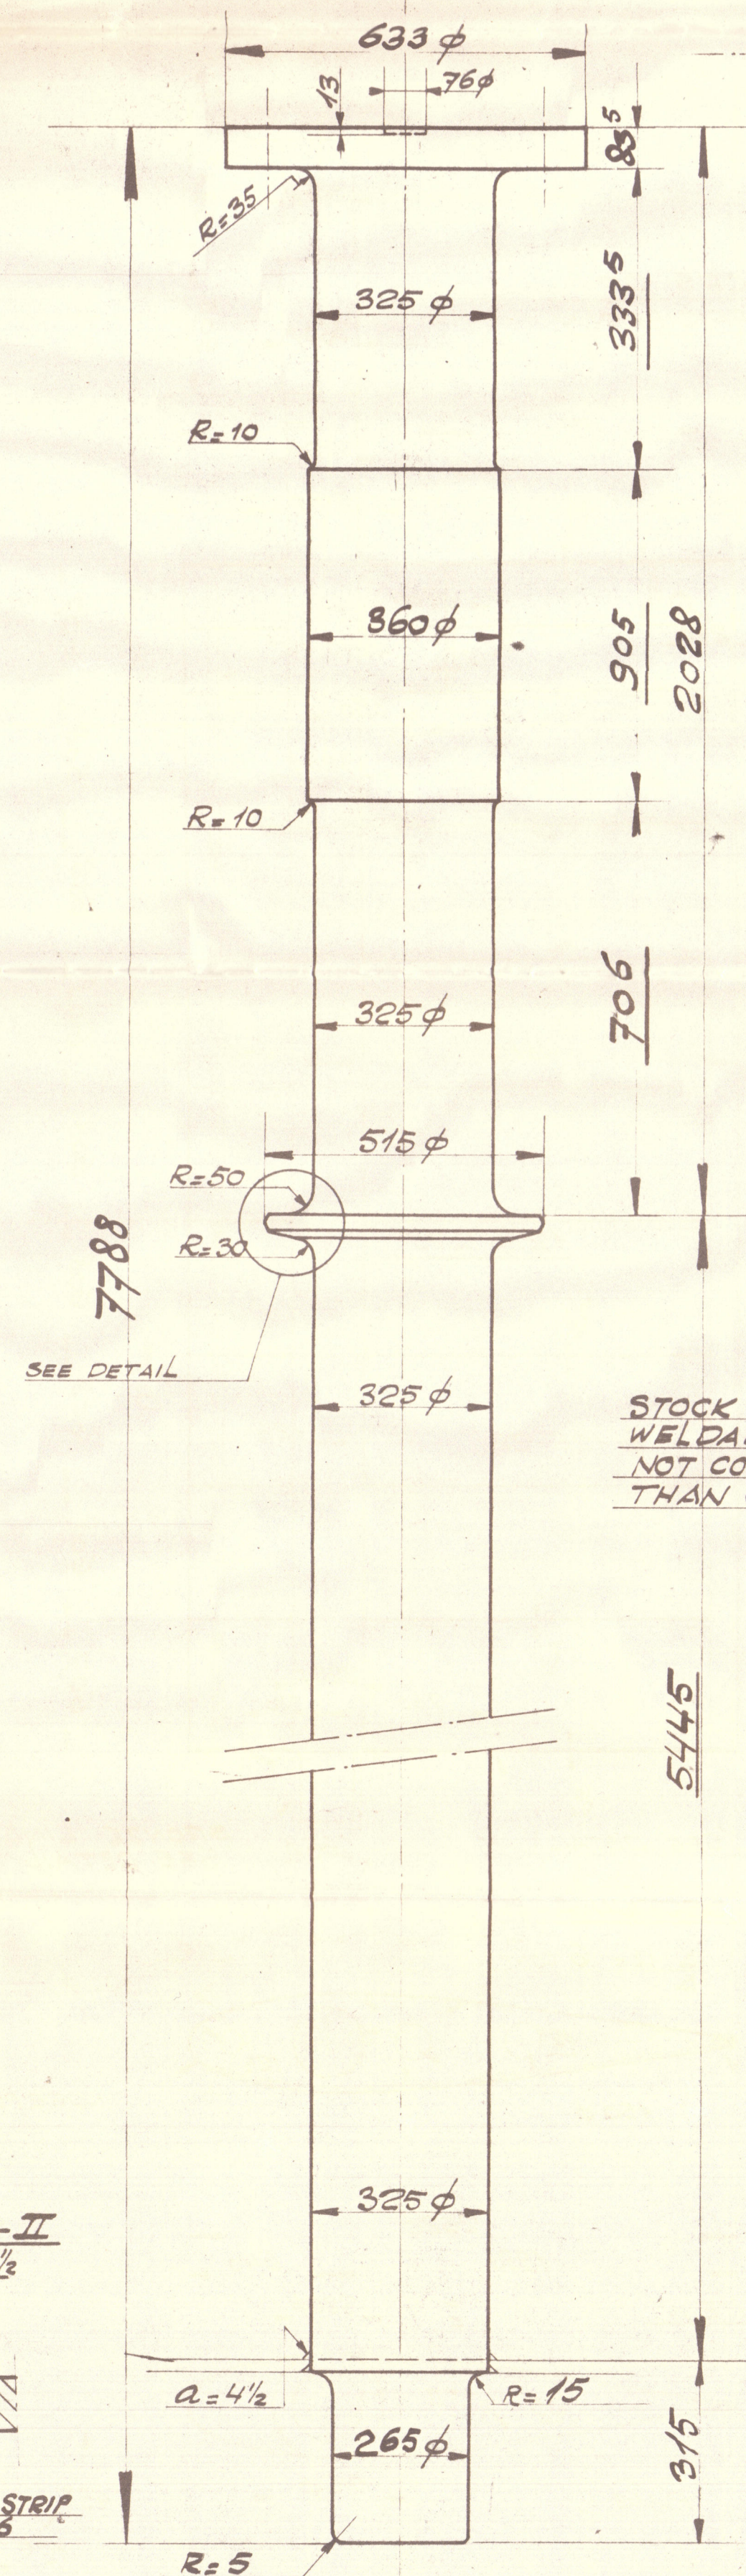


MEASUREMENTS AT OUTSIDE RUDDERPLATE


SCALE 1: 10

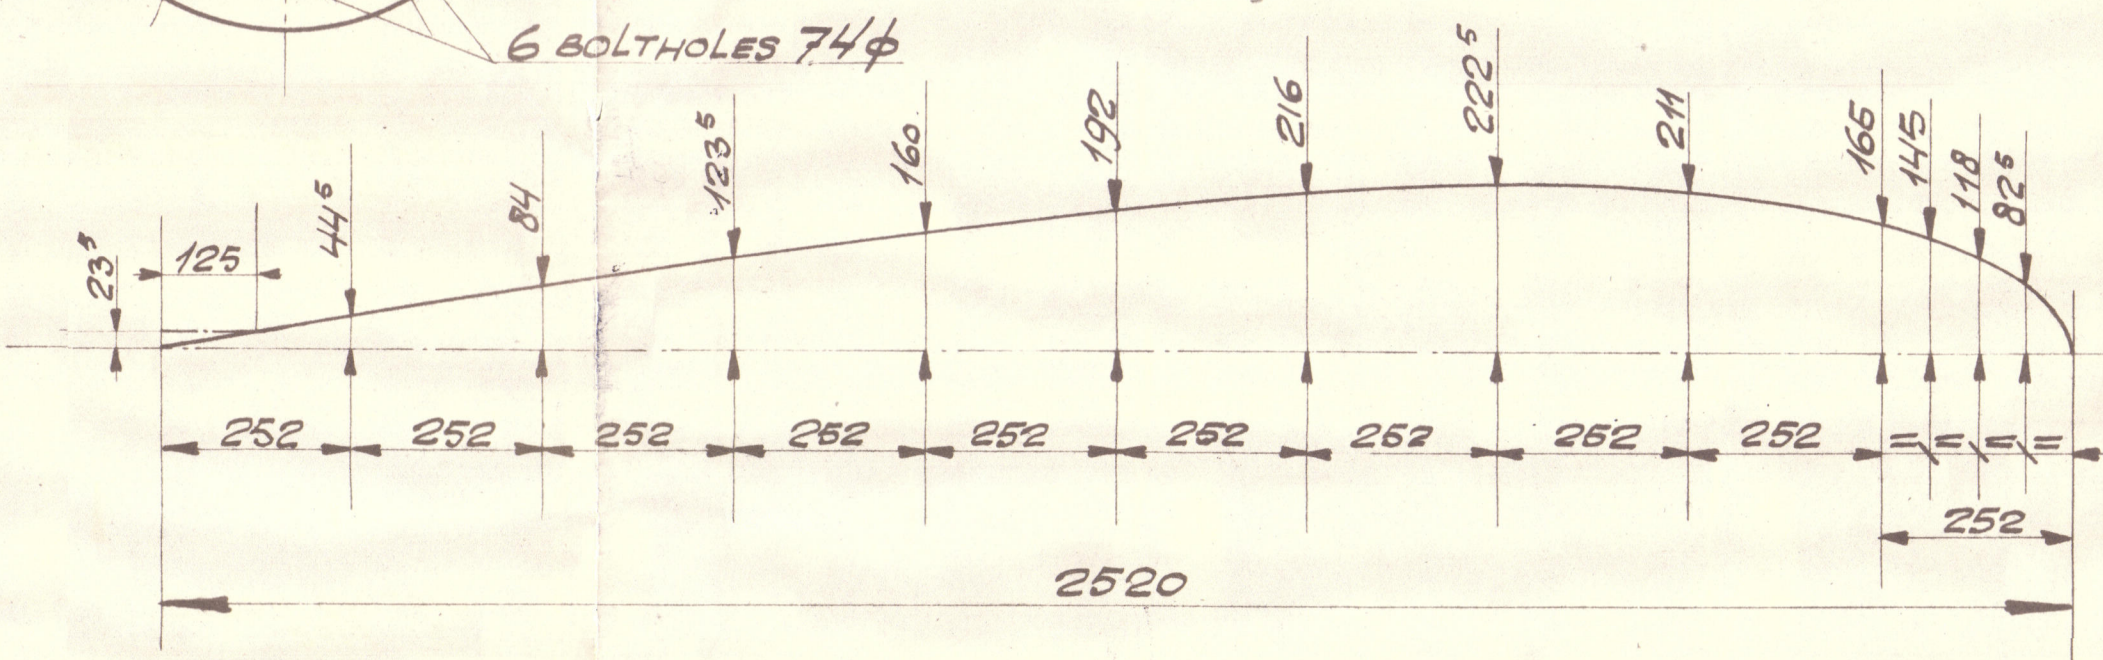



SCALE 1:5

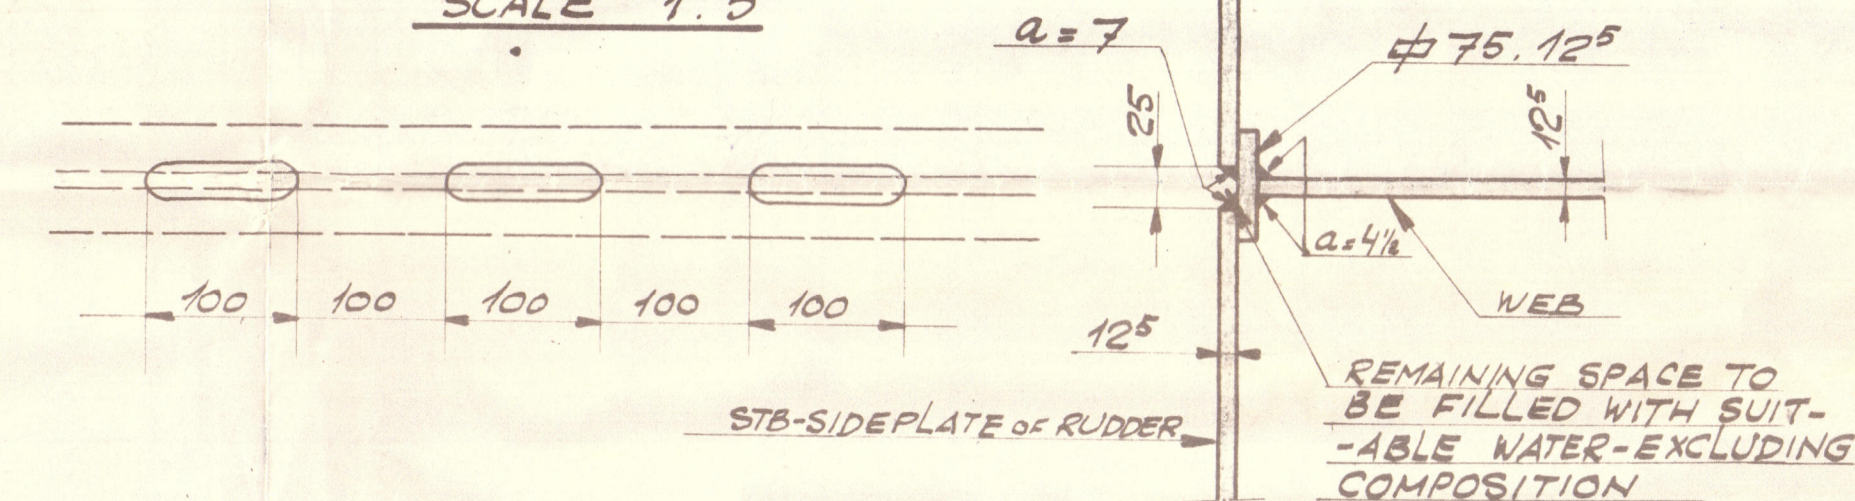

SCALE 1:1

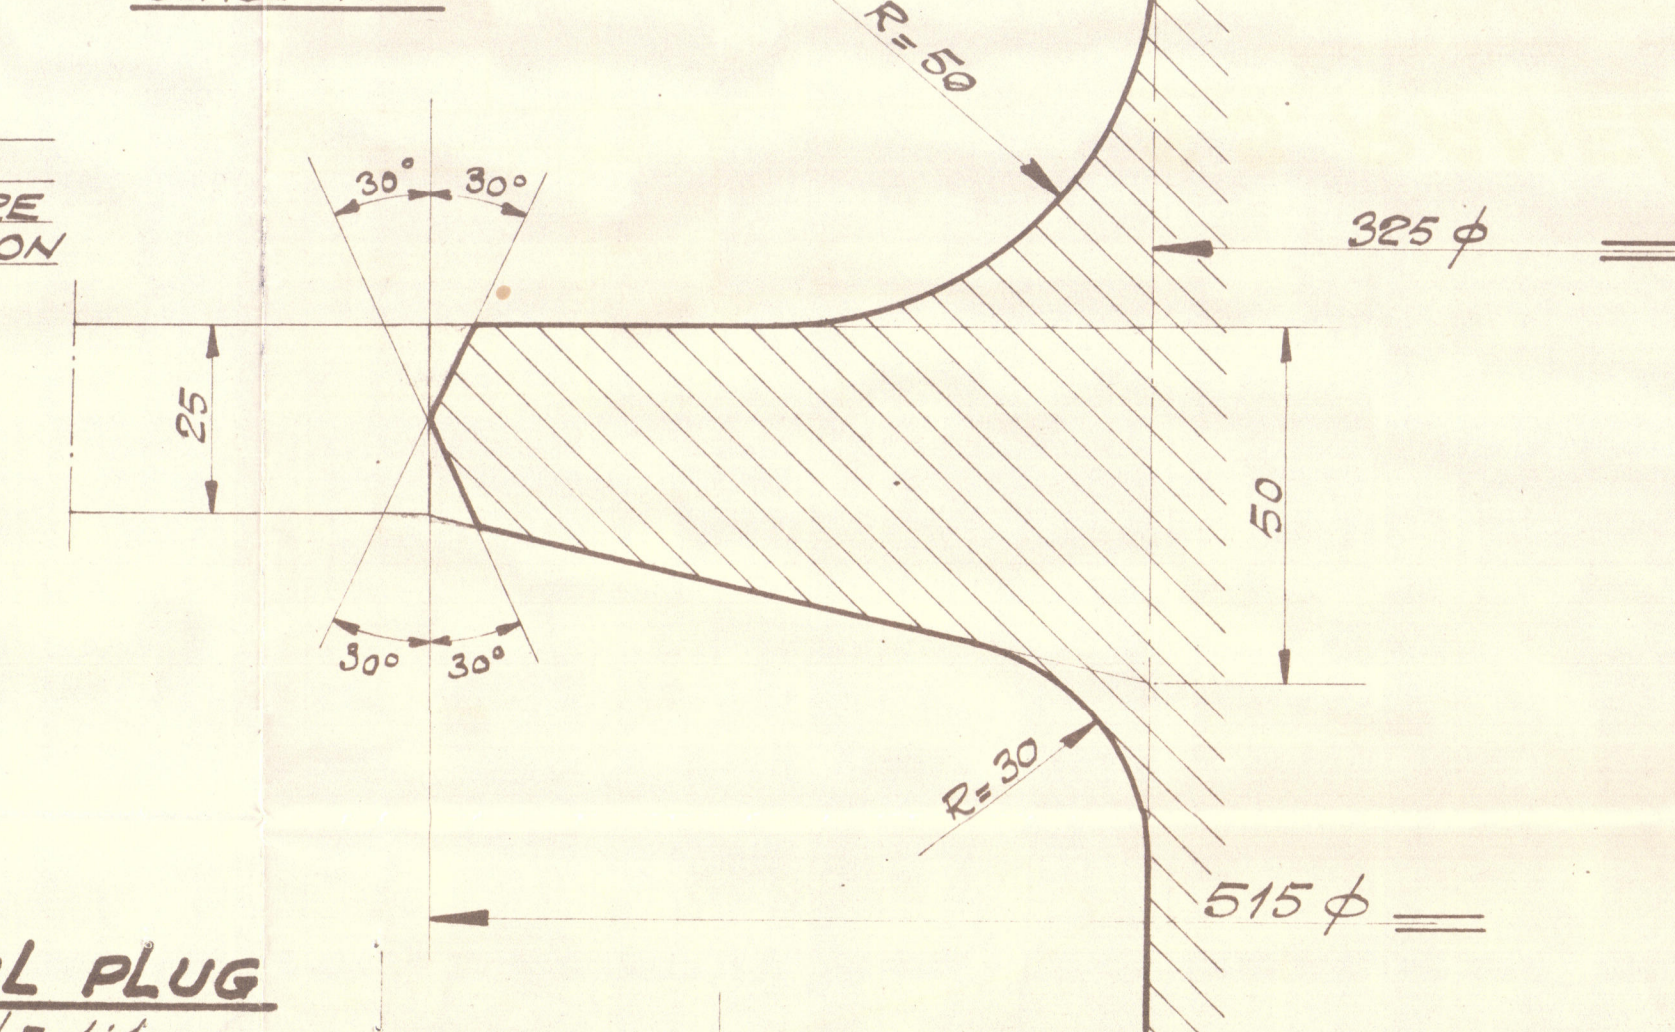

SCALE 1:1

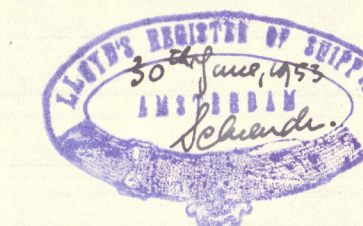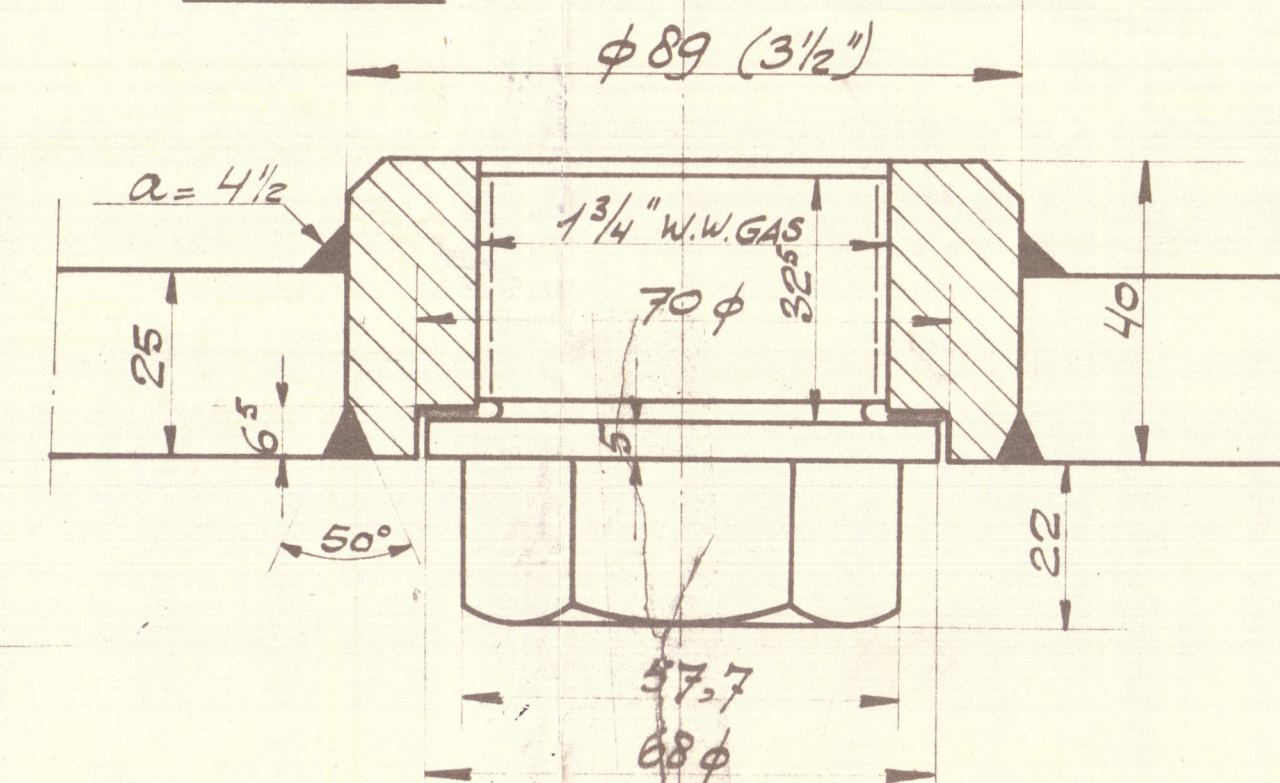

"As fitted"

EC. 2. S. C-1

RUDDER

SCALE 1:25, 1:10, 1:5, 1:2½, 1:1

BELONGS TO AMSTERDAM REPORT

No. 60929

DRAW.S. 6073

NETHERLANDS DOCK & SHIPBUILDING CY 22-6-63

003958-003963-0268

Foundation

NOTE: WELDING IS GIVEN IN THROAT THICKNESS