
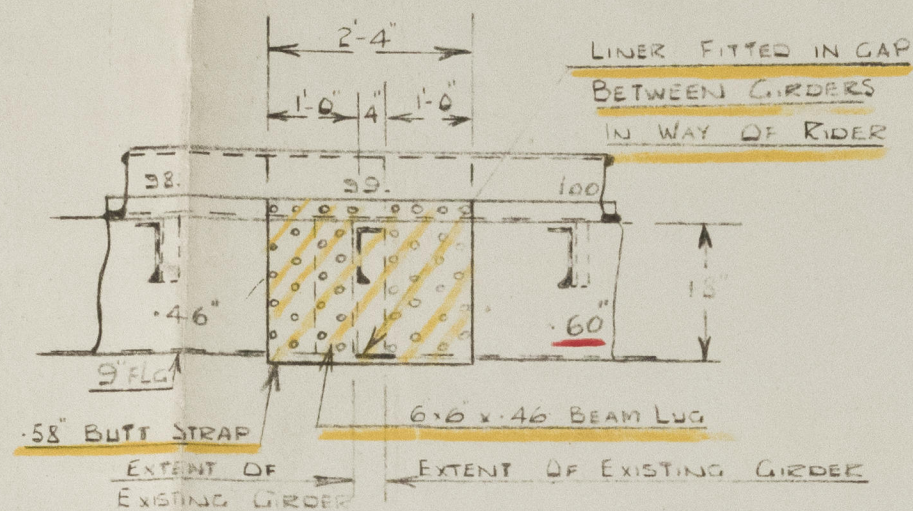



~~S.S. NADIR.~~
S.S. "SHAHJEHAN."
~~S.S. SHAHZADA~~

SCALE :- $\frac{1}{4}" = 1' - 0$




NEW WORK UNDERLINED IN YELLOW.

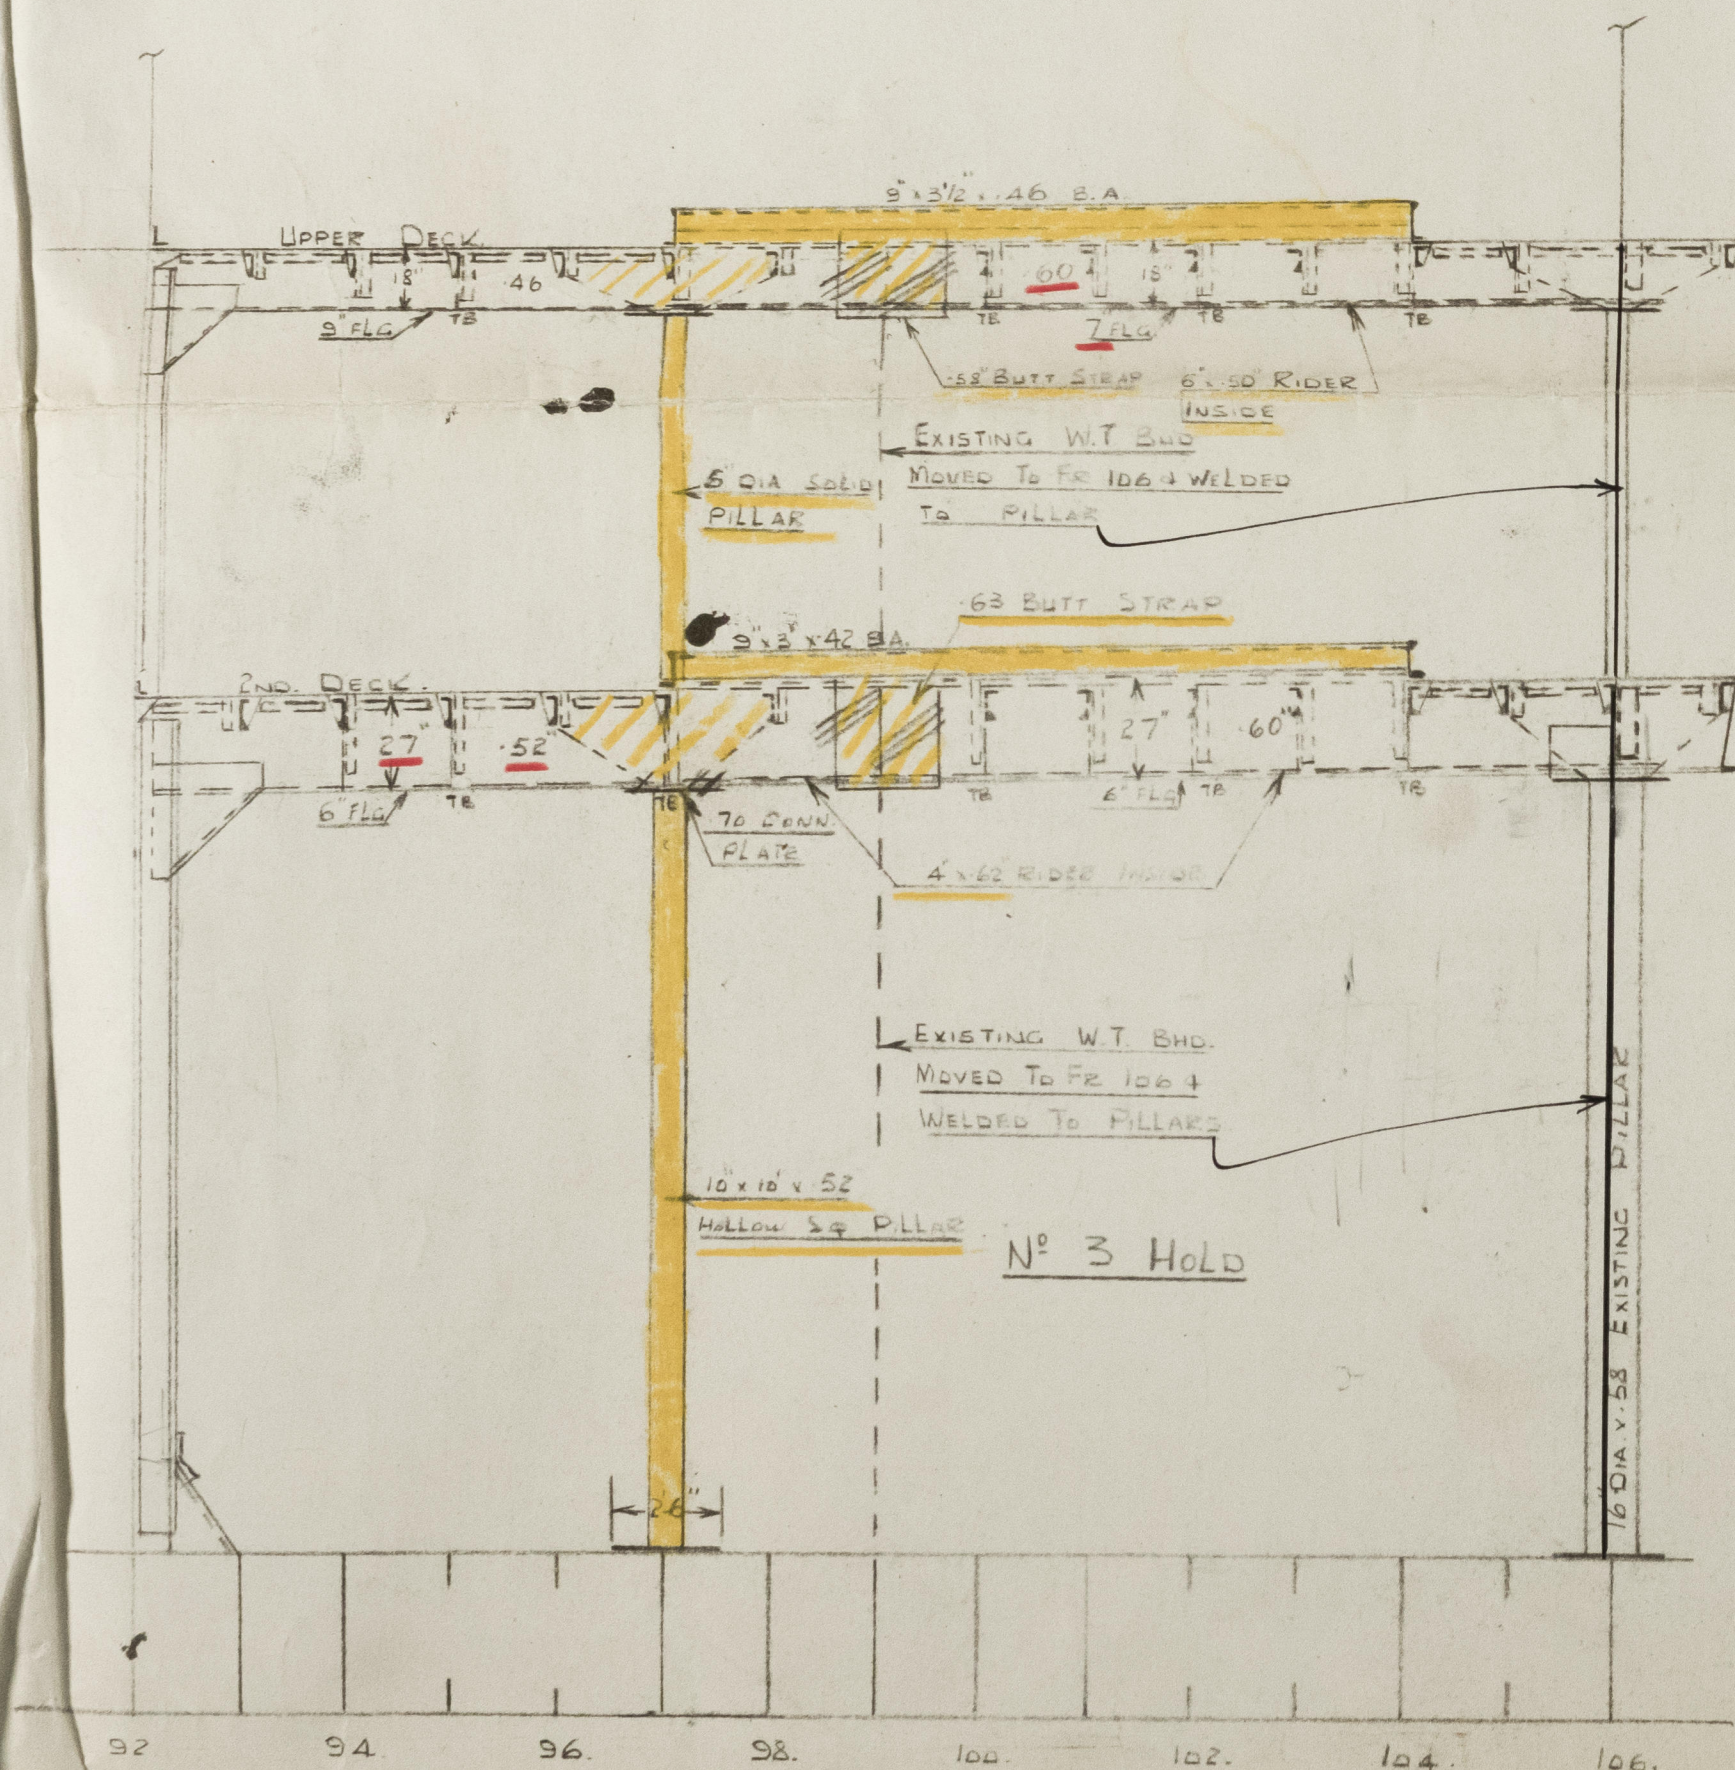

DETAIL OF BUTTTRAP ON
UPPER DECK GIRDER

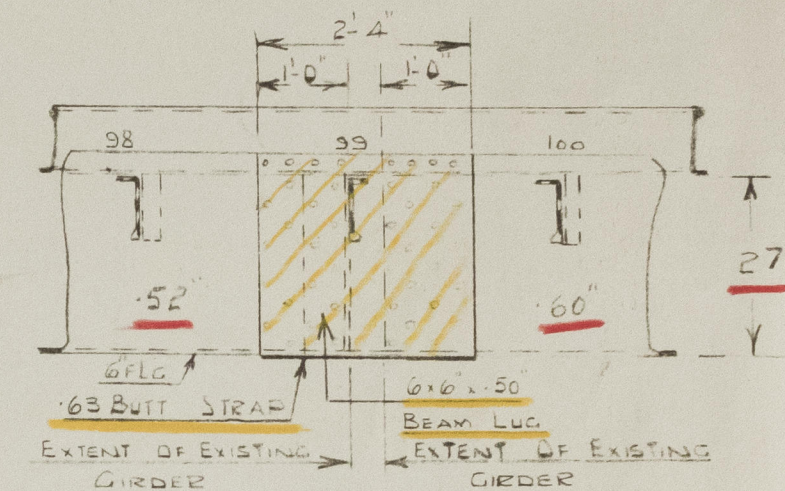

DETAIL OF BUTTSTRAP ON
SECOND DECK GIRDER

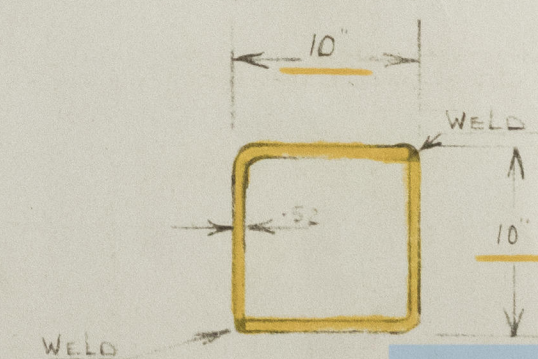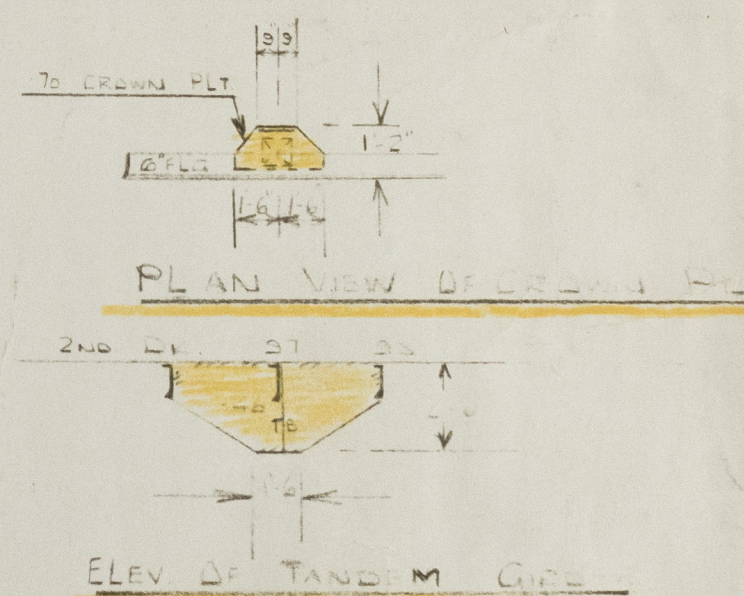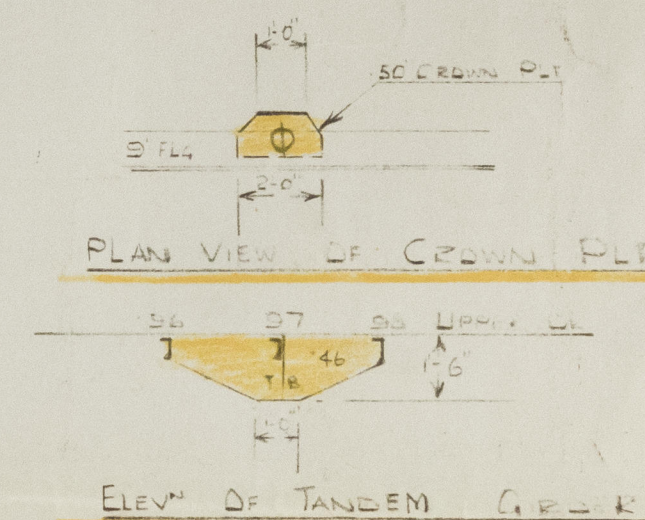

SECTION TWO: 10th SQ. PILLAR

copy of L.R. APPROVED plan.

003964-003970-0028

© 2021
THIS 10" x 10" PLEAE
COPY OF L.R. APPROVED PLAN
Lloyd's Register
Foundation