
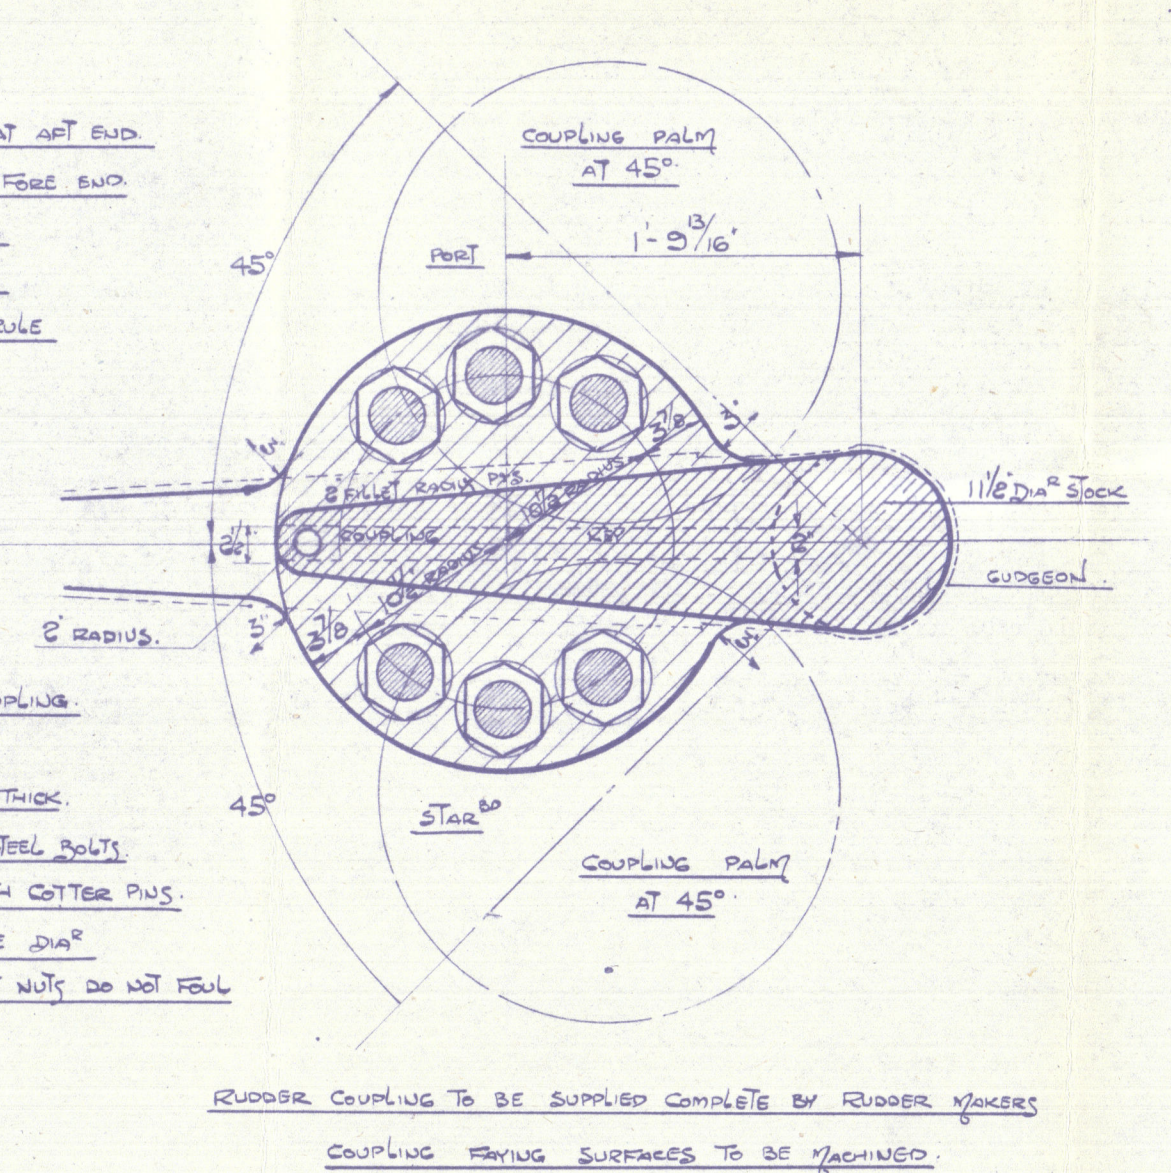



SCALE 1" = ONE FOOT
DETAILS AS INDICATED

[illegible]


RUDDER COUPLING TO BE SUPPLIED COMPLETE BY RUDDER MAKERS
COUPLING MATING SURFACES TO BE MACHINED.

APPROVED
LLOYD'S REGISTER OF SHIPPING
James H. Clark

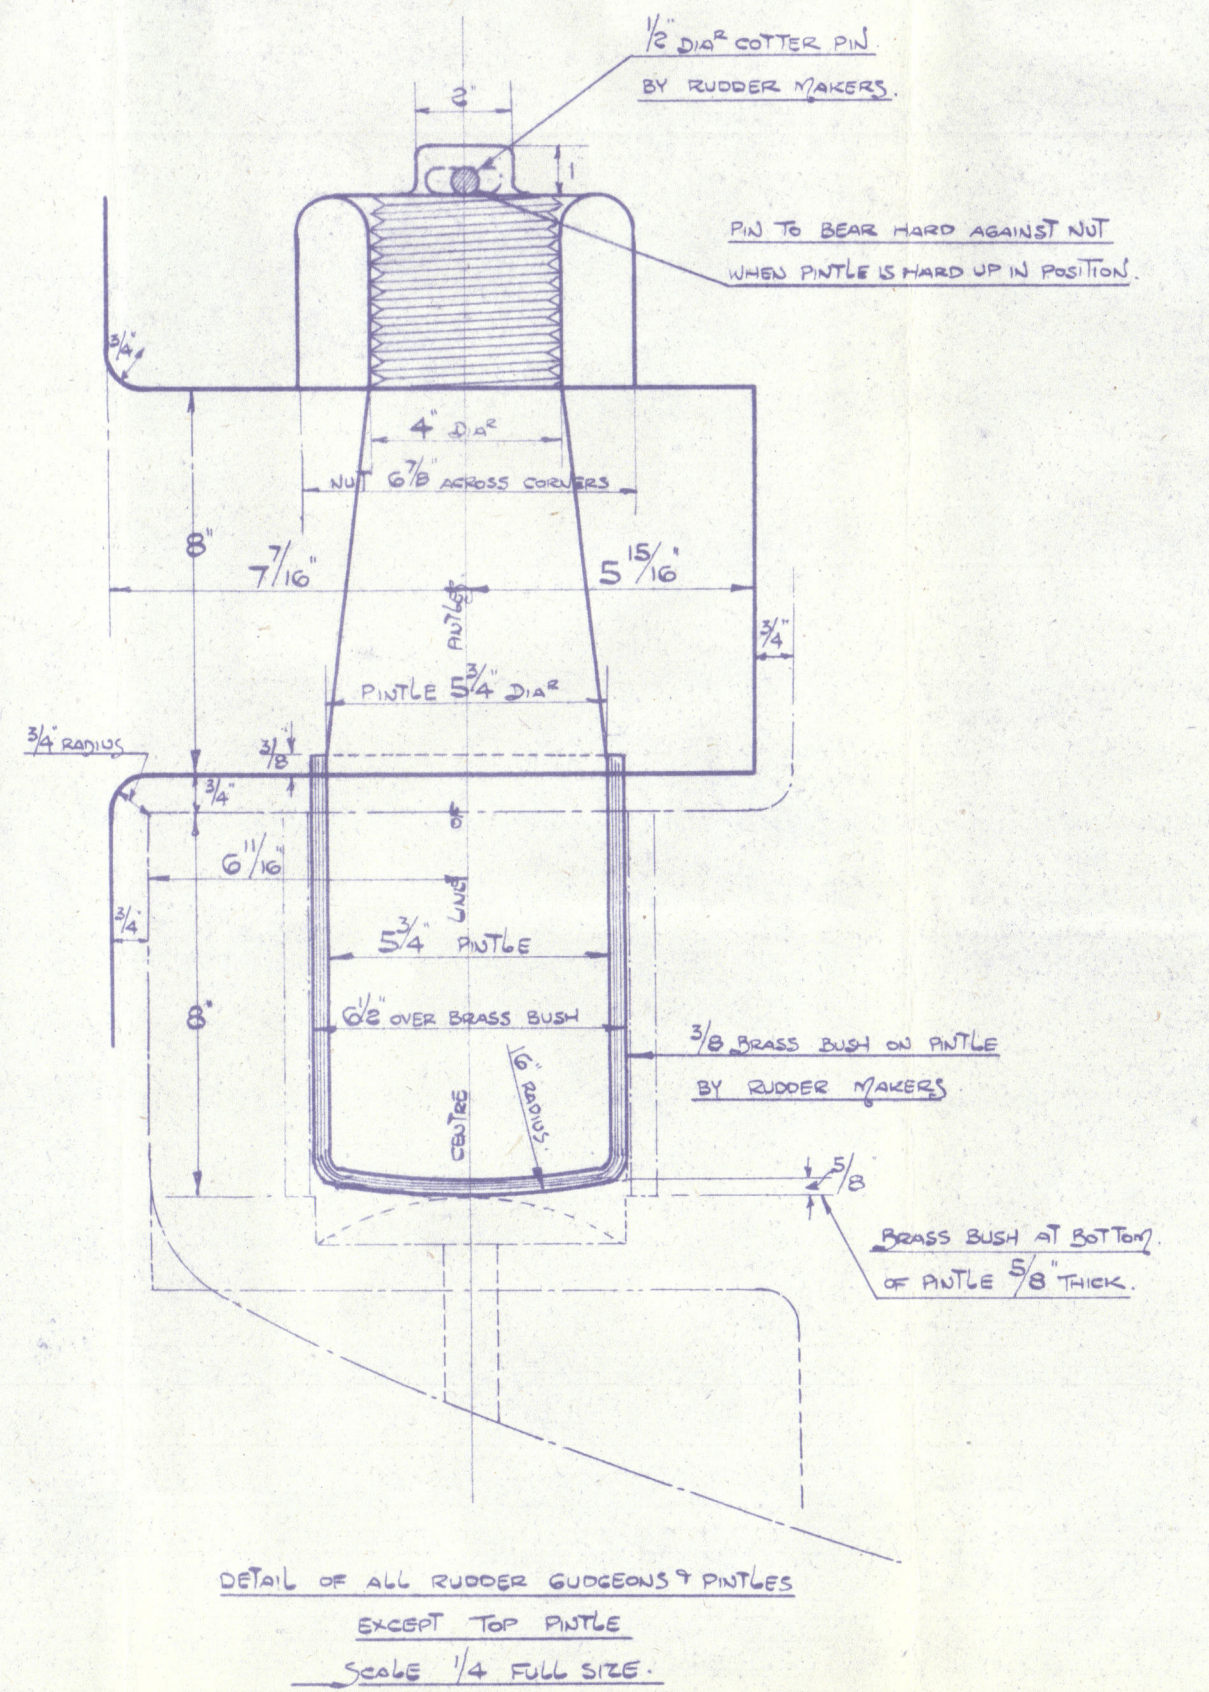

Lloyd's Register
Foundation

003964-003970-0029

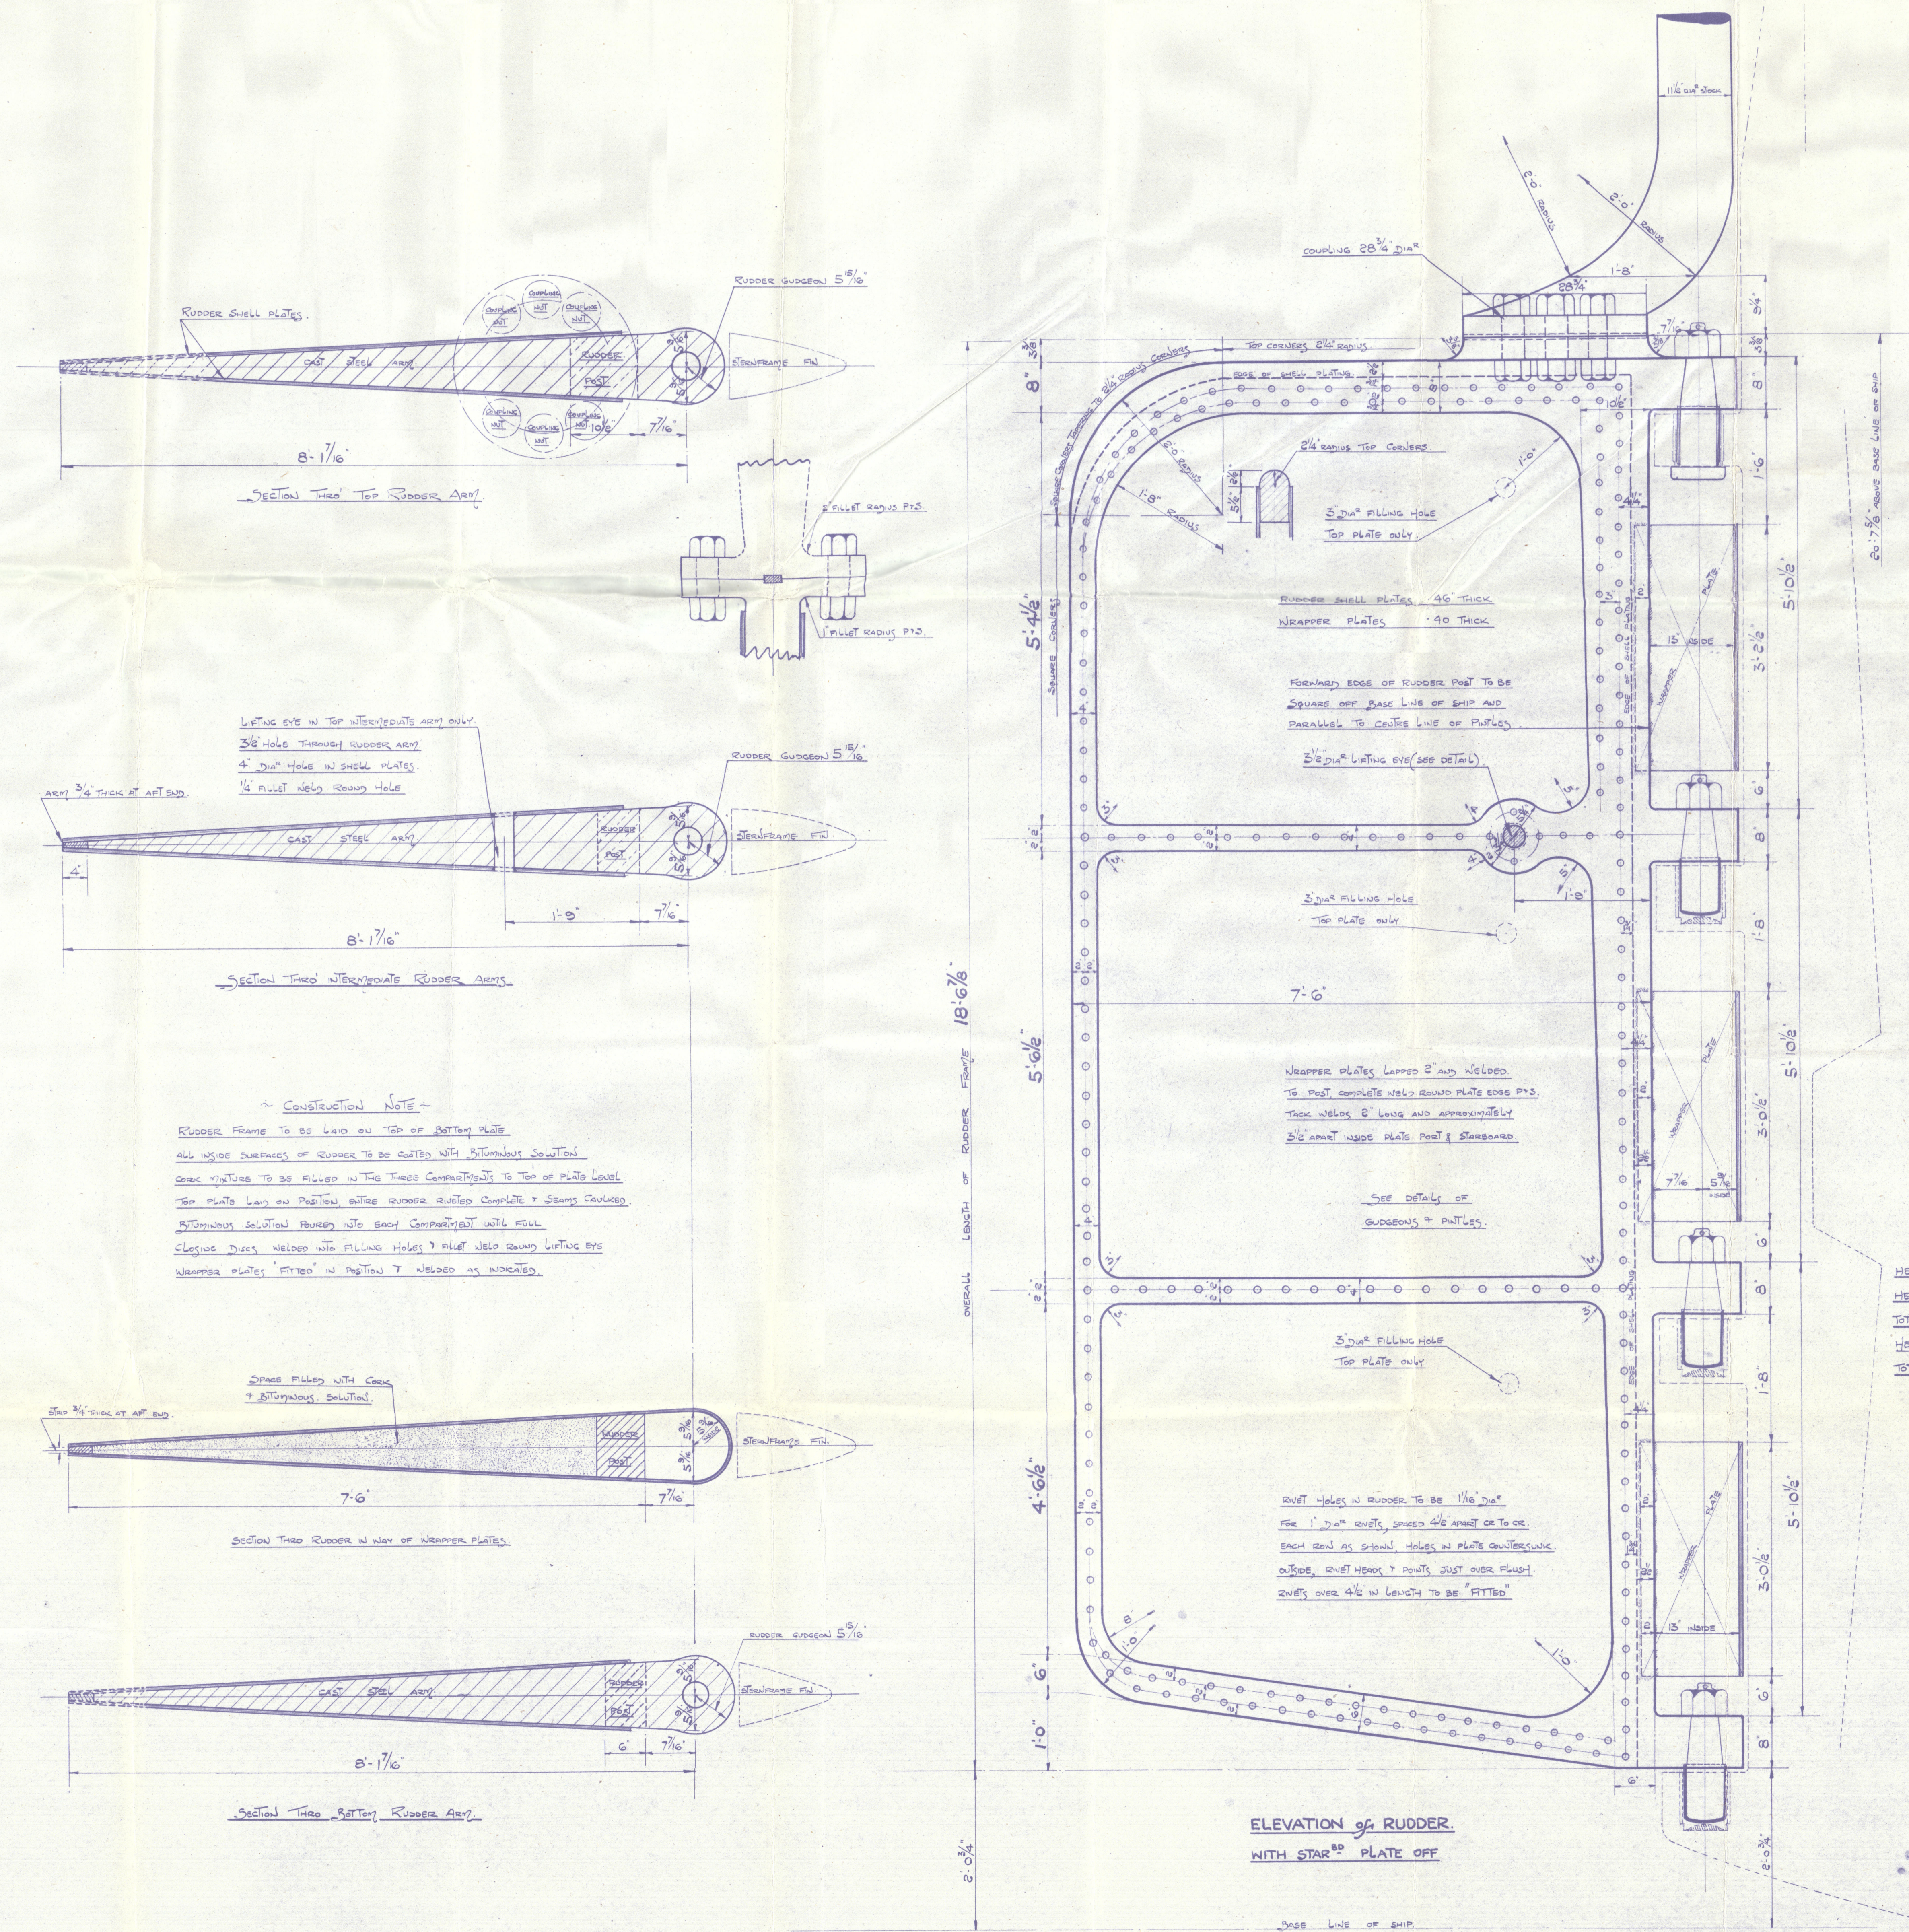

LITHGOWS 1012-13

(2)

RUDDER PLAN


not fitted see
rudder plan 1004

will verbal comply

"SHAHJEHAN"



3

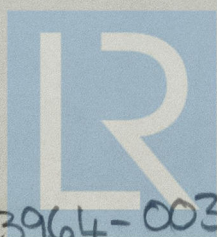

© 2021

Lloyd's Register

003964-003970-0029 Foundation