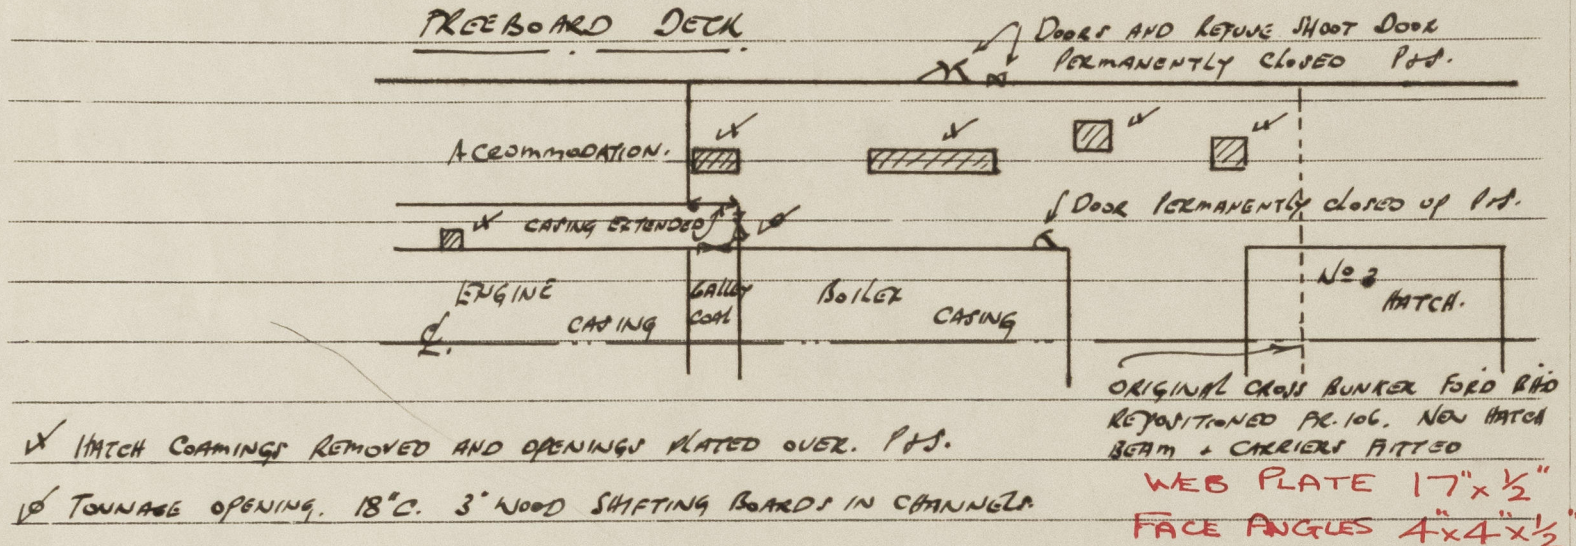
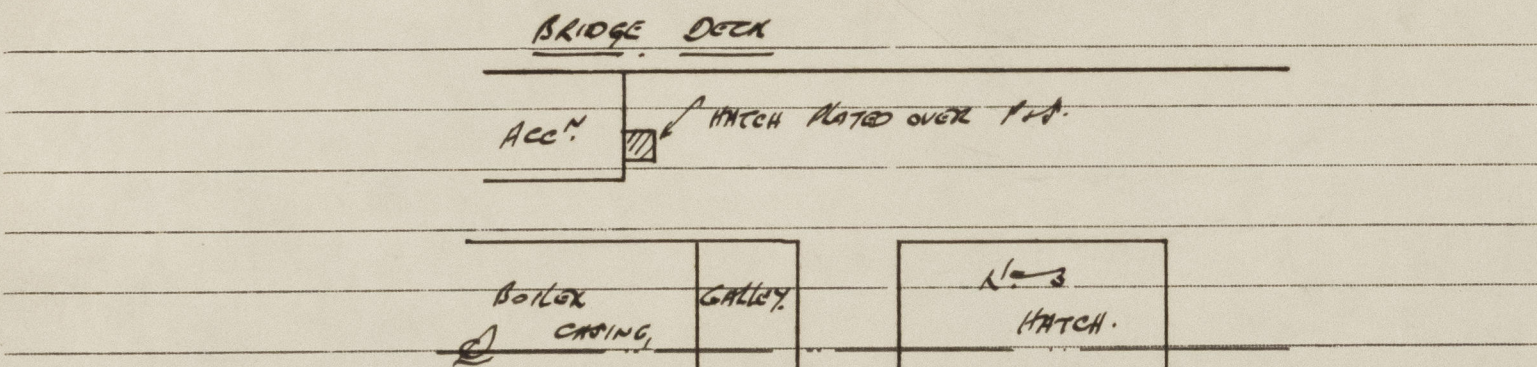


T= JAN 1954

LLOYD'S REGISTER OF SHIPPING

UNITED WITH THE BRITISH CORPORATION REGISTER

NAN AN
ALTERATIONS TO CONDITIONS OF ASSIGNMENT OF LOADLINESShip's Name EX "SHAHJEHAN"Official No. 180970 3704 KJPort of Registry LONDON. PanamaThis ship has been under survey at GREENOCK.on NW. 1 Dec. 1953. and the following alterations to the conditions of assignment of loadlines have now been effected/found:—FREEBOARD DECKBRIDGE DECK

ASH SHOOT REMOVED AND SHELL OPENING PLATED OVER.

AIR PIPES TO DOUBLE BOTTOM TANKS NOW FITTED FOR OIL FUEL HAVE WIRE GAUZE
DIAPHRAGMS WITH CANVAS COVERS.*W. S. Jones**S*

F 5 JAN 1954

© 2021

A copy of this Report has been placed on board.