
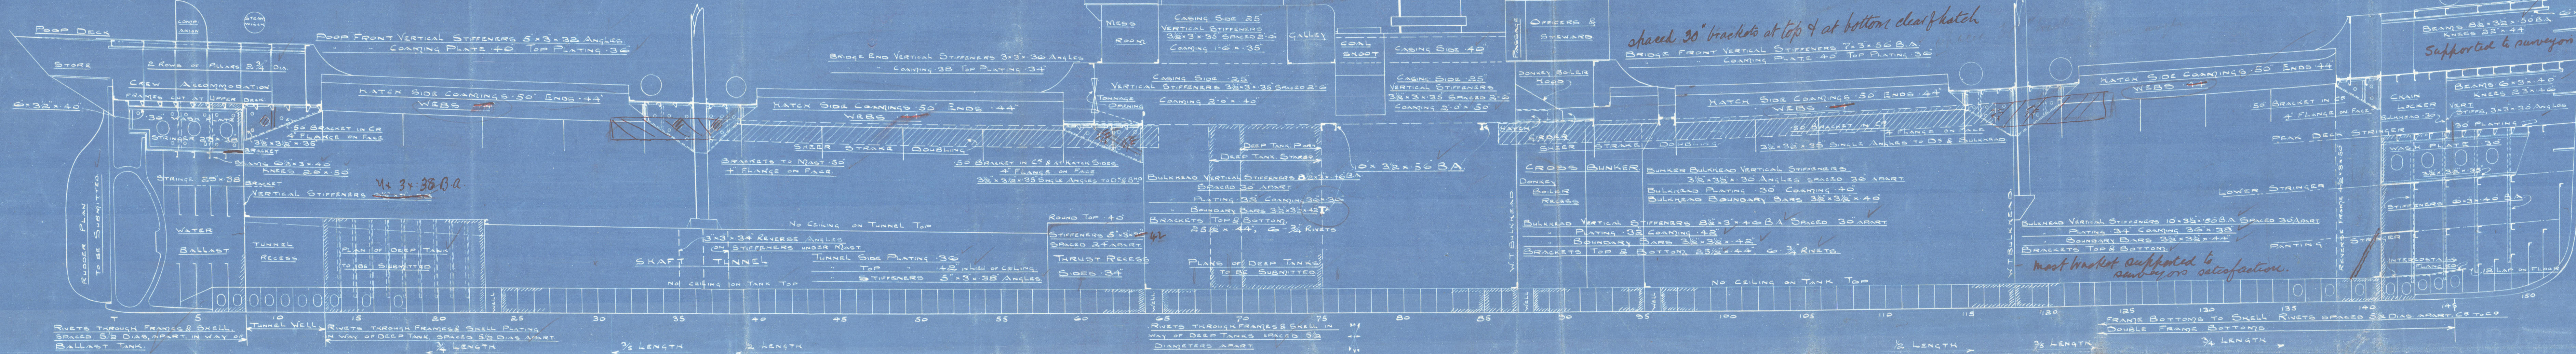


Nº 293 PROFILE AND DECKS


FREEDBOARD PARTICULARS

LENGTH BP	308.0	FORECASTLE	23.0 x 7.6
ON LOA LINE	307.3	BRIDGE	64.0 x 7.6
BREADTH EXTREME	43.0	POOP	25.0 x 7.6
WHEEL	23.10		
DEPTH OF MOLO	13.8		
UNDER DECK TONNAGE	2050		
SHEER AT STEW	7.6		
STERNPOST	3.3		
SHEER FROM STEW	1.1		
STERNPOST	0.0		


SCALE 1/8" = 1 FOOT

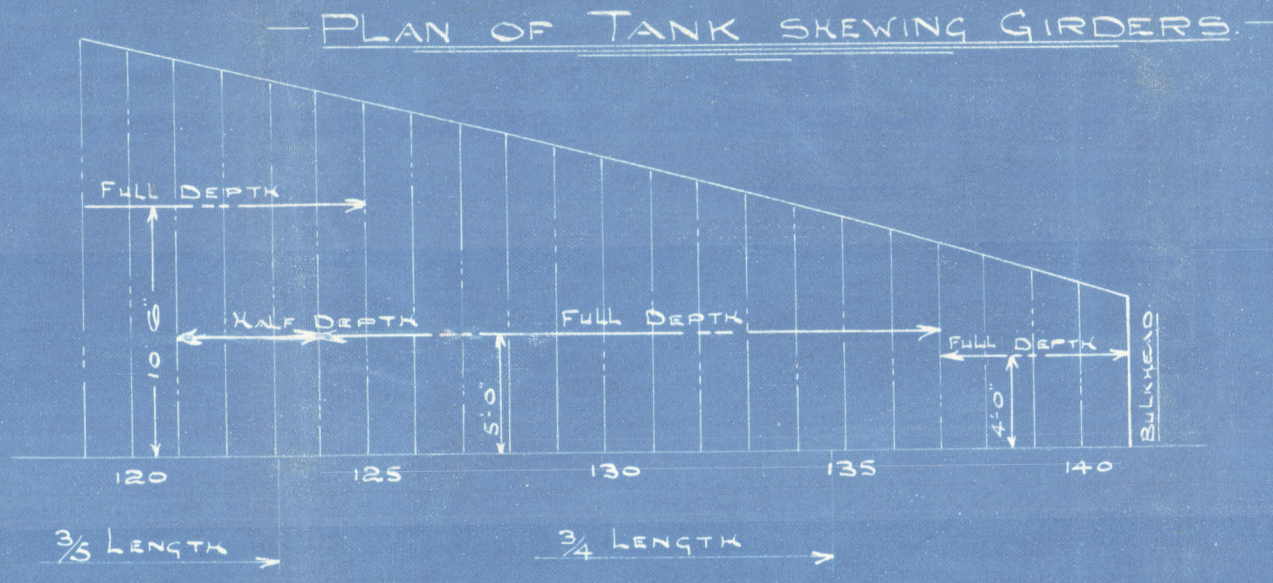

RAISED WINCH DECK

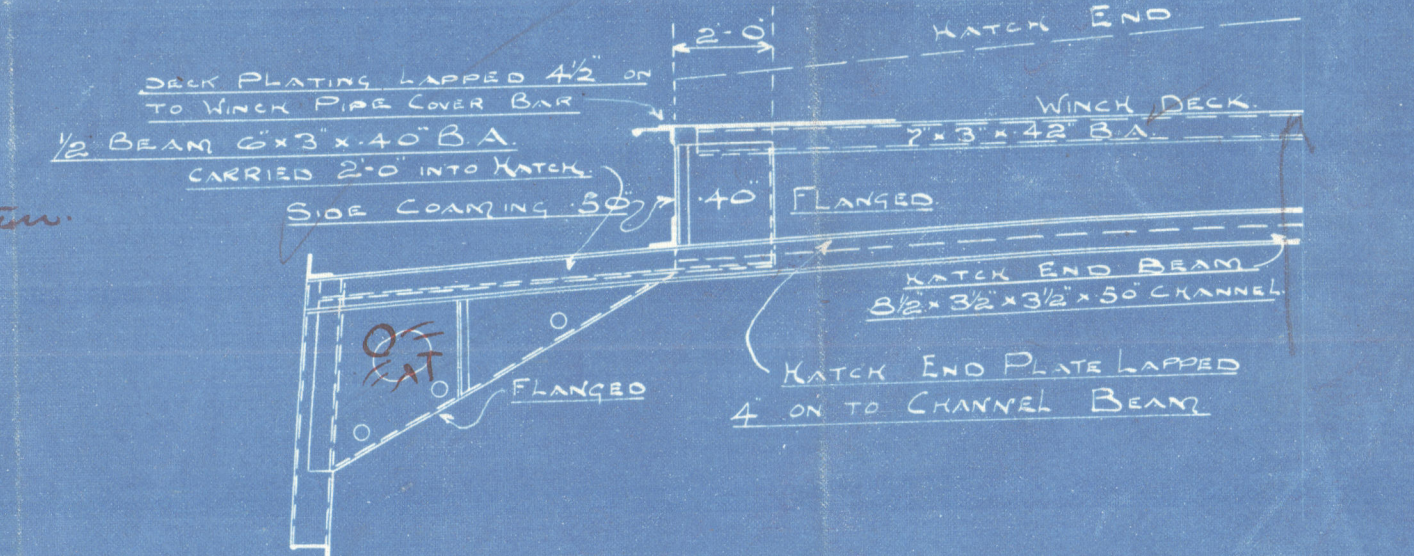


WINCH DECK AT SIDE

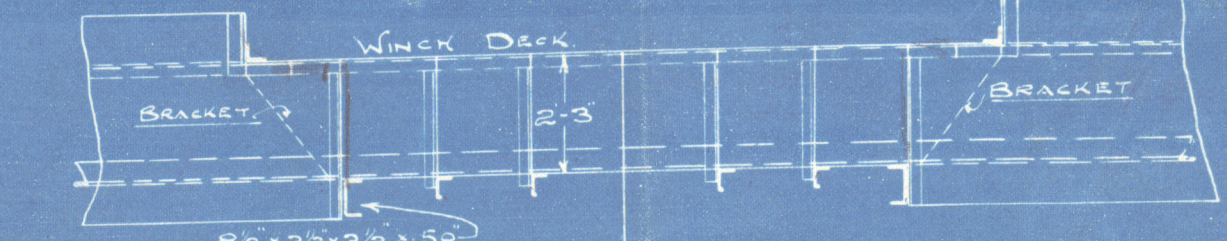


WT BULKHEAD ON 8 FRAME

LOOKING AFT
VERTICAL STIFFENERS ON AFTER SIDE

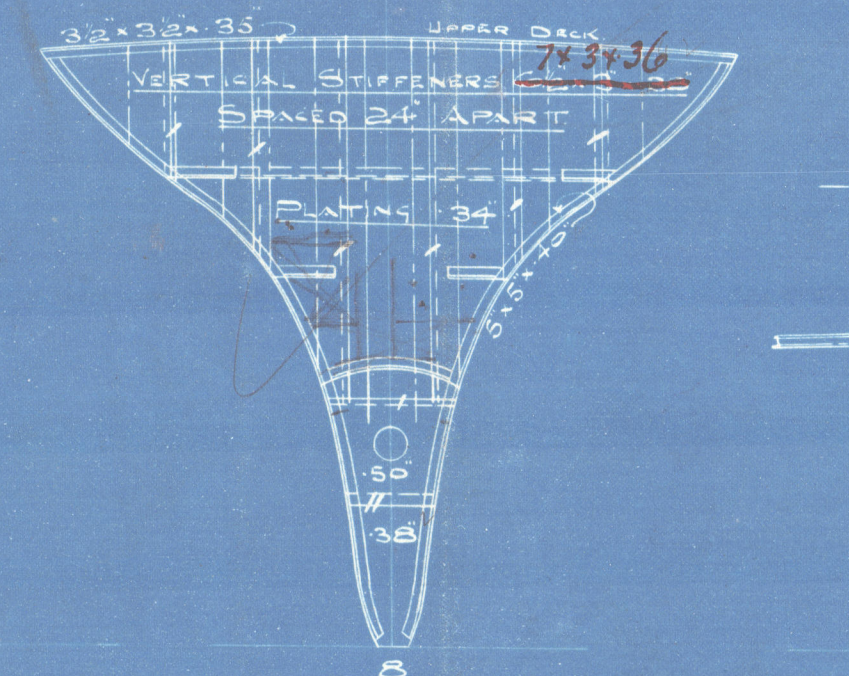


BRIDGE DECK

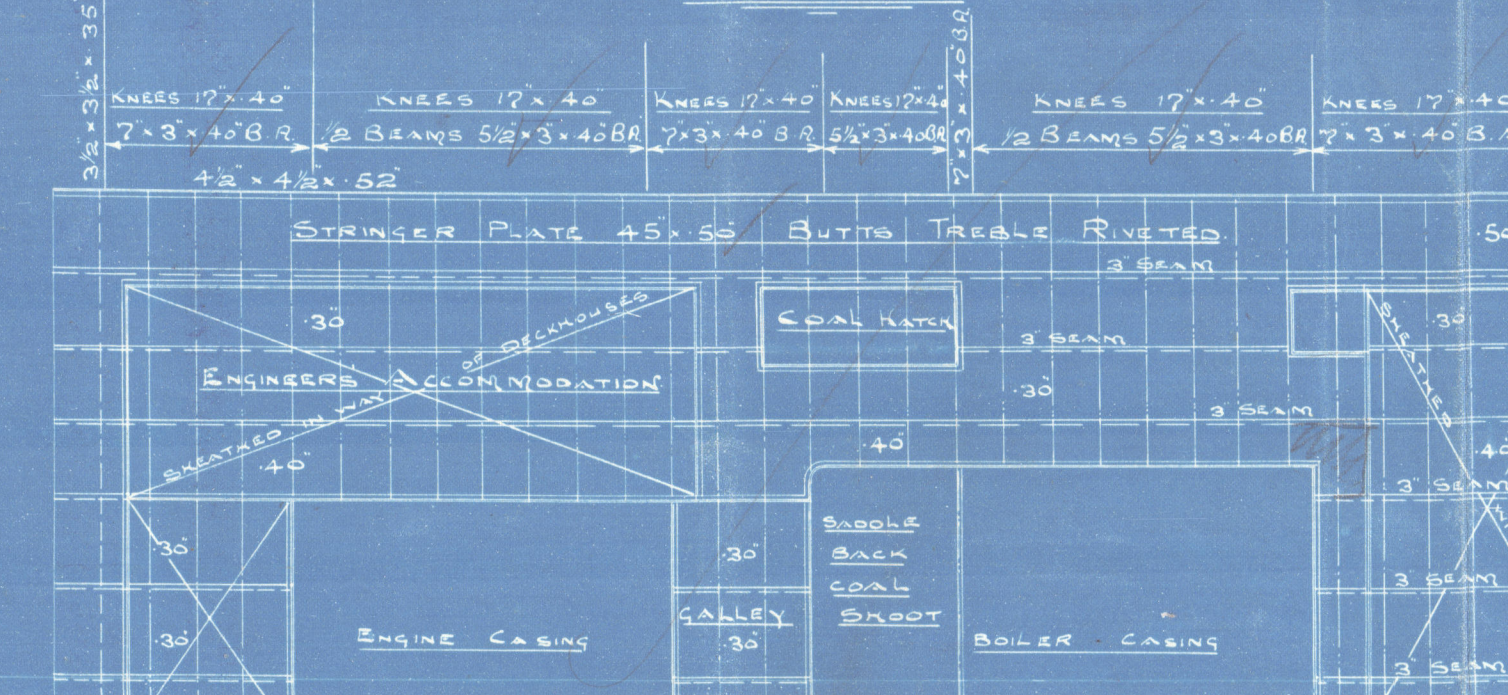


WT BULKHEAD ON 141 FRAME

LOOKING FORWARD
VERTICAL STIFFENERS ON FORE SIDE

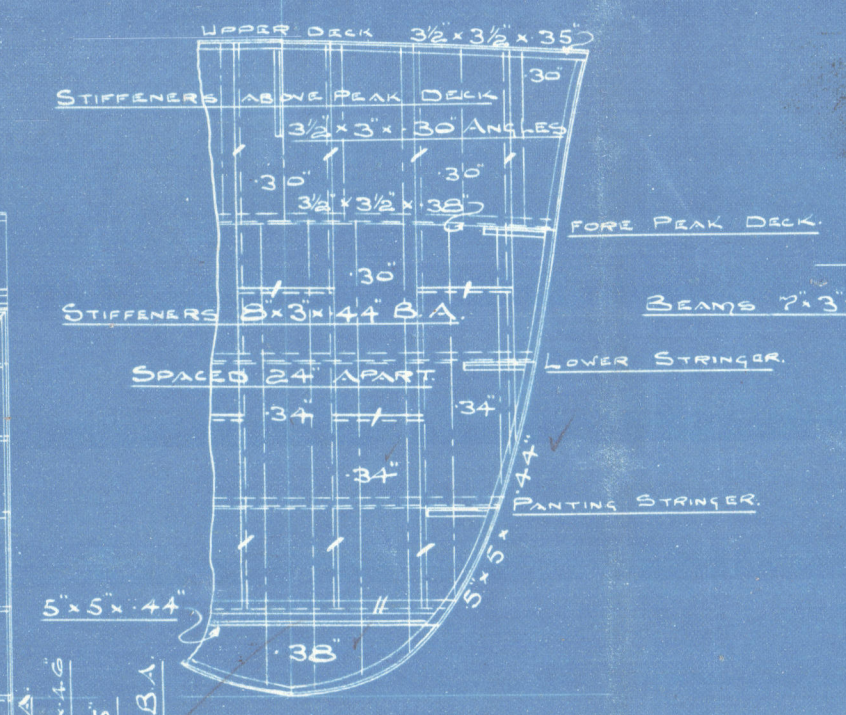


FORECASTLE DECK

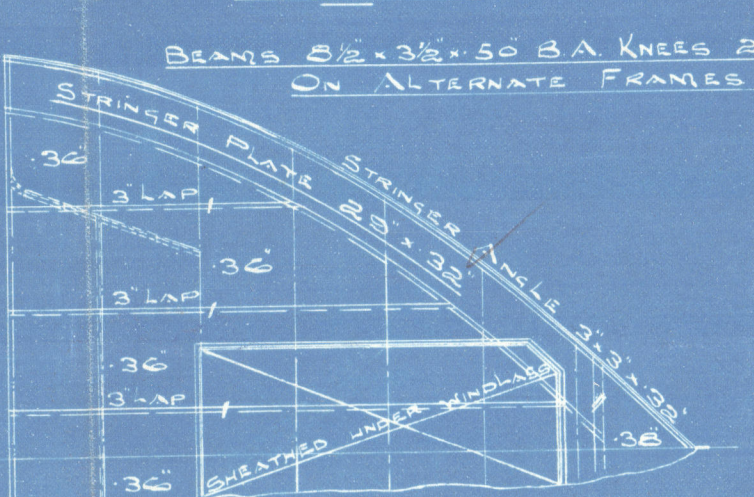


Deep flanged bracket or
Roo frame on 139 & 140


PEAK DECK STRINGER

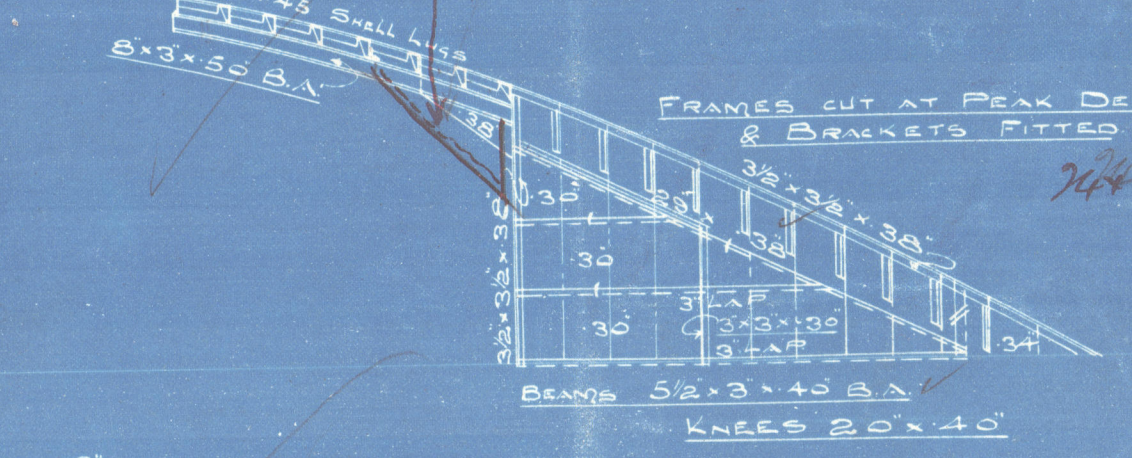


LOWER STRINGER

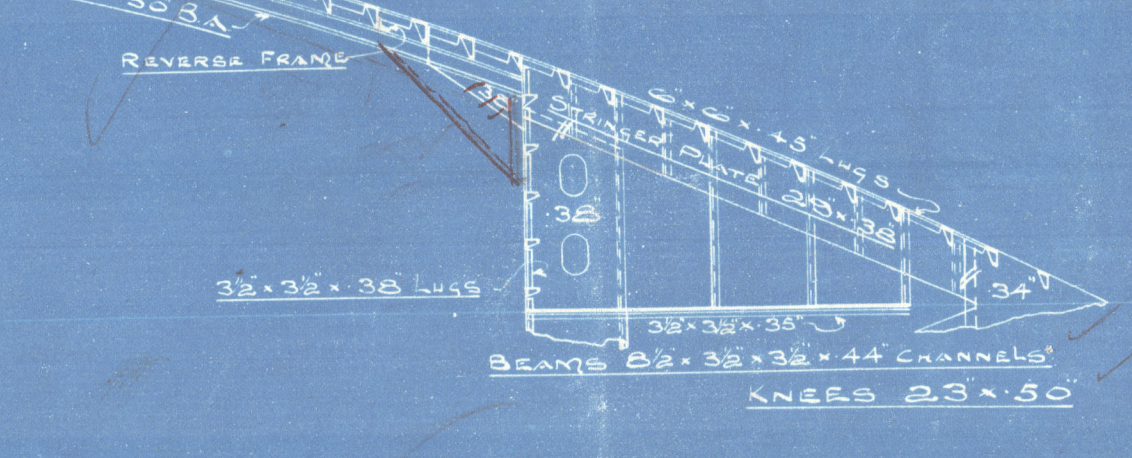


PANTING STRINGER

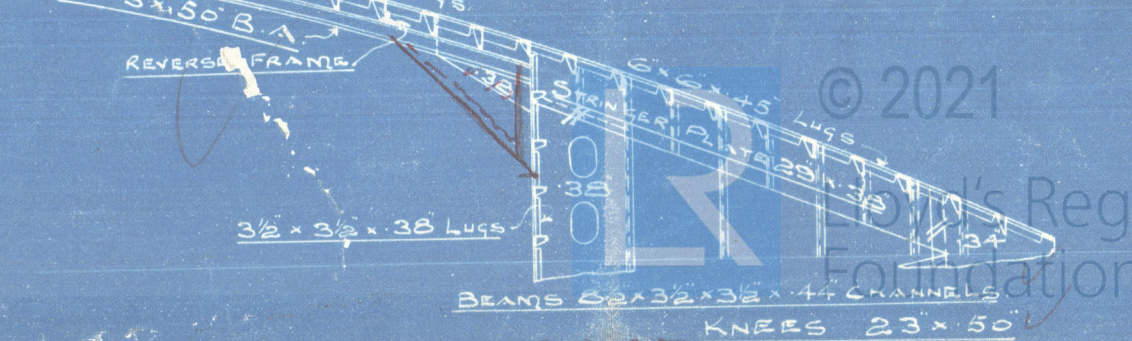


POOP DECK

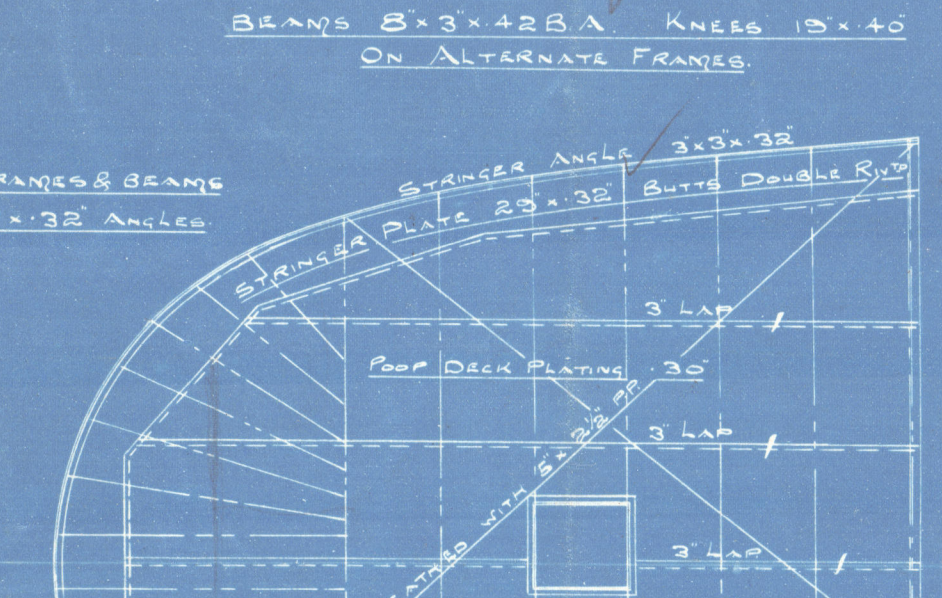

RAISED WINCH SEAT

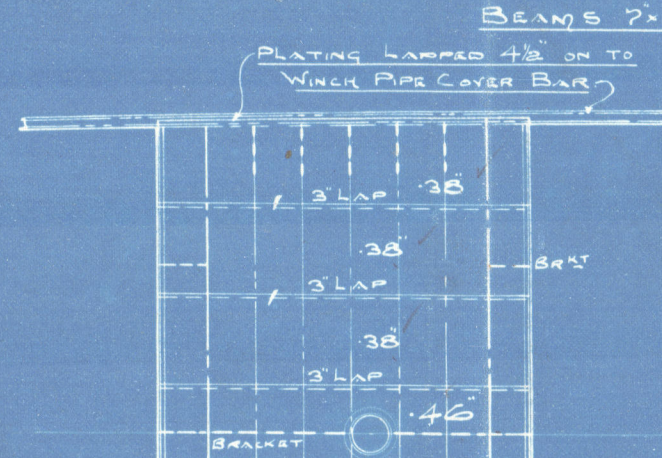

RAISED WINCH SEAT

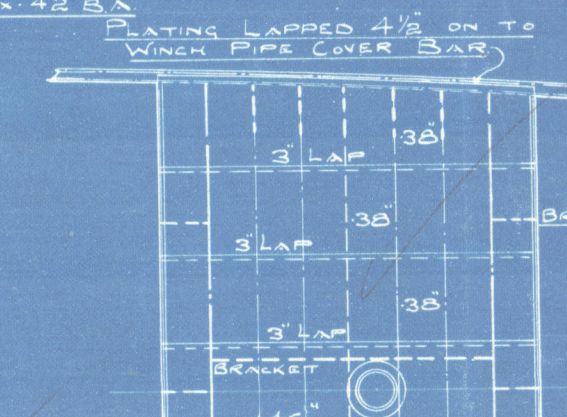

Frames & Poop
5'3" x 32' every frame
w equ.

But frame 5'3" x 32' accepted or main
frame carried up

27.11.19

© 2021

Register
Foundation

003964-003970-0065

S.F. Austin & Son.

—N^o 293.—

Profile & Decks.

s.s. "Zelo." *

Sld Rpt No. 28184

Gen Box 3023.


N/N

ZELO *

KYRIAKOULA

003964-003970-0065

© 2021

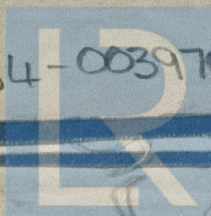

Lloyd's Register
Foundation