


Section in way of  
scarps assumed  
rectangular   
width at least  $7\frac{1}{2}$

 ~~$7\frac{1}{4} \times 10\frac{1}{4}$~~   
 $9 \times 11\frac{1}{2}$ 

2 Rows 1 1/4 DIA. HOLES FOR DIA RIVE  
5" APART C TO G.

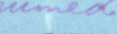

Mr James Laing & Sons Ltd  
Yard No. 776.


Mastframe & Rudder.

"Matadian" ★

UNDERLAND RPT. NO. 34864.

RECORDS DEPT.  
LONDON

4.

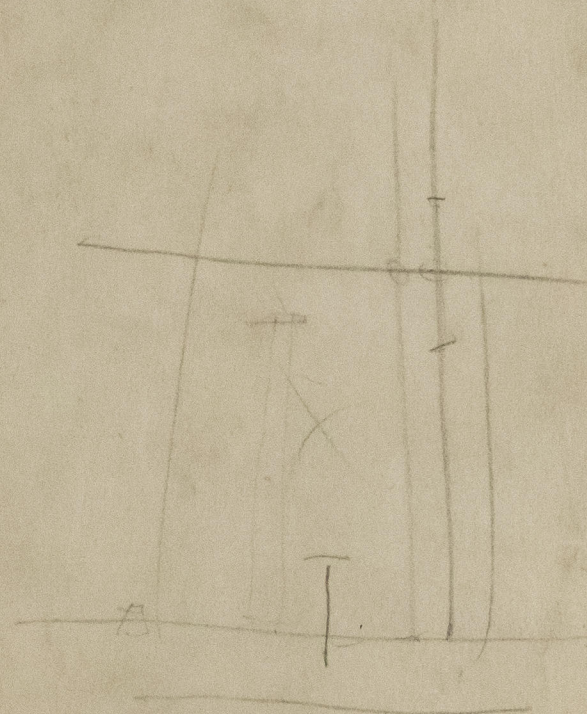

003964-003970-0184



© 2021

Lloyd's Register  
Foundation