

MIDSHIP SECTION.

DIMENSIONS:-460'-0" B.P. x 59'-0" BREADTH. MLD x 34'-0" DEPTH. MLD.

SCALE: 1/2" = ONE FOOT.

25 JUL 1940

TO CLASS LLOYDS 100A1.
'CARRYING PETROLEUM' IN BULK:
LONGITUDINAL FRAMING AT BOTTOM & AT DECK
ALL BULB ANGLES ARE TO NEW BRITISH STANDARD
SCANTLINGS SHOWN APPLY AMIDSHIPS AND ARE
TO BE INCREASED FOR SHEER AS REQUIRED.
SCANTLINGS, INCLUDING SHELL, CLEAR OF CARGO
OIL TANKS TO BE SPECIALLY CONSIDERED.



LLOYDS NUMERALS:

$L \times D$	$460'0'' \times 34'0''$	$= 15640$
$L \times (B+D)$	$460'0'' (59'0'' + 34'0'')$	$= 42780$
L/D	$460/34$	$= 13.52$


ALL ATTACHMENT ANGLES TO BULKHEADS TO BE HYDRAULICALLY
RIVETED ON THE GROUND PRIOR TO ERECTION.
NO PLATE SEAMS OR BUTTS TO BE ARRANGED IN WAY OF
THE CONNECTIONS OF THE TRANSVERSES & STRINGERS TO BULKHEADS

IN CONNECTIONS MARKED THIS "X" RIVET HOLES IN BOTH BARS & BULKHEAD
TO BE PUNCHED 1/8" SMALL AND CAREFULLY REAMERED OUT AFTER ASSEMBLY
CONNECTIONS TO BE DISMANTLED AND SURFACES CLEANED AND ALL
BURRS REMOVED ON RE-ASSEMBLY, BOLT TO BE FITTED IN EVERY 3RD
HOLE ALSO IN BOTH HOLES AT BOTH ENDS OF BARS AND ALL THOROUGHLY
HARDENED UP.


DETAIL OF CENTRE GIRDER TRIPPING BRACKETS

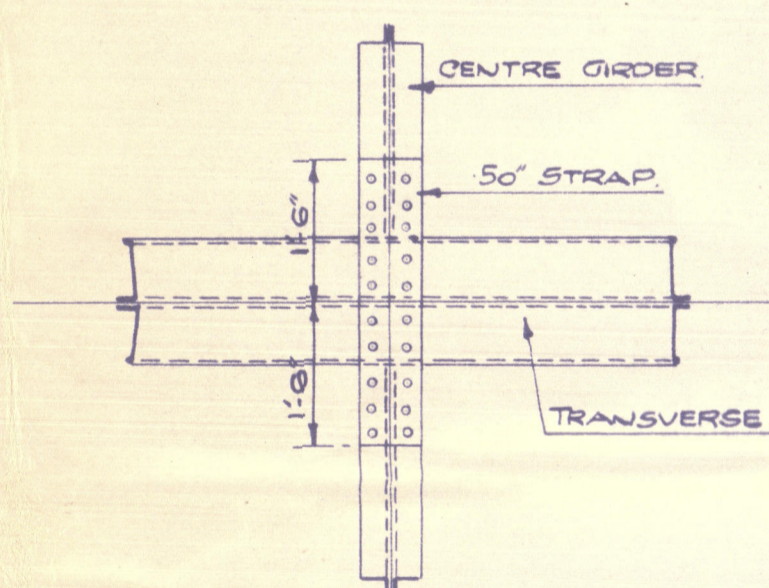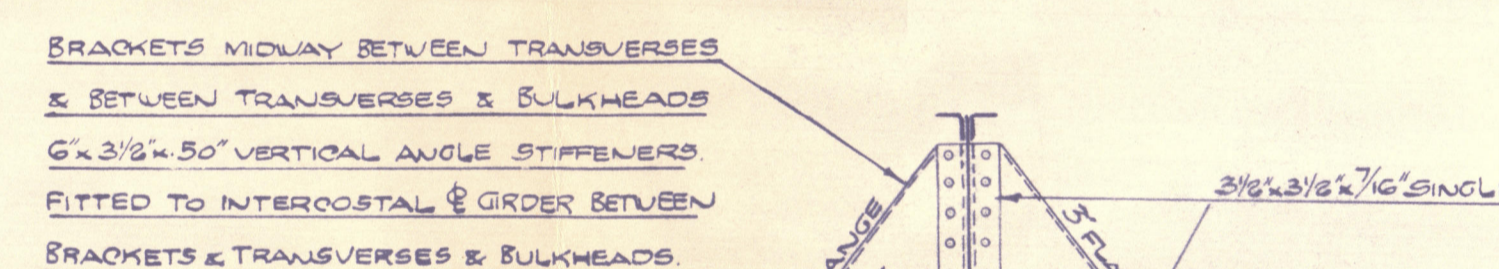

SECTION THRO' WING TANKS AT INTERMEDIATE FRAME.

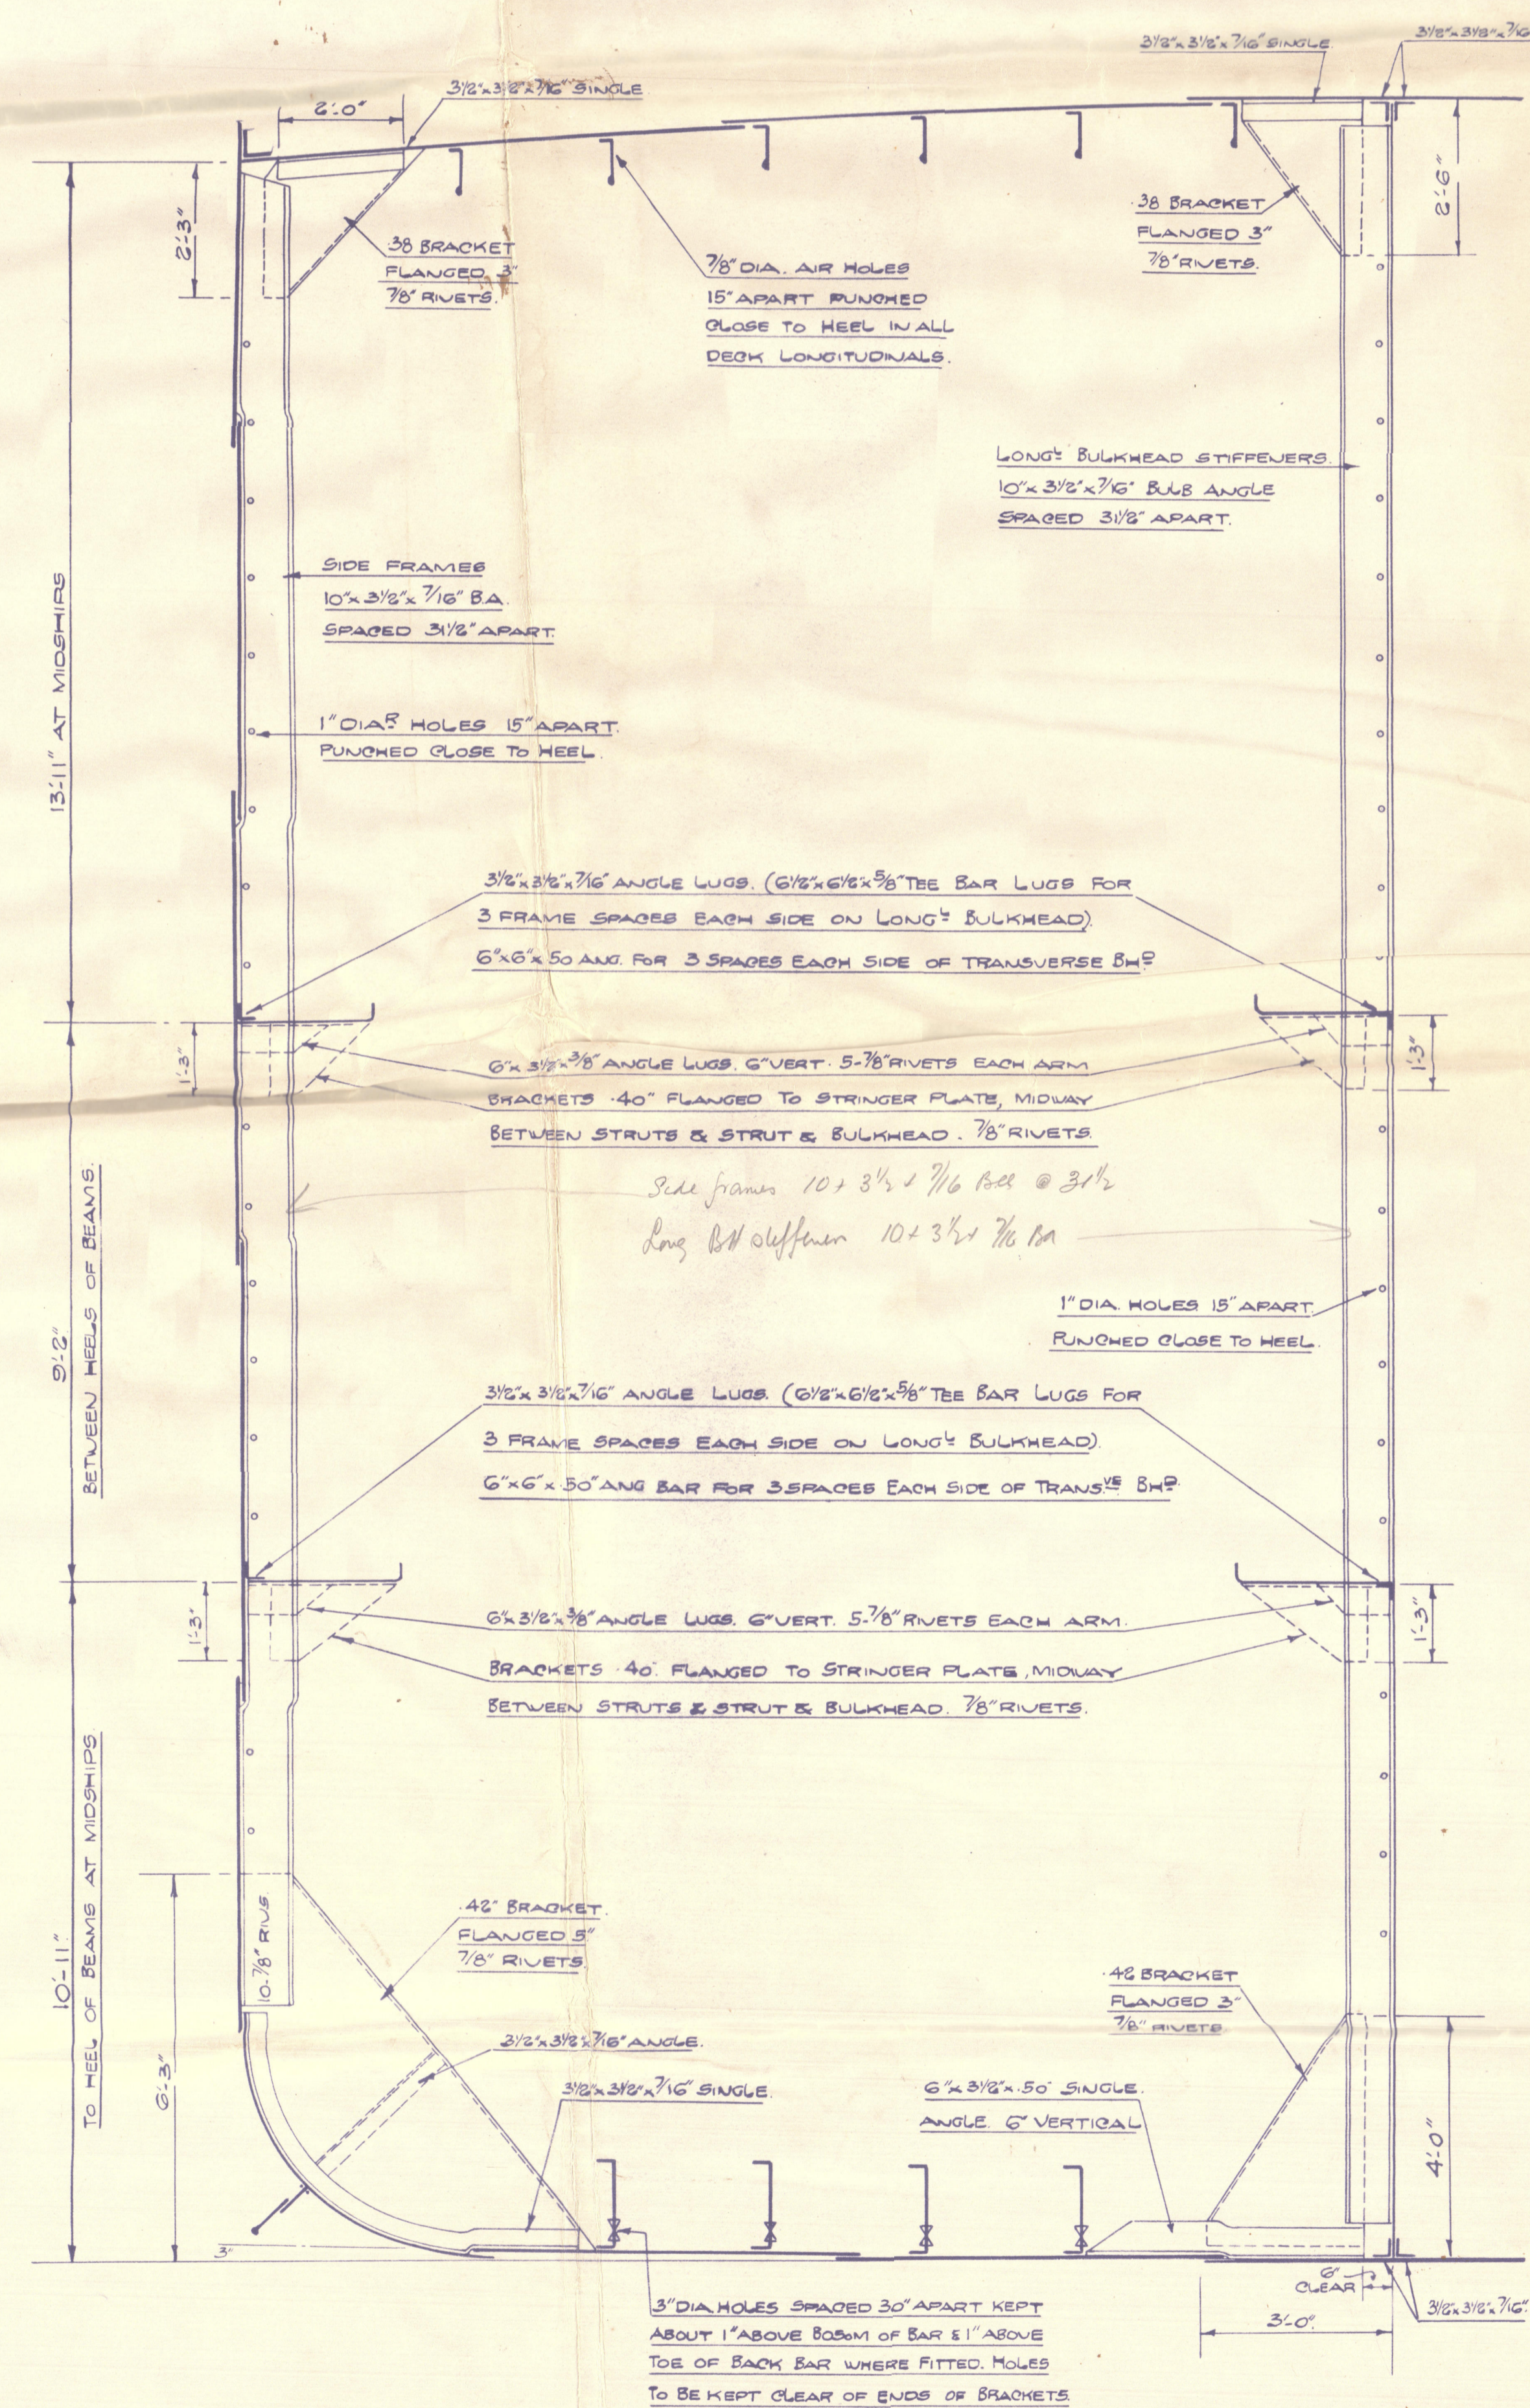

9 WING TANKS.
TRANSVERSES 10' 6" APART.

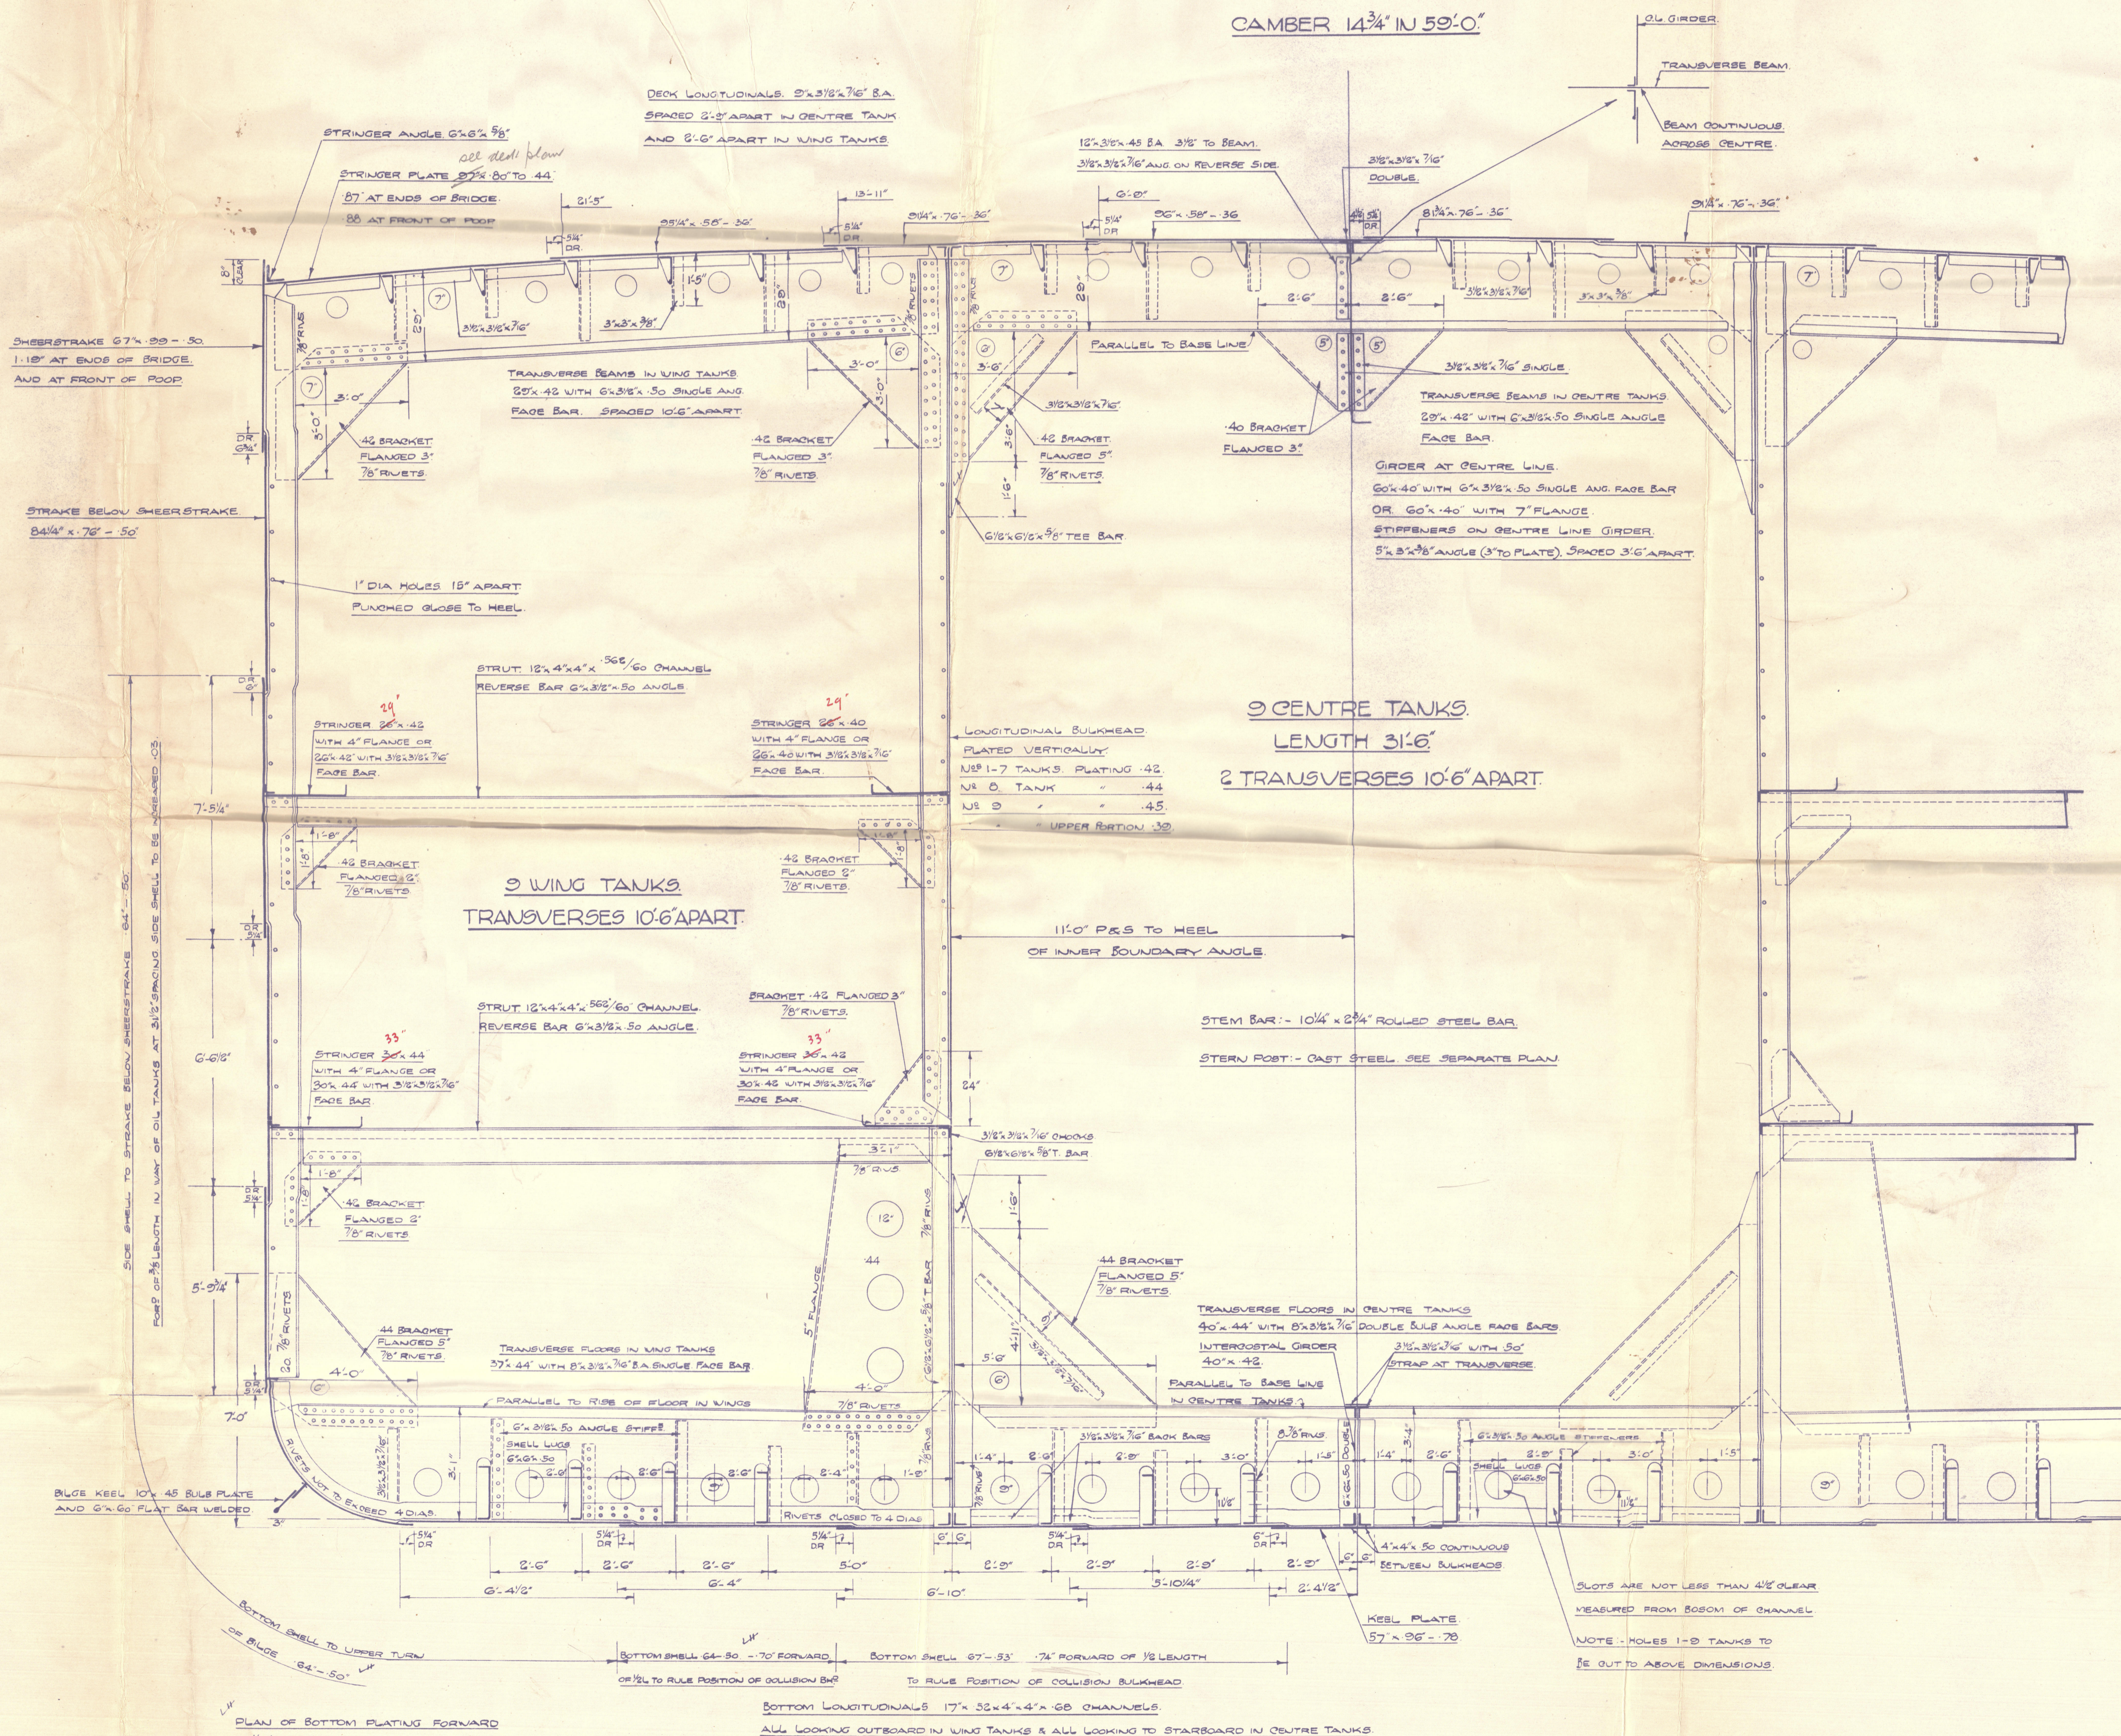

SECTION AT TRANSVERSES. LOOKING AFT.

RIVETING

BOTTOM SHELL BUTTS - QUADRUPLE OVERLAYS TO TREBLE AT ENDS
DO SHELL BUTTS - " " " " " "
SHELL LANDINGS - DOUBLE RIVETED POKE AND AFT
HEEL PLATE BUTTS - QUINTUPLE OVERLAYS TO QUADRUPLE AT ENDS
SWEEPSTROKE BUTTS - " FOR 1/2 LENGTH TO TREBLE
AT ENDS WHERE NOT EXCEEDING 60"
STRAKE BELOW SWEEPSTROKE BUTTS } QUADRUPLE OVERLAYS FOR 1/8 LENGTH TO TREBLE
AT ENDS WHERE NOT EXCEEDING 96" *Egyptian*
THICK PLATES AT BREAKS - DOUBLE STRAPPED, TREBLE RIVETED
UPPER OR STRINGER BUTTS - QUADRUPLE OVERLAYS FOR 1/8 LENGTH TO TREBLE
AT ENDS WHERE NOT EXCEEDING 60"
THICK UPPER OR STRINGER PLATES AT BREAKS - QUINTUPLE OVERLAYS
UPPER DECK BUTTS - QUADRUPLE OVERLAYS FOR 1/8 L WHERE ABOVE G.
" - TREBLE " " " " " " NOT EXCEEDED
" - NOT LESS THAN DOUBLE OVERLAYS IN WAY OF O.
" LANDINGS - DOUBLE TRIPLE IN WAY OF OL SINGLE RIVETED
OUTRIGT SUBHEDGE BUTTS AND LANDINGS - DOUBLE RIVETED.

RIVET SPACING.

[illegible]

2 BOWER ANCHORS. 73.16 GUTS EACH. STOCKLESS.

STREAM ANCHOR	22	OUT5 (EX STOCK)
---------------	----	-----------------

240 FATHOMS 2 7/8" STUP LINK CHAIN CABLE

TWO SPARE ANCHOR AND TWO CABLE SHACKLES

ONE BOX PINS AND PUNCHES AND ONE SHACKLE PUNCH

180 FATHOMS 5° (6/12) ORG WIRE STREAM.

130 " 5 1/4" (6/24) " " TOW LINE.

2 @ 100 FATHOMS	2 3/4" (5/16)	*	*	NAUSERS
-----------------	---------------	---	---	---------

2 @ 100	"	2 3/4" (5/12)	"	"	WARPS.
---------	---	---------------	---	---	--------

ALL WERE TO BE ON REELS ALL REEL TO TALK

61765 61766 61767 62

SIZES SUPPLIED. REELS FOR LARGE WIRTS TOO

W.J.
25.7.41
Loyola



①

HARLAND & WOLFF LTD.
BELFAST

No. 1090

TITLE Midskip Section


DATE APPROVED 25. 7. 40

San Veronica

Bel Rpt No 13411

RETAIN

003971-003979 © 2021

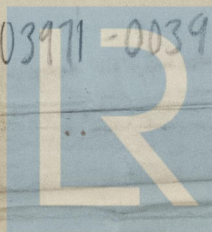

Lloyd's Register
Foundation