
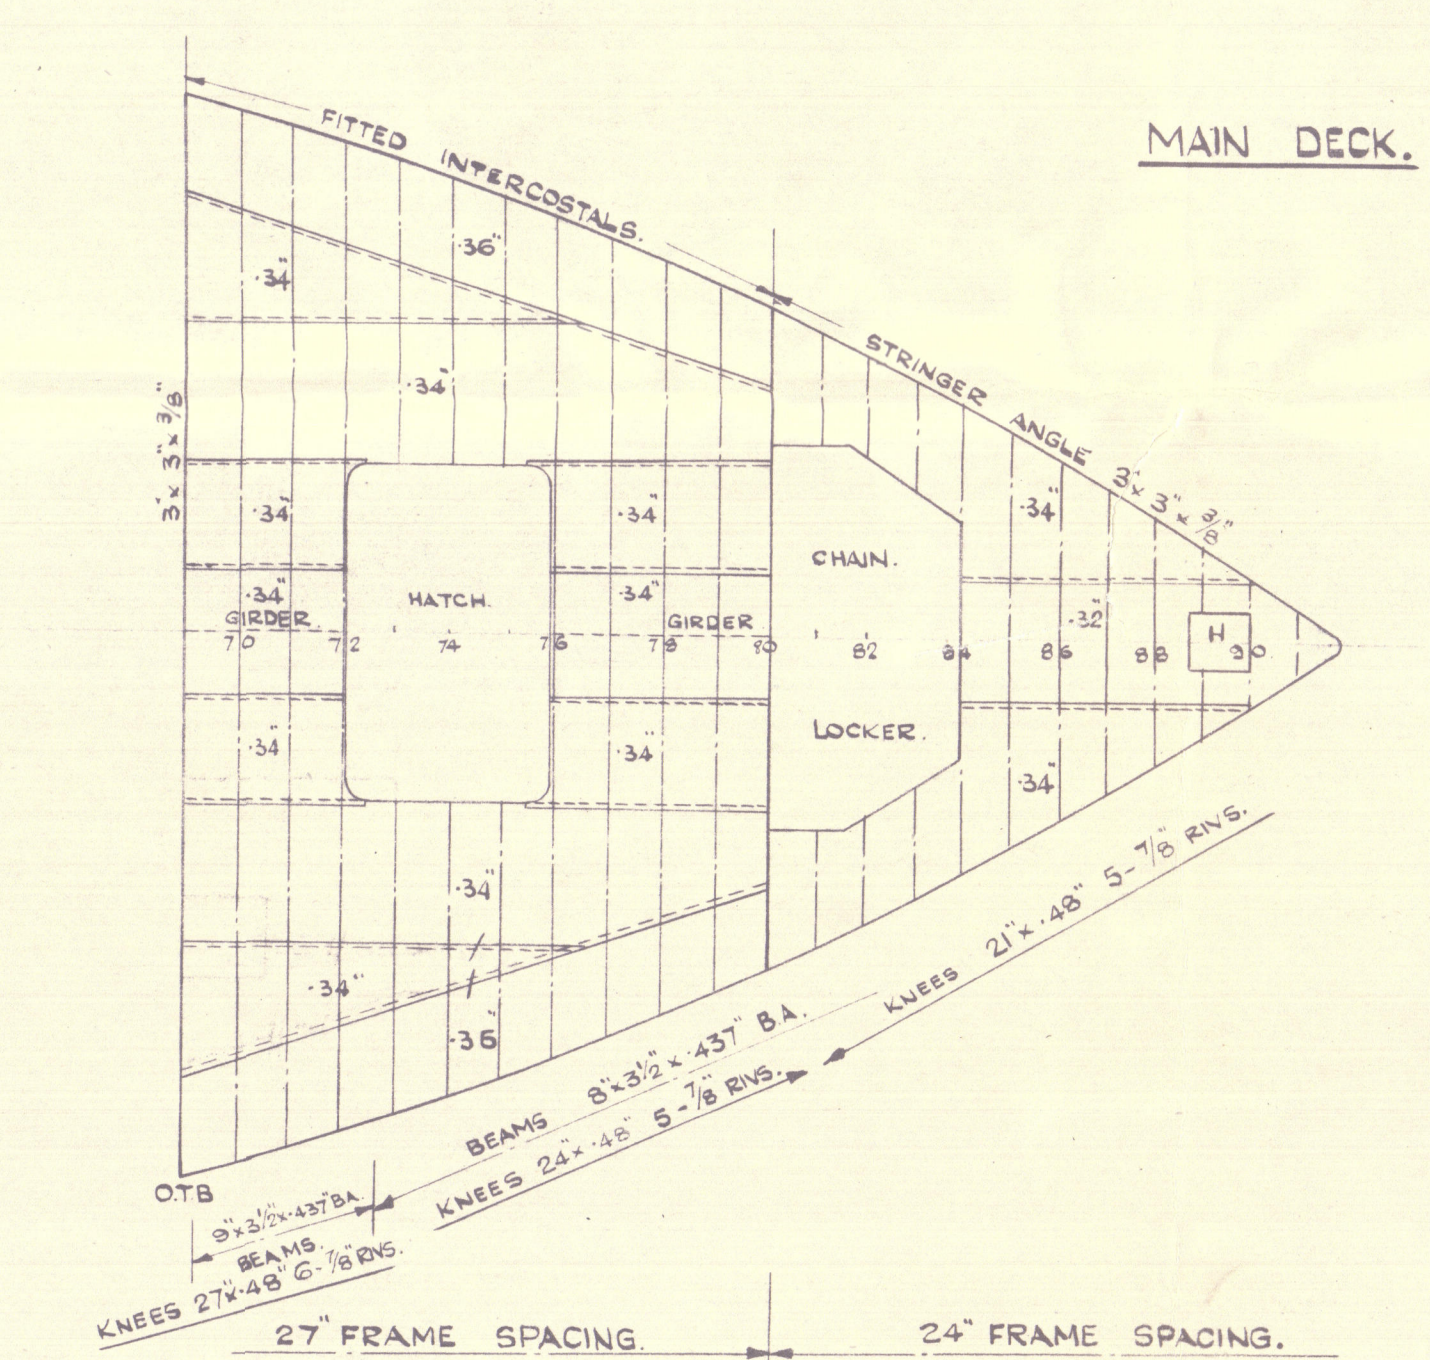
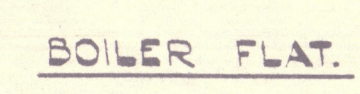


TO CLASS LLOYDS 100 A.1 "CARRYING PETROLEUM IN BULK"

$$\begin{array}{r} 49'-0 \\ 4'-6 \\ \hline 44'-6 \end{array}$$
 alcanto has 6' water join 48'-6"
 and has 6' water 44'-0

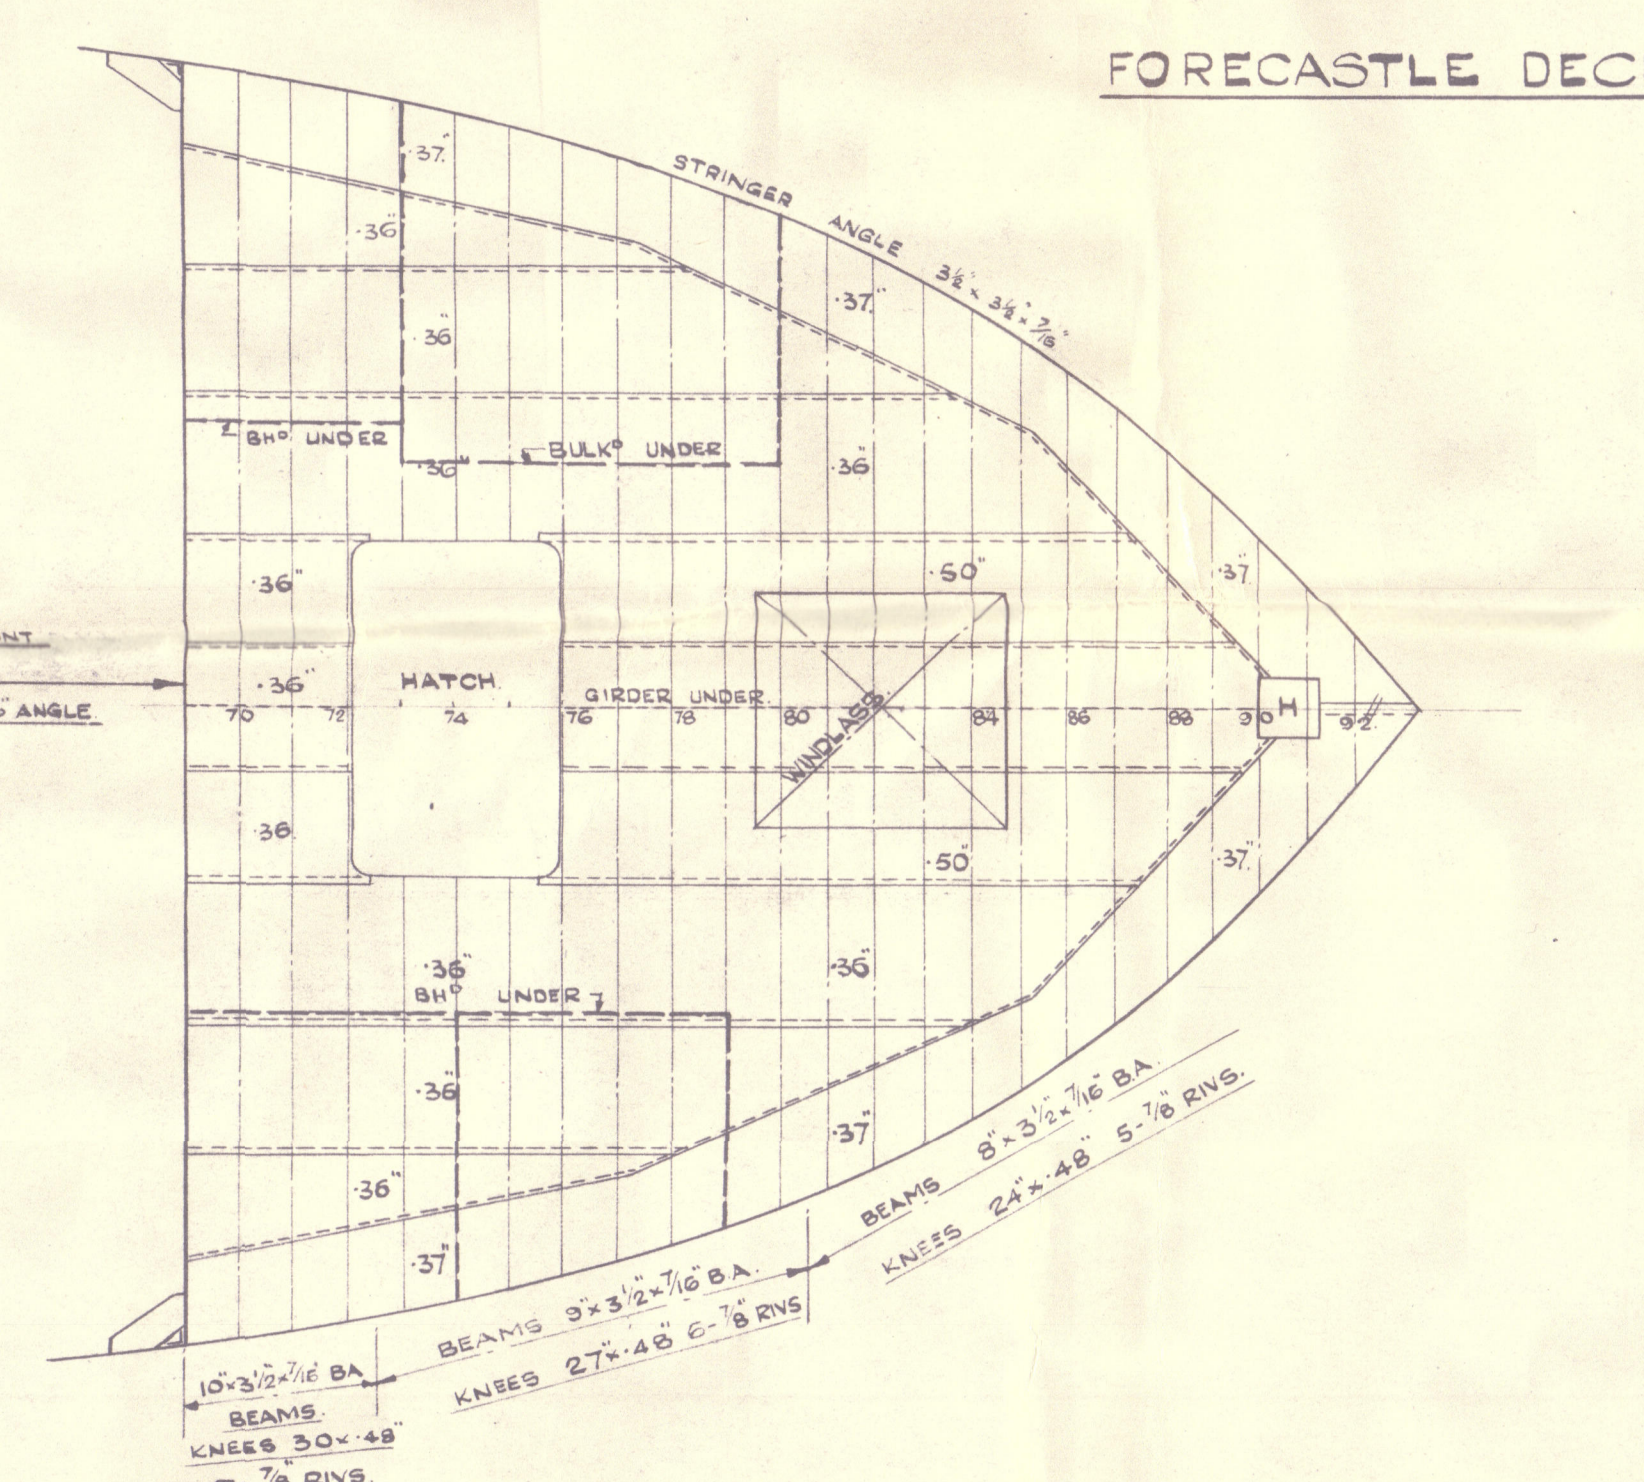

See also plan Jupper deck
app. 90-8-40

9

HARLAND & WOLFF LTD.
BELFAST

No. 1090

TITLE Steel Decks

DATE APPROVED 6. 8. 40

Belfast Report No 13411

San Veronica

See modified upper deck plan

app. 30.8.40



© 2021

Lloyd's Register
Foundation

9610-616300-146609