
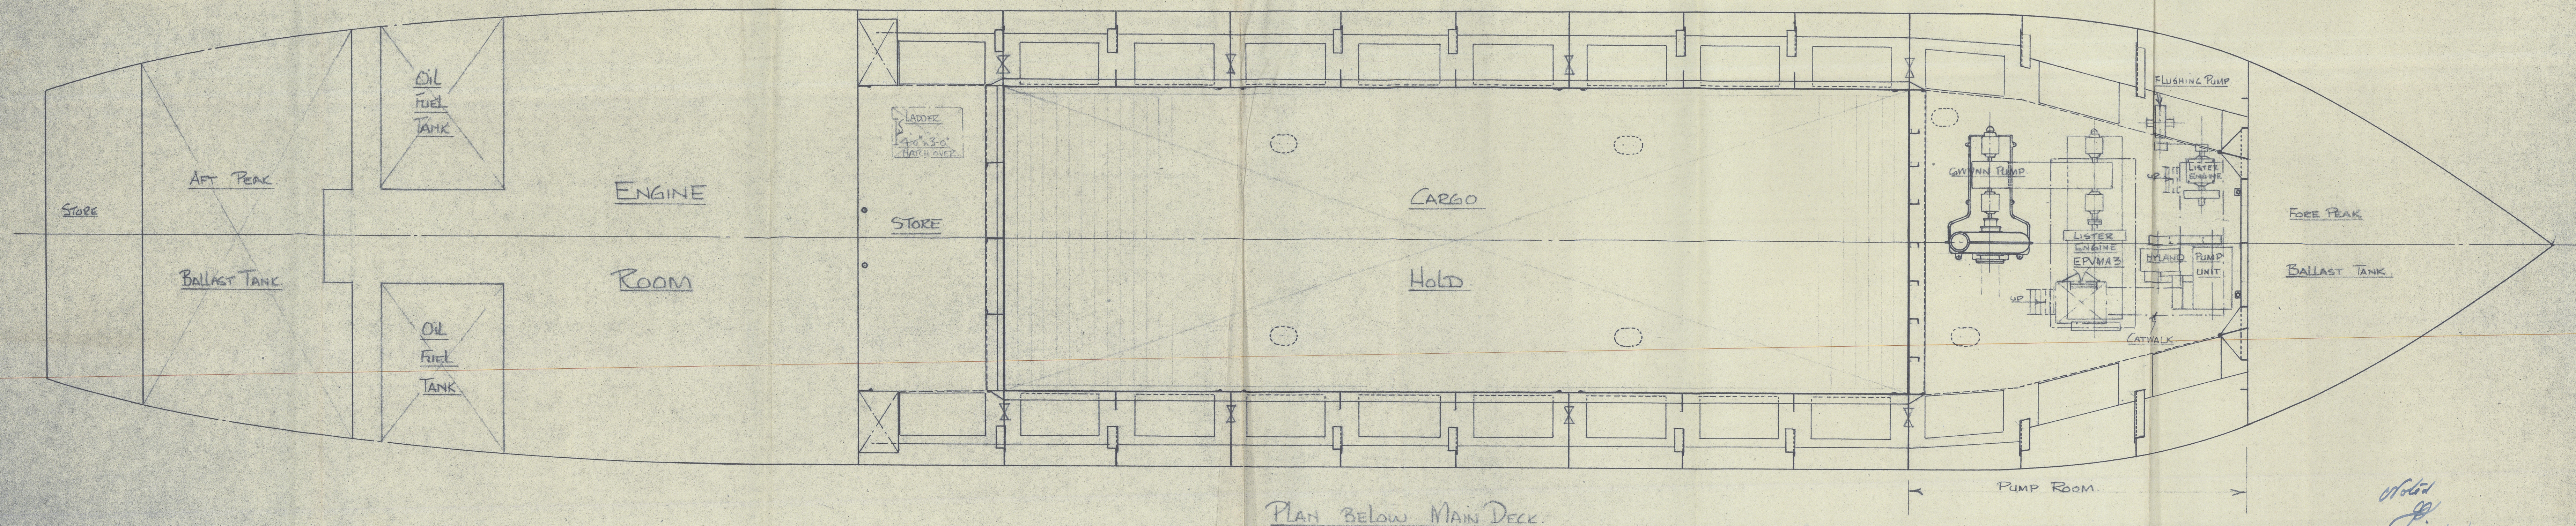


# M.V. "SAND DIVER"

## GENERAL ARRANGEMENT. [SHEET 2]

SCALE: 1/4 INCH = 1 FOOT.

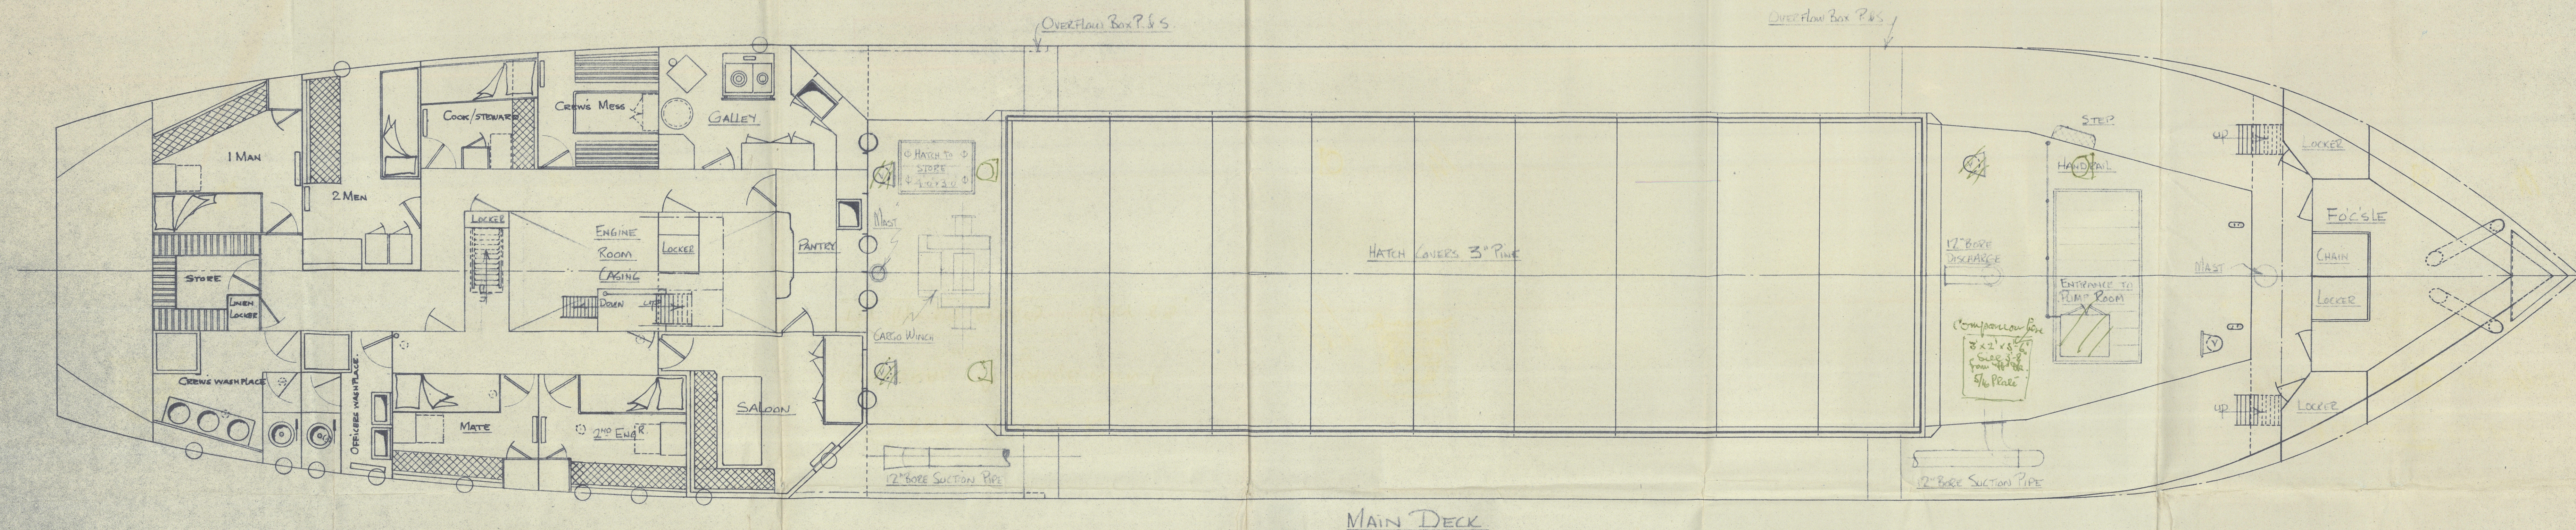

20/5/53



# SAND DIVER

## GENERAL ARRANGEMENT SHEET 2

PLY RPT NO 8269 JULY 53,

TO ACCOMPANY.....	<i>ply</i>	REPORT NO. <i>8269</i>
DATED.....	<i>7/53</i>	



© 2021

Lloyd's Register  
Foundation

003980-003984-0048