


SCALE $\frac{1}{2}$ " = 1 FOOT.

LLOYDS NUMERALS
1st LONGITUDINAL N^o 16100.
2nd " " - 45860.
3rd " " - 1310.

EQUIPMENT		
465	(64 + 35.5)	46267
POOP	121 - 75 - 75	684
BRIDGE	44.5 - 7.5 - 75	250
FORECASTLE	66.5 - 7.5 - 75	374
HOUSES	217 - 7.5 - 50	814
EQUIPMENT NO.		48389


2. BOWER ANCHORS 8 1/4 CWTs. EACH STOCKLESS
1. STREAM ANCHOR 25 1/2 " EX. STOCK.
240. FATHOMS 2 8/16" STUD CHAIN CABLE.

120	"	4 3/4"	FLEXIBLE STEEL WIRE	6-24.
130	"	5 1/2"	"	" " 6-24.
2.	KANSERS	100 FATHOMS	2 3/4"	STEEL WIRE 6-12
2.	WARPS	100	"	2 3/4" " " 6-12.

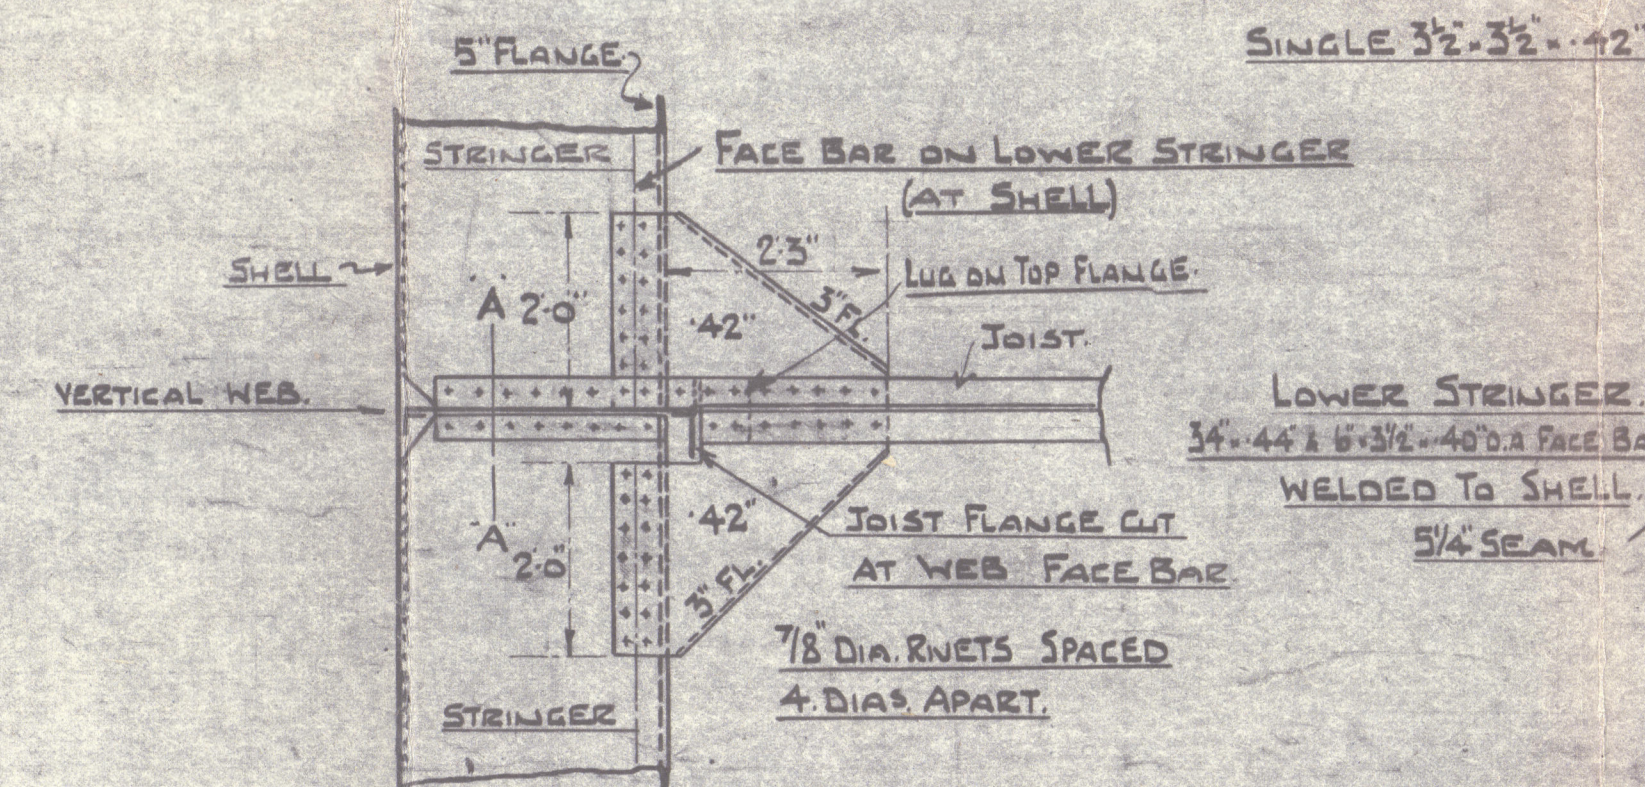


PLAN VIEW

CONNECTION OF SHELL & LONGITUDINAL BULK^o STRINGERS TO VERTICAL WEBS.

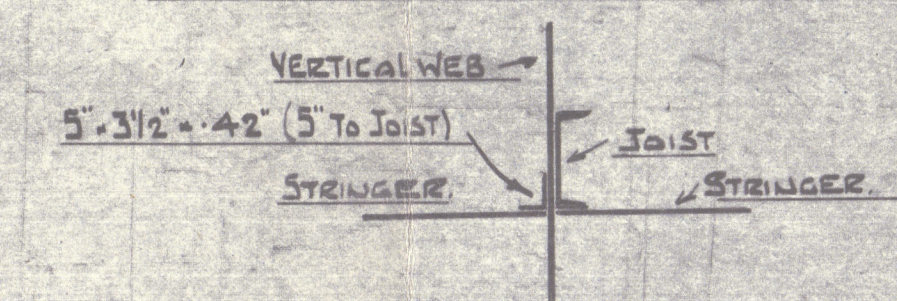

SECTION "A.A."

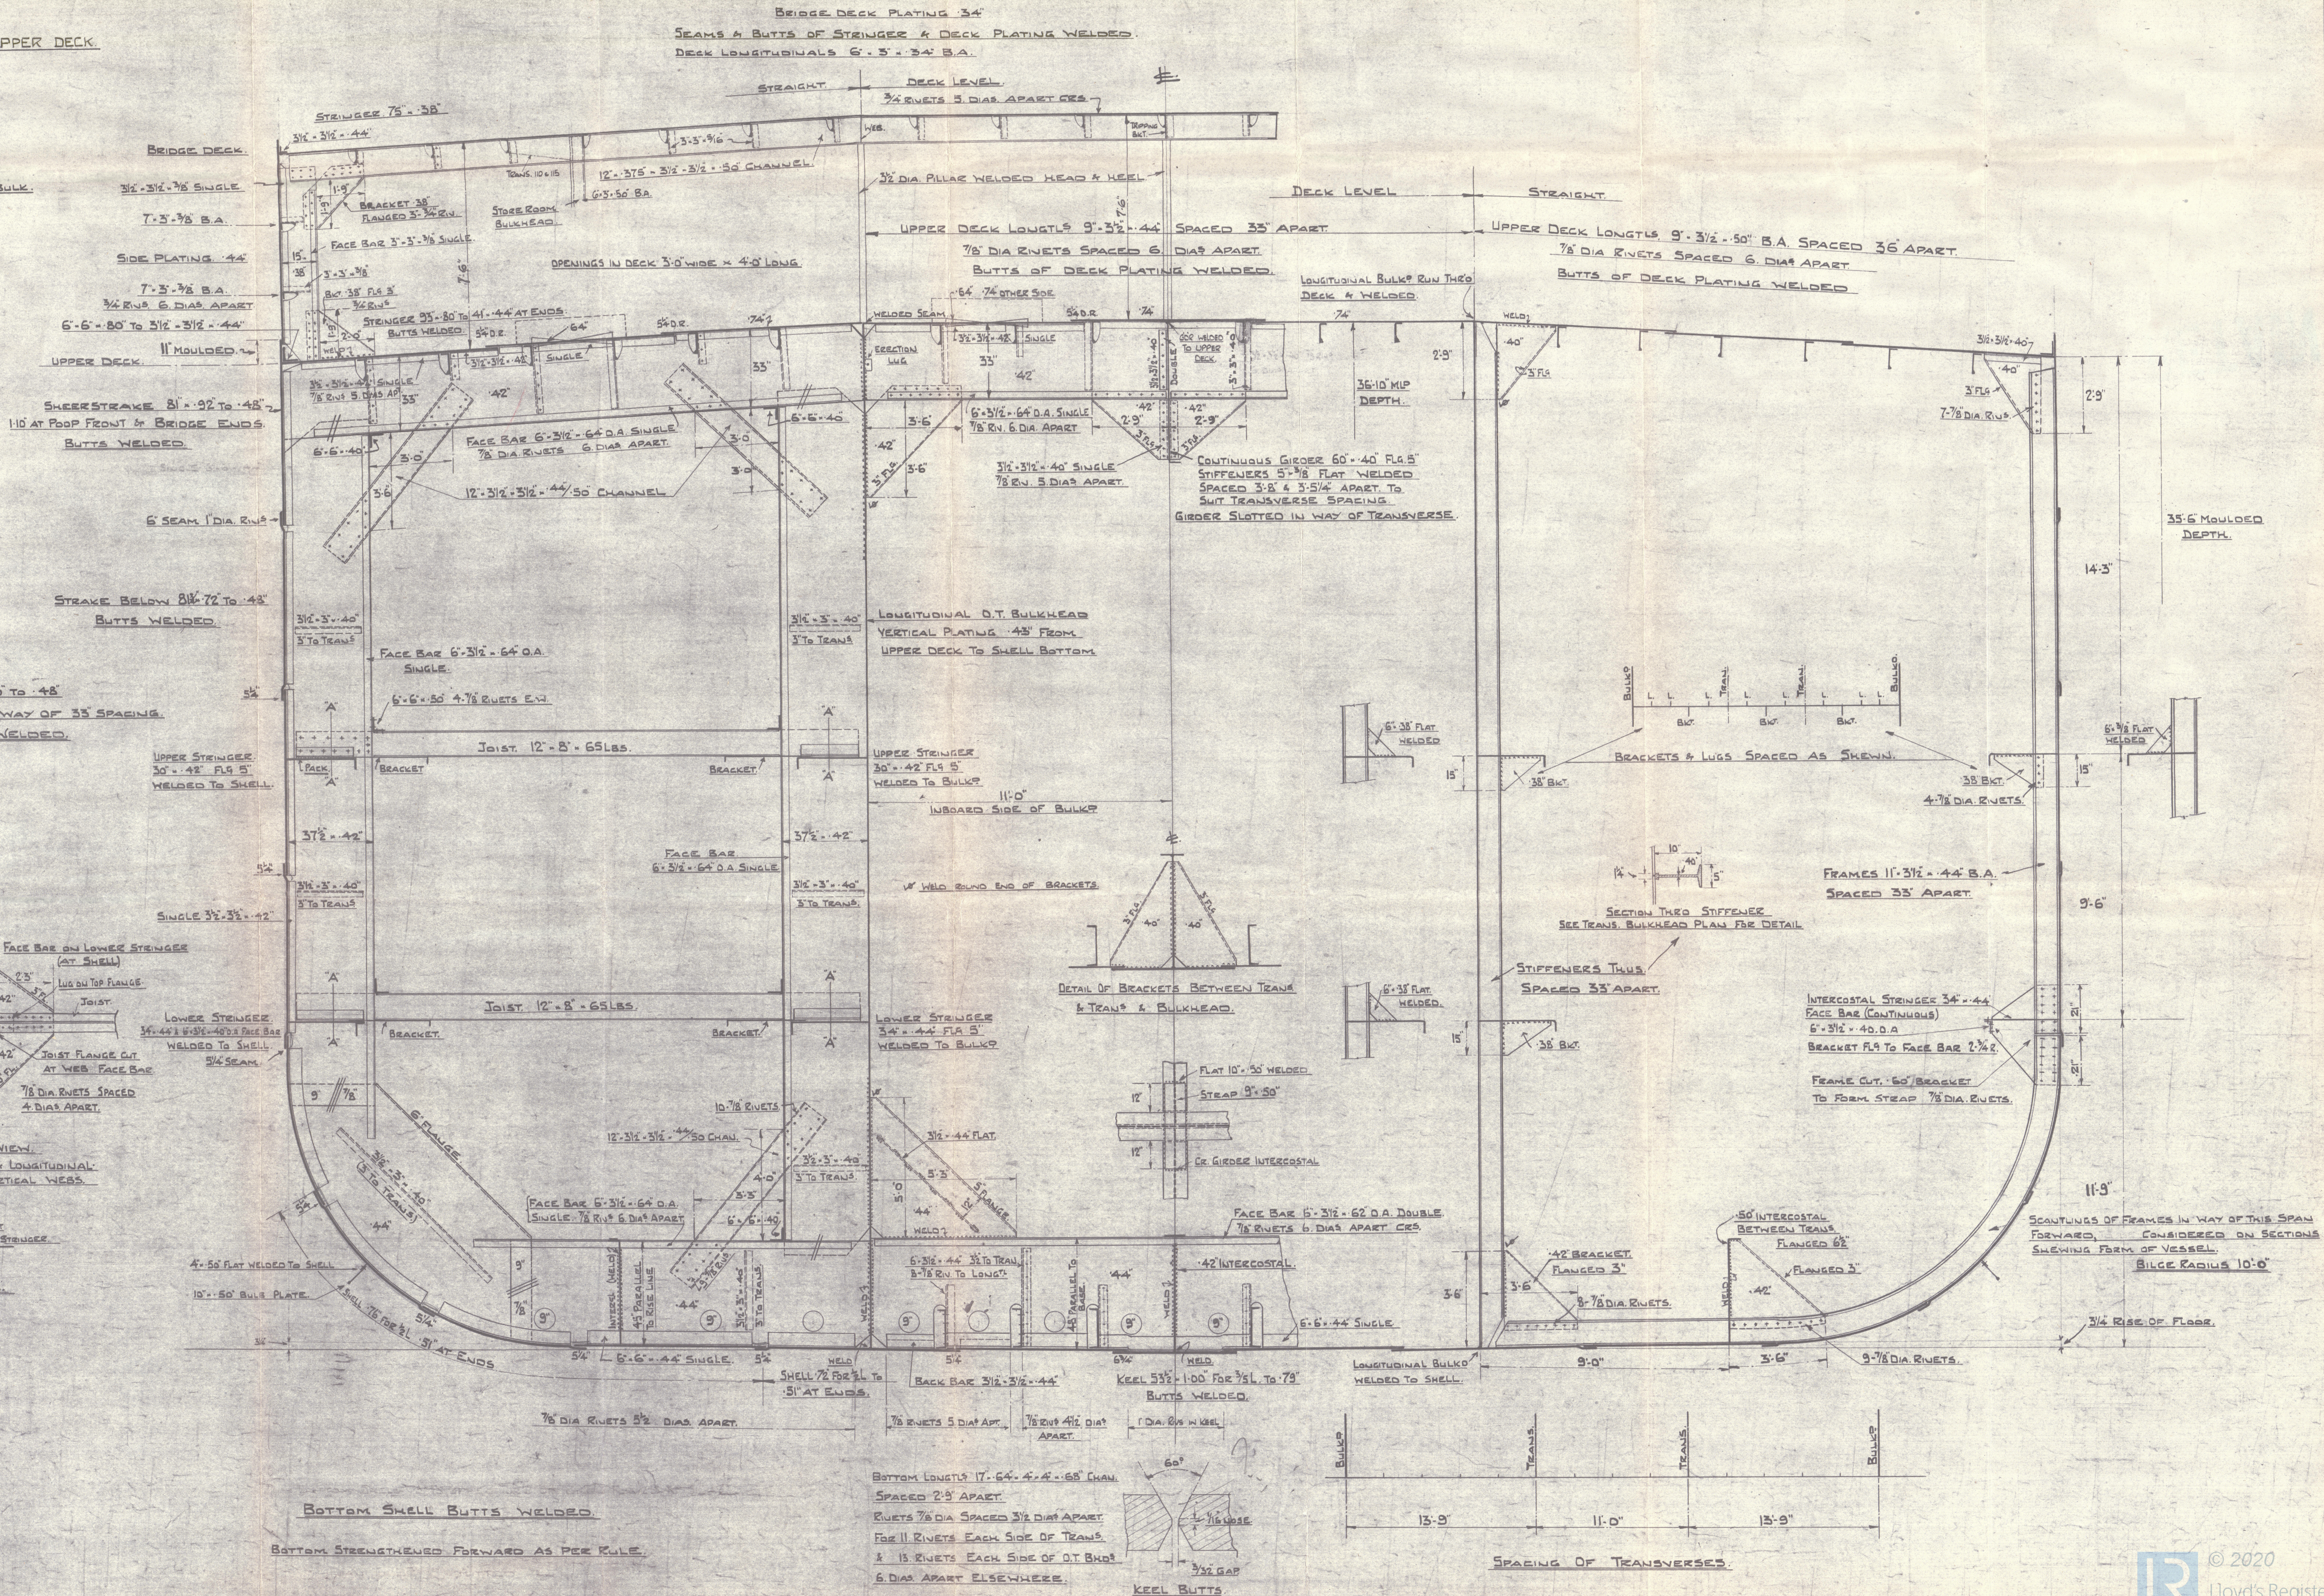

BOTTOM LONGTS 17'-6" 4'-4" 4'-6" CHAN.
SPACED 2'-9" APART.
RIVETS 7/8" DIA SPACED 3 1/2" DIA APART.
FOR 11 RIVETS EACH SIDE OF TRANS.
& 13 RIVETS EACH SIDE OF D.T. BHD.
6" DIA. APART ELSEWHERE.

KEEL BUTTS

SPACING OF TRANSVERSES

FURNESS. S. B. C. LTD No 363.
"WAVE REGENT." ✓

MIDSHIP SECTION AS BUILT.

S.S. "Wave Regent"
MDB. RPT. No 17867.



RETAIN



© 2020

Lloyd's Register
Foundation

003985-003993-0070