

— S.S. Nos 300/301/311 — — PROFILE & DECK PLANS. —

DIMENSIONS 365'0" BP X 51'3" MD X 28'6" TO UPPER DECK


SCALE 1/8" = 1 FOOT.

Converted to oil
fuel burning 8,600.
Karachi Rpt No 3164.

Depth of hatchway nets as per rule
or increased in depth 3' if no
brackets are fitted.

Hatchway coverings on upper deck
supported by Carroys' satisfaction.

18.5.14
4.6.14
2.9.14
23.9.14
21.2.16 (No. 311)

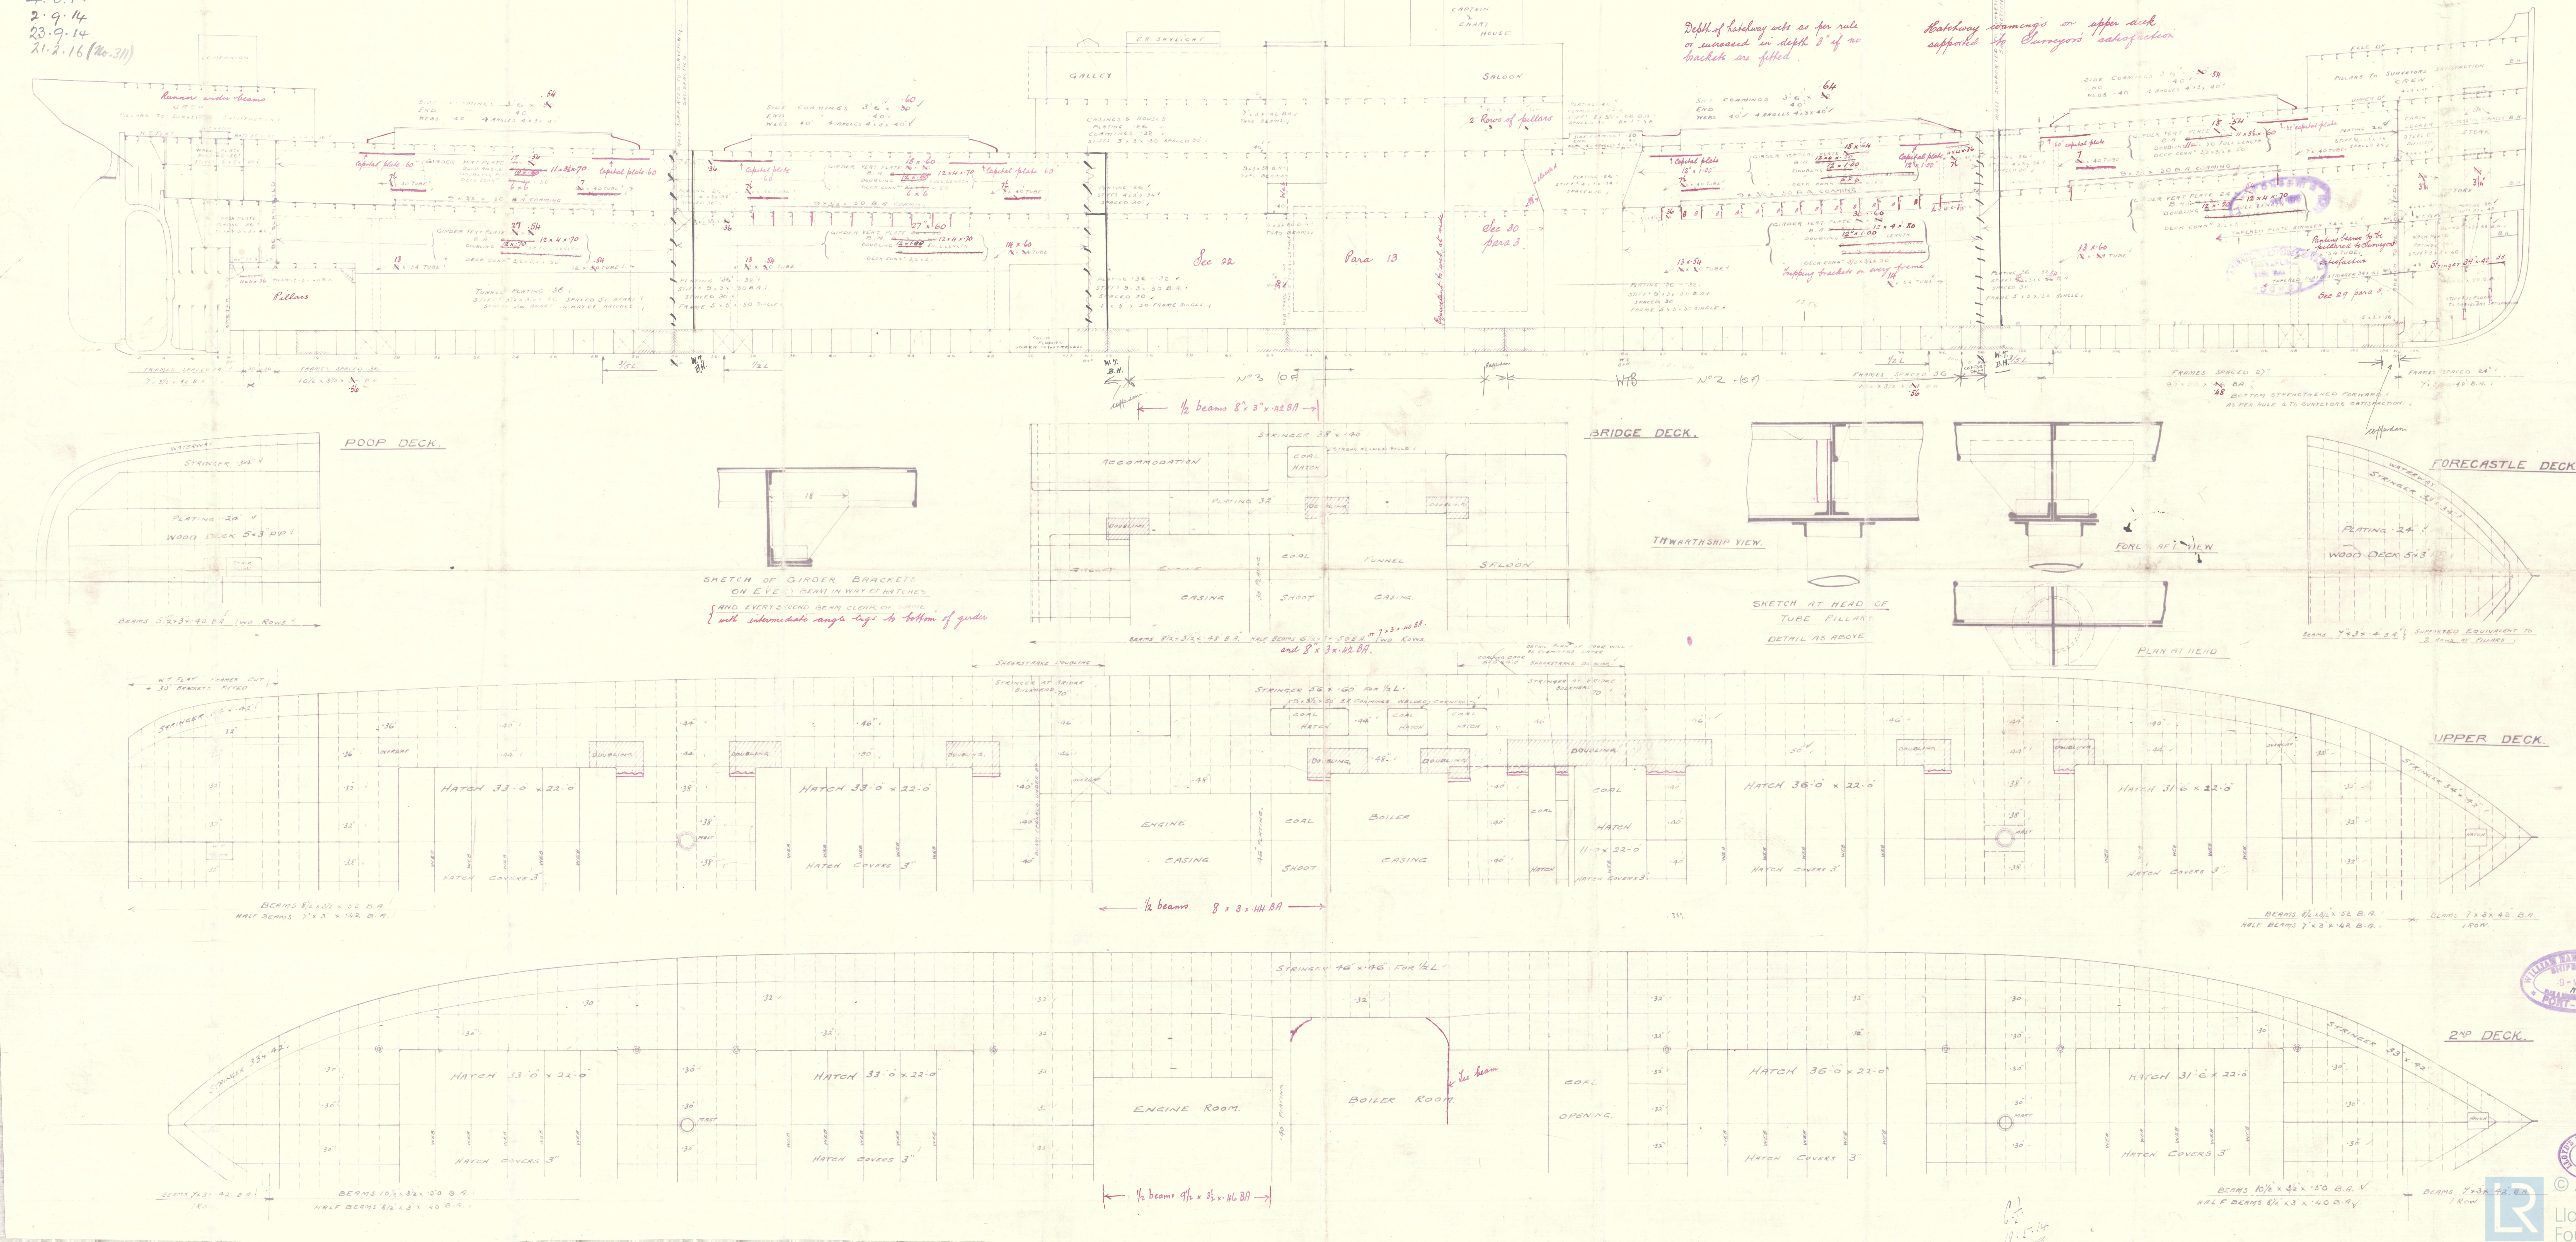


003985-003993-0089



© 2020

Lloyd's Register
Foundation

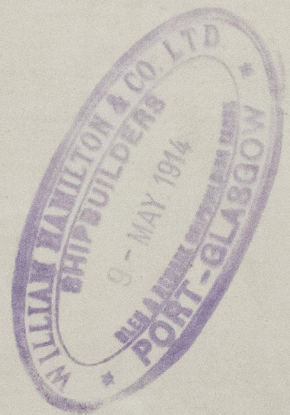

003985-003993-0089

Amended profile and deck plans
for





Messrs Wm Hamilton & Co

No 300 + 301 ~~Cancelled~~

S.S. "Chronos" ^{now "Cabarita"}

Gk Rpt No 16852


Maulabaksh

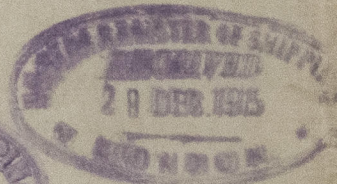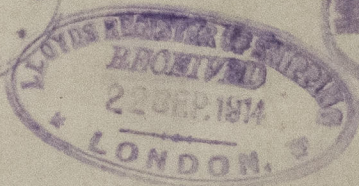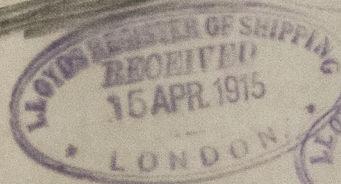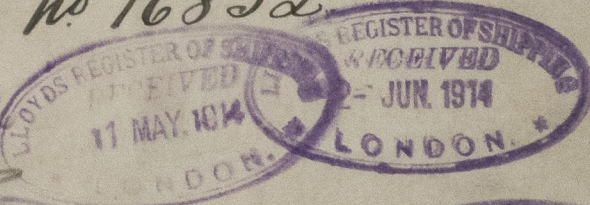

S.S. "Macedon"

Gk Rpt No 16988.

Maulabaksh

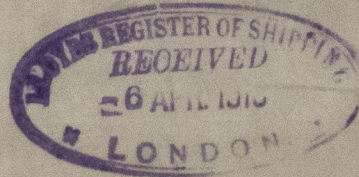

RETAIN

003985-003993-0089



© 2020

Lloyd's Register
Foundation