

EQUIPMENT NUMERAL.
 Lx (B+D) = 14168.35.
 FORECASTLE (22.29 x 6 x 75) = 100.3
 BRIDGE (15.75 x 7 x 75) = 82.7
 R.Q. DECK (151.375 x 4) = 605.5
 CASINGS ETC. = 126.2
 15084.05
 EQUIPMENT LETTER "P" = 1 1/8" CABLE.


BUANTISLAND SBC 10 SHIP NO 219. MIDSHIP SECTION.

SCALE 1/2" = ONE FOOT.

TO LLOYD'S SURVEY - CLASS 100 A.1. WITH FREEBOARD
 CORRESPONDING TO A MOULDED DRAFT OF 16'-6 1/2" (NEW LOAD LINE RULES)

DIMENSIONS.

LENGTH L.W.L. 245'-0".
 BREADTH MLD. 39'-4".
 DEPTH " U.D.K. 18'-6".
 " " R.Q.D.K. 22'-6".
 SHEERS 4'-2" FOR 1'-0" AFT.
 BLOCK COEFF. .75.

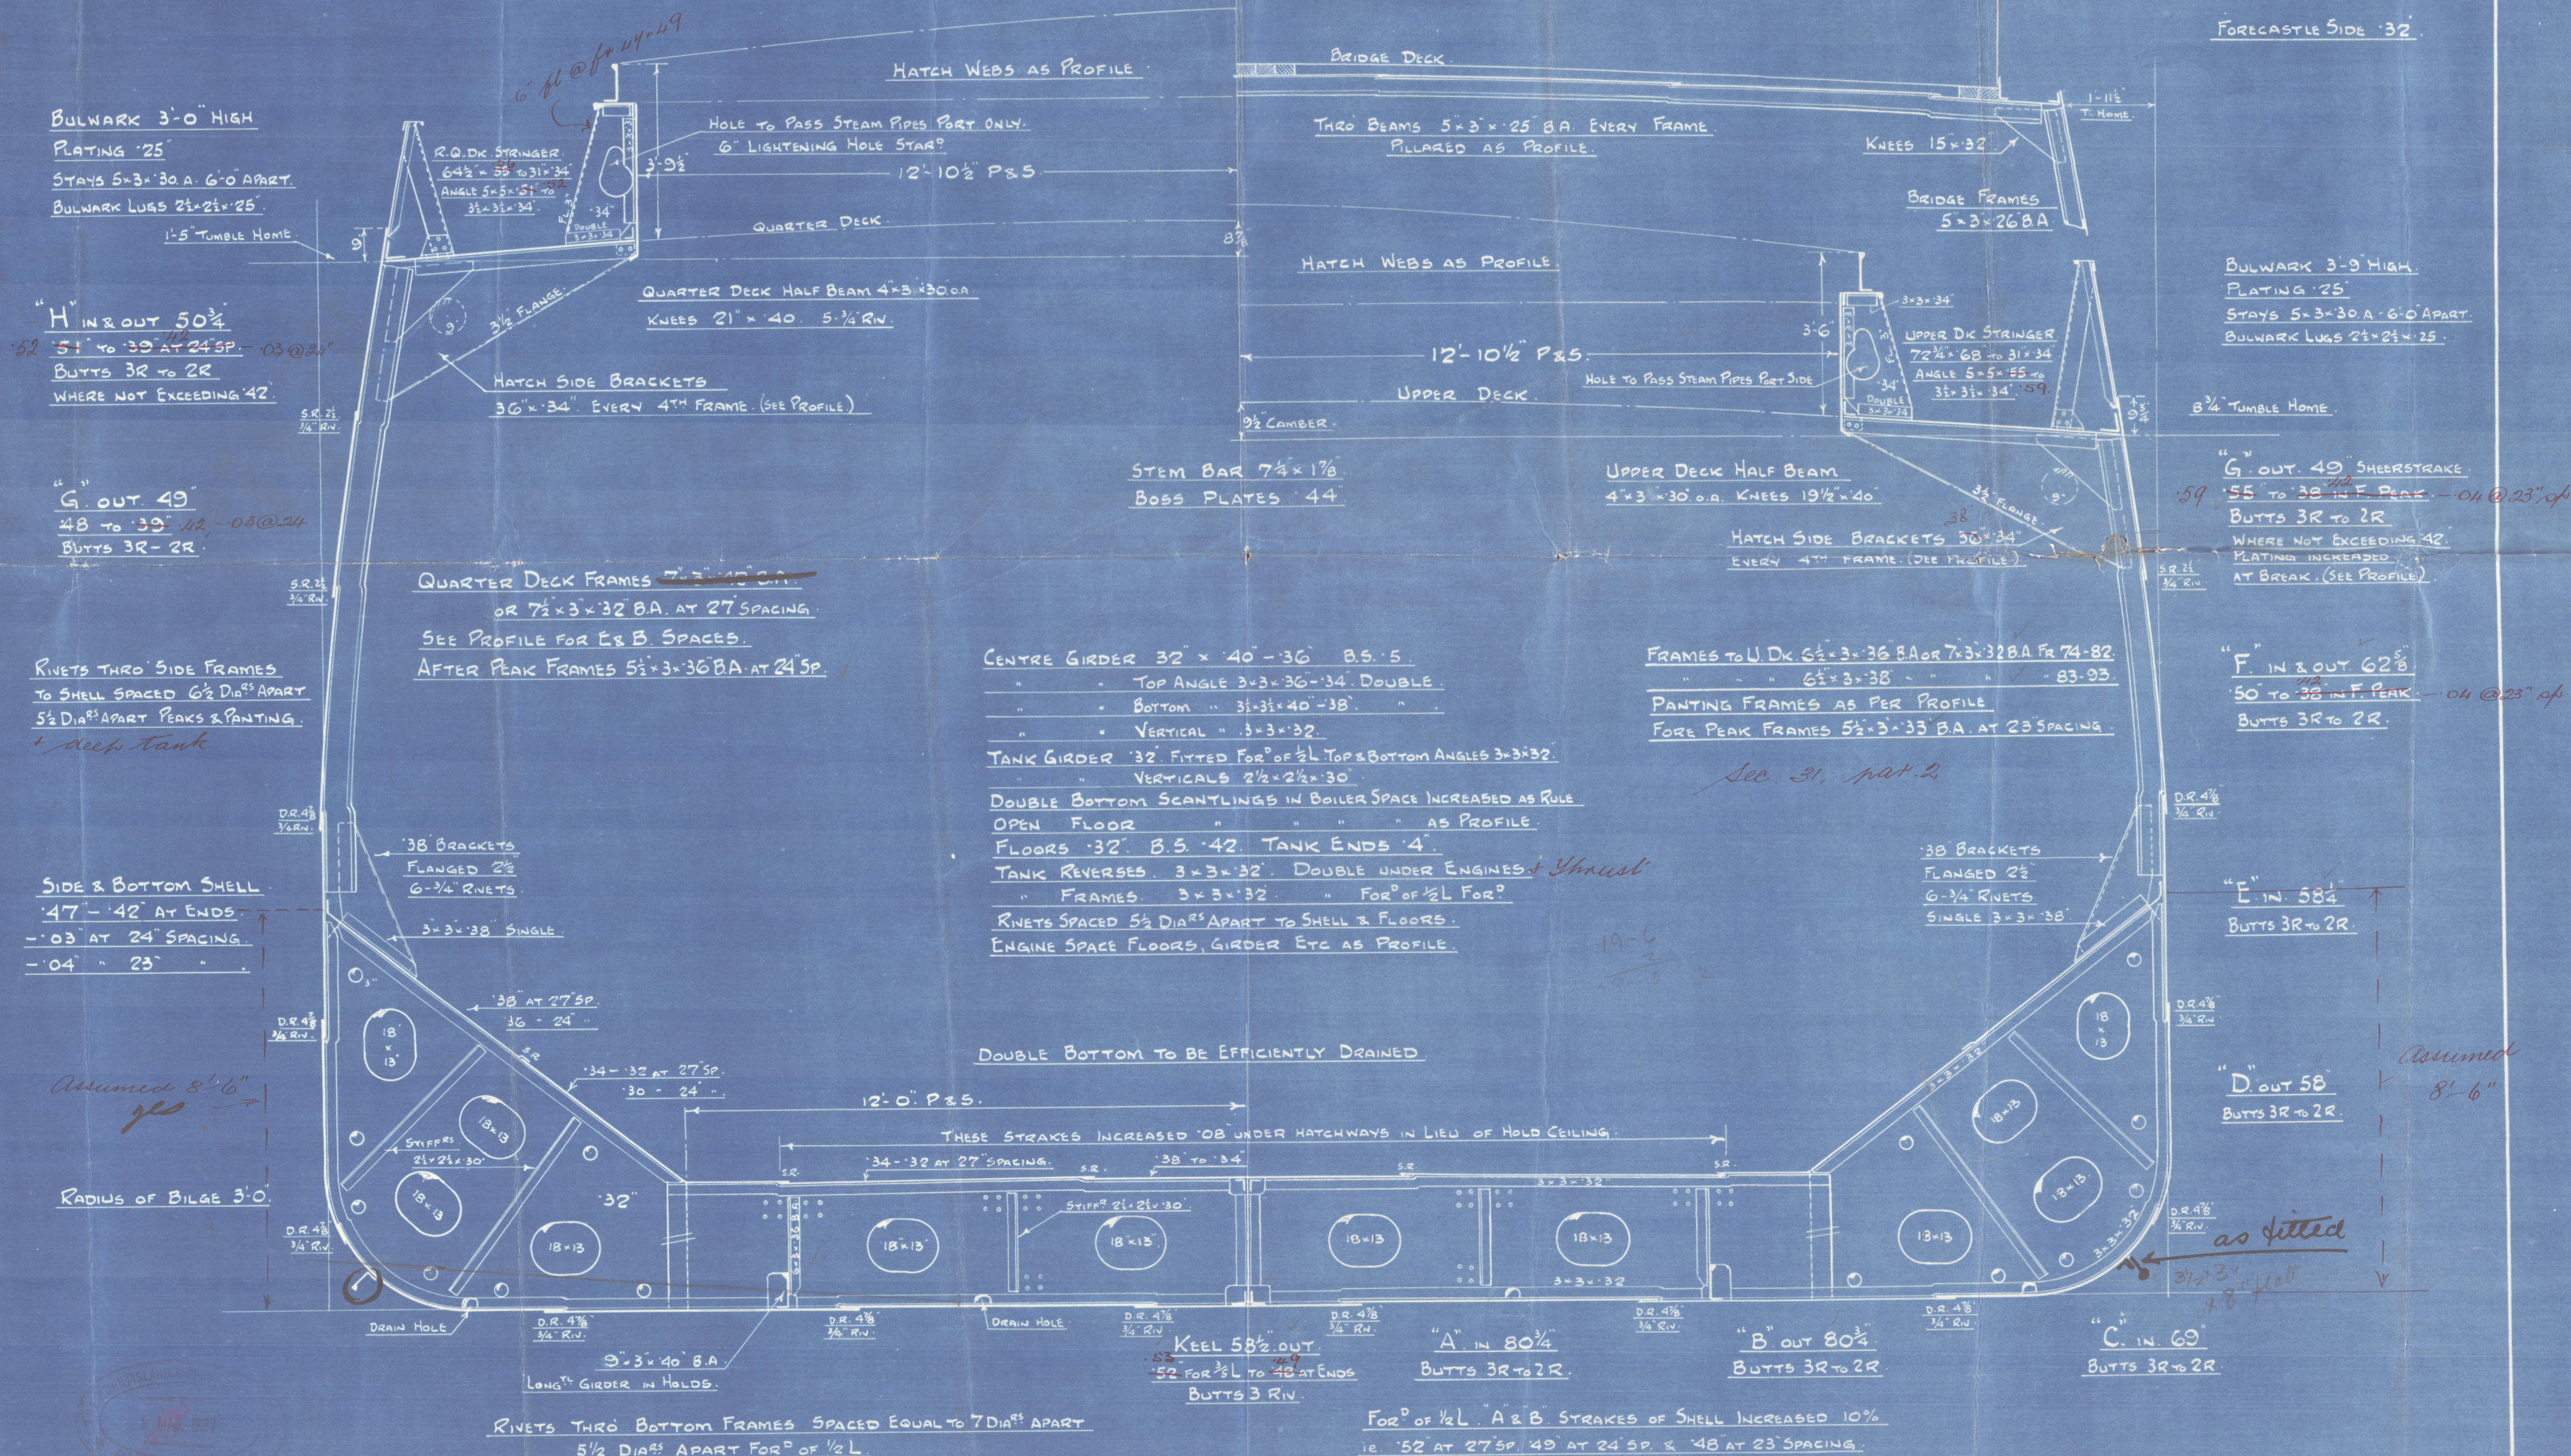

PLAN N° P. I.

9

18
133
151



© 2020

Lloyd's Register
Foundation

BURNTISLAND SBC²
N^o 219

MIDSHIP SECTION

S/S WIMBLEDON.
Leith Rpt N^o 19488

RETAIN



© 2020

Lloyd's Register
Foundation

055994-004002-0227