



1 Floor to be made airtight  
to form gutterway.

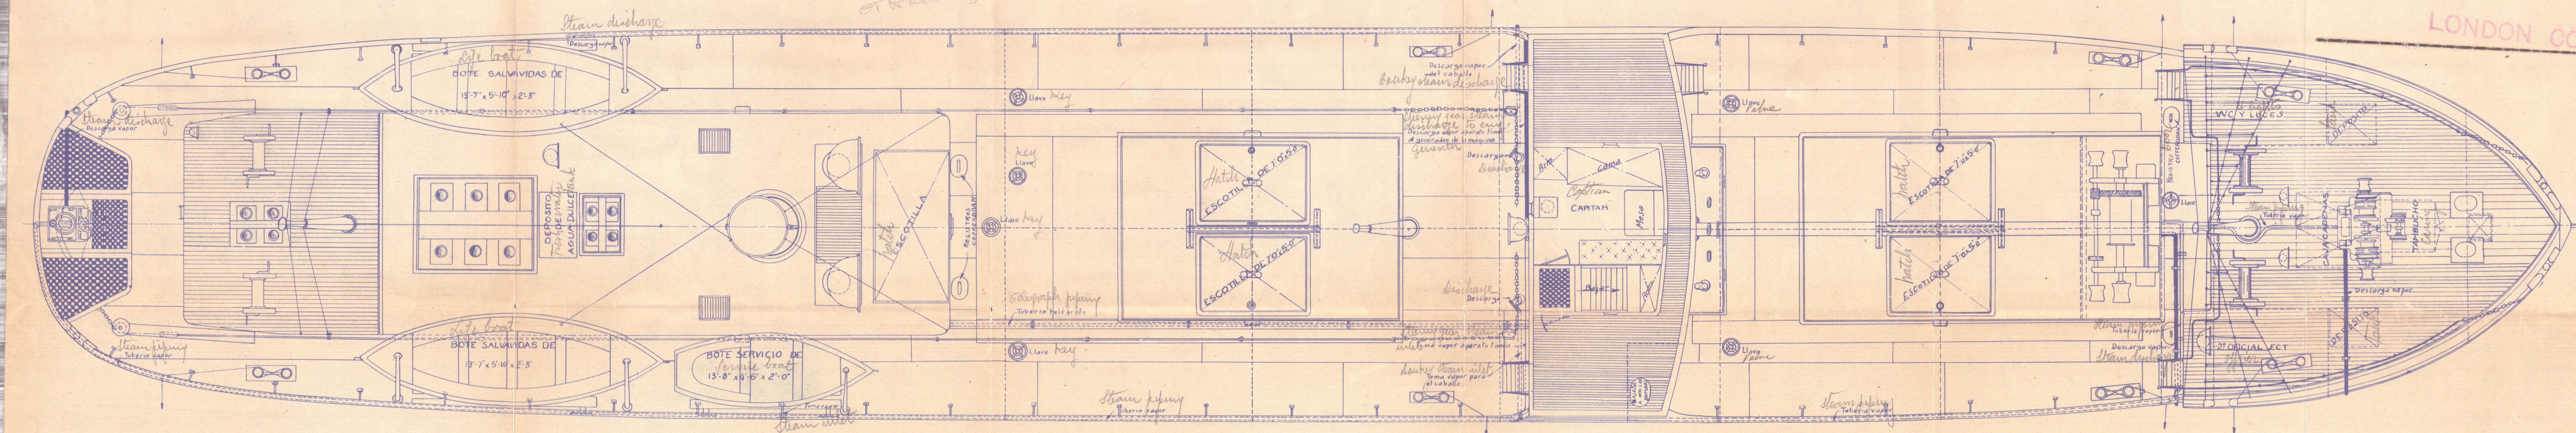

LLOYD'S REGISTER OF SHIP  
*Noted*  
LONDON

8/4/48.

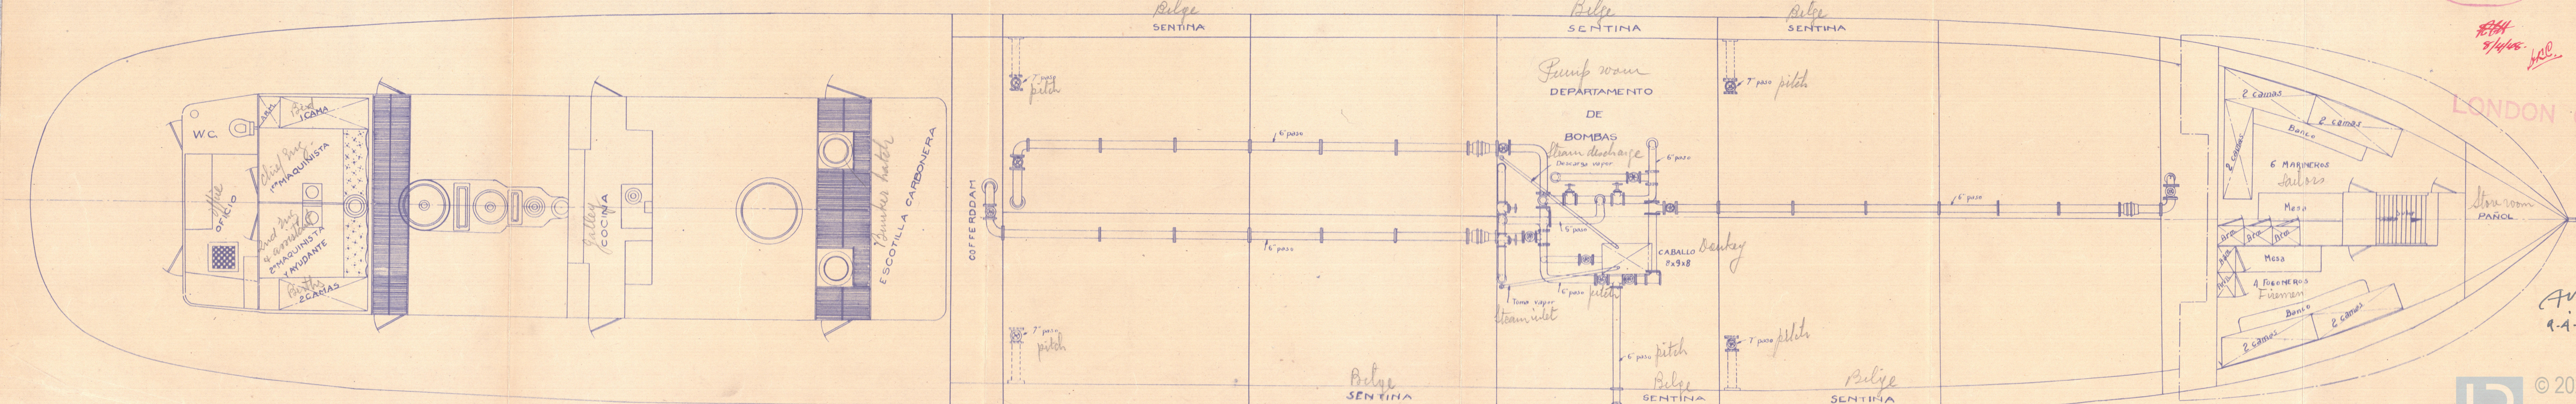

9-4-4