


Scale $\frac{3}{4}" = 1 \text{ foot}$

STERNPOST & RUDDER FRAME TO BE OF BEST FORGED SCRAP IRON
TO PASS LLOYDS REQUIREMENTS.

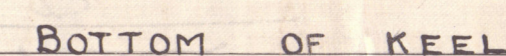

Stern frame
& Rudder.
Yadix
442. Cadiz

~~25 N. T. J. 1870~~
PLANS TRANSFERRED
TO SISTER VESSEL

OPHIR