


LONGITUDINAL SECTION
Nº1 STEEL SCREW STEAMER

M.M. ECHEVARRIETA Y LARRINAGA
ASTILLEROS DE CADIZ

CADIZ
Scale $\frac{1}{4}$ " = 1 foot


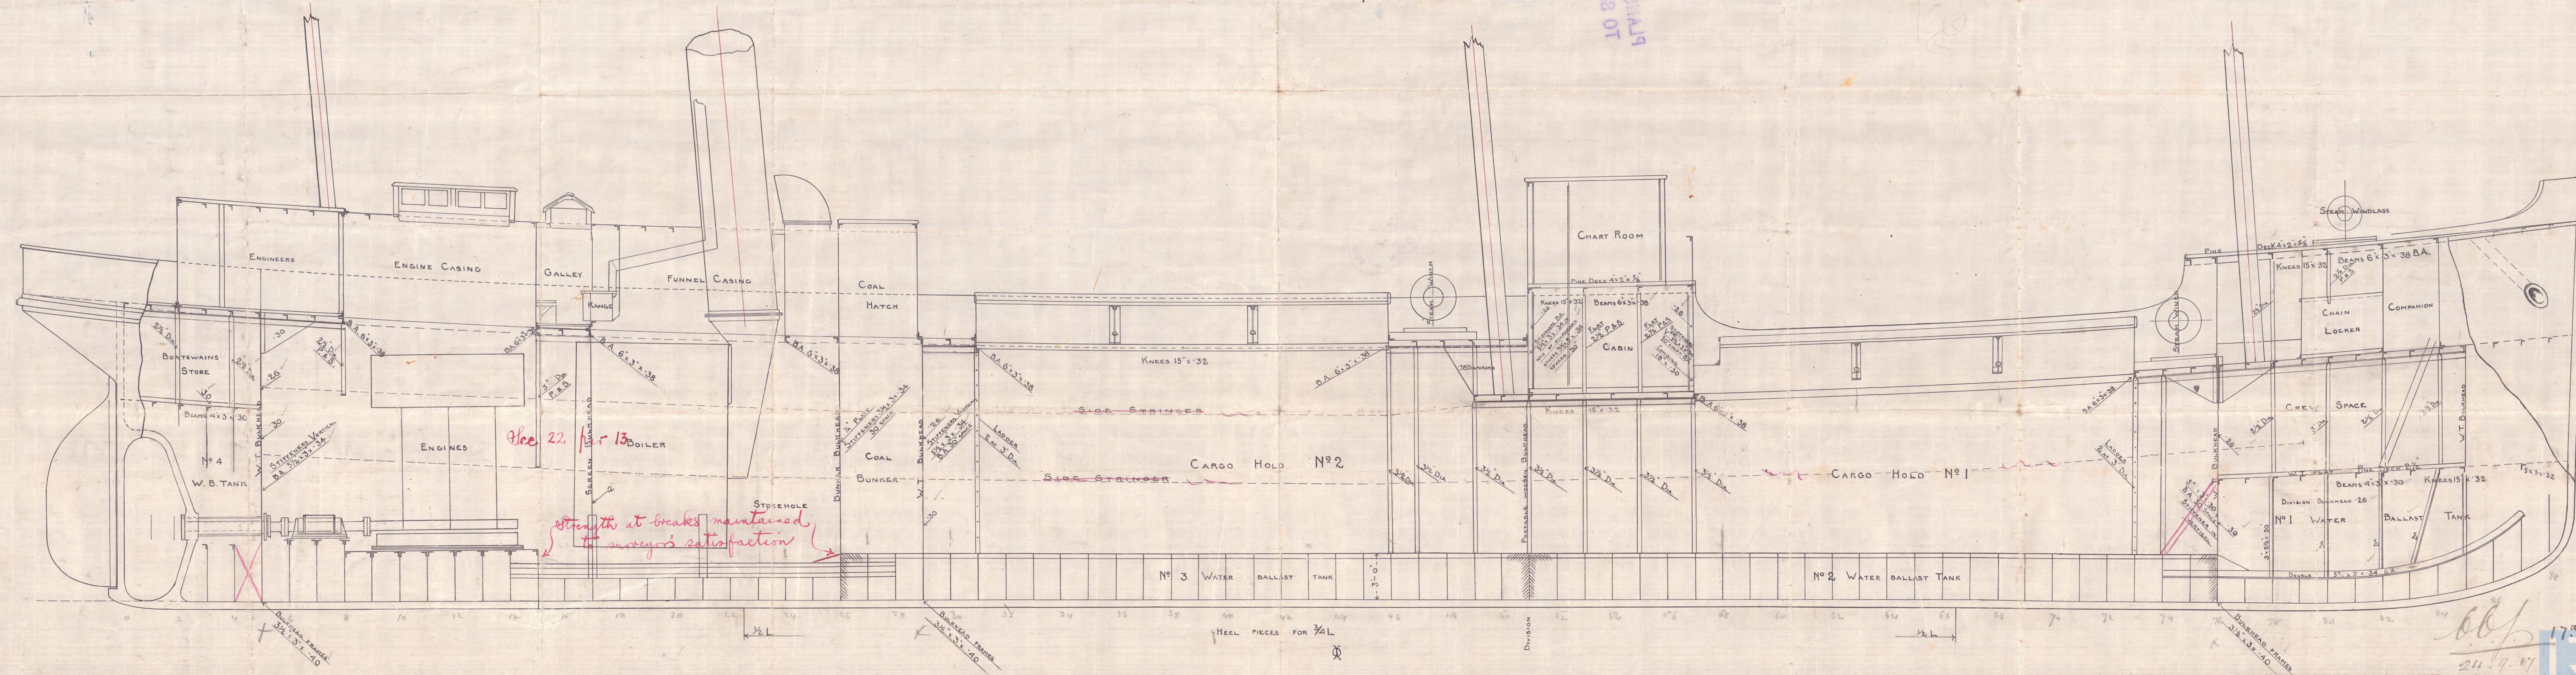

See 22 for 13
Strength at breaks maintained
to surveyor's satisfaction

San Juan II

Profile ~~W S~~ ~~ow~~

Gadir
772 Cadiz

PLANS TRANSFERRED
TO SISTER VESSEL

OPHIR

DE
CADIZ
STEAMER
SECTION

© 2021

Lloyd's Register
Foundation

004003-004008-0127